

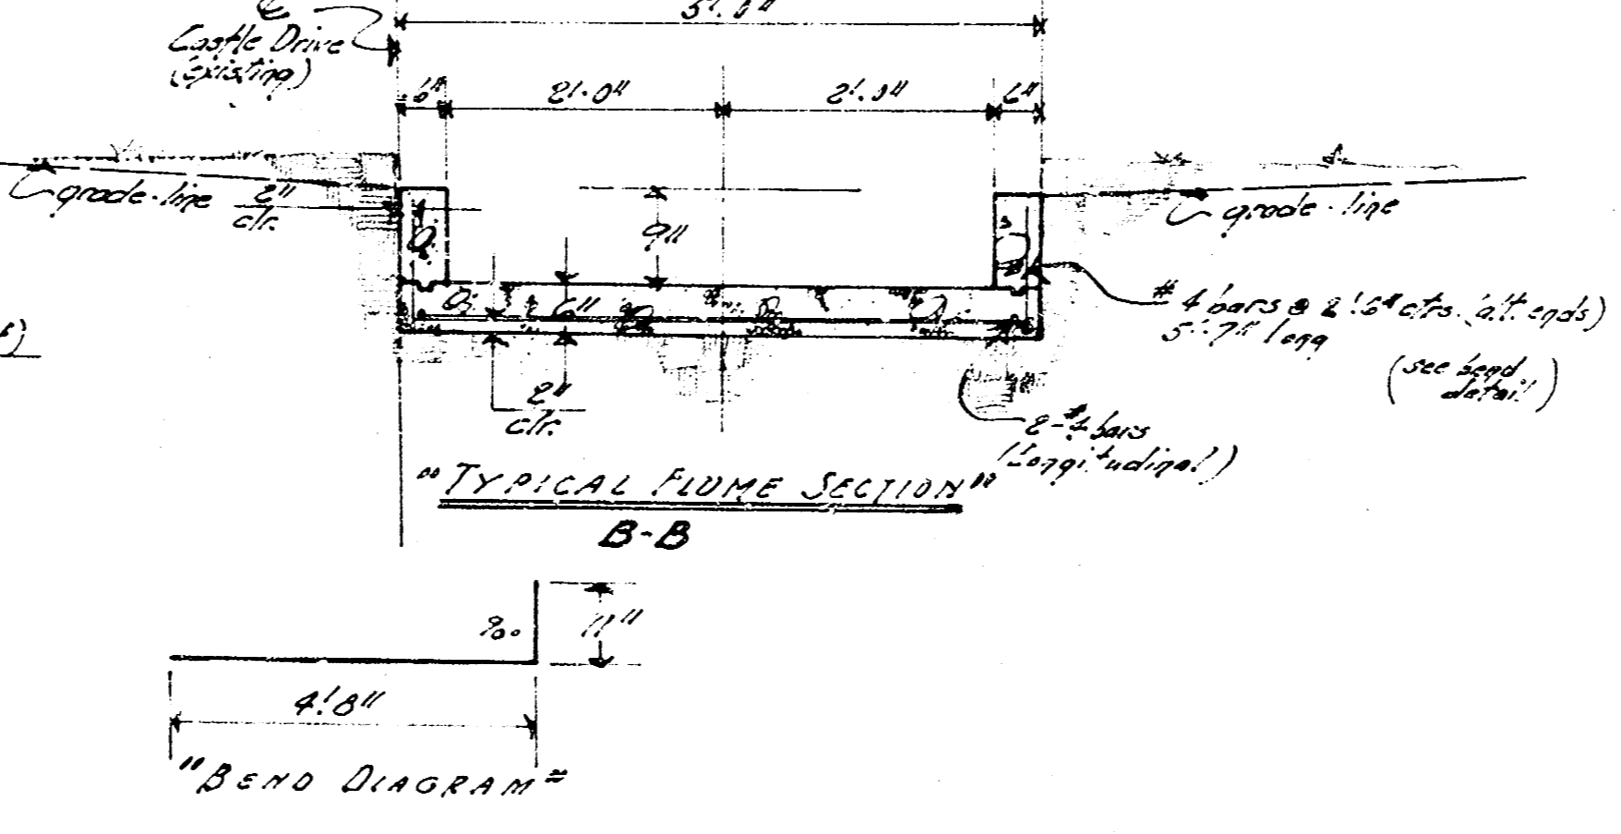



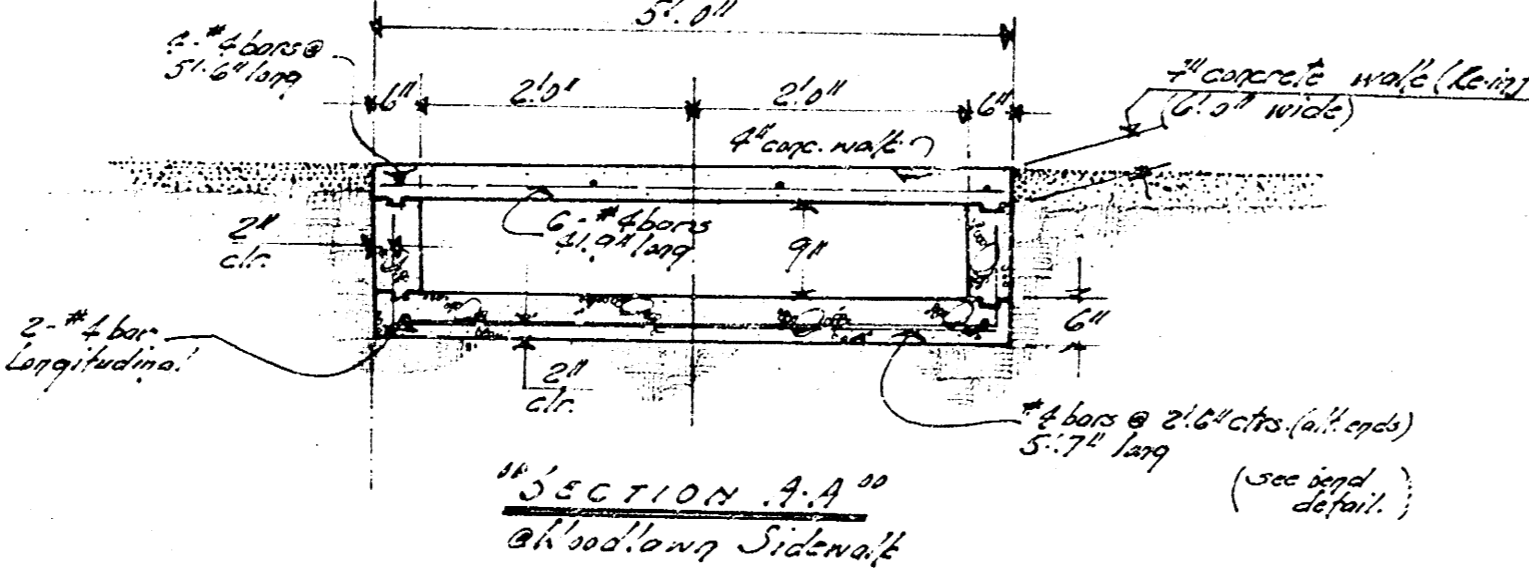

"BILL OF MATERIALS"		
Quan.	Unit	Item

 Between Castle Drive and Woodlawn Blvd
CITY OF WICHITA, KANSAS
 S.E. Smith City Engineer
 Date: 5/14/68 Private Engineer

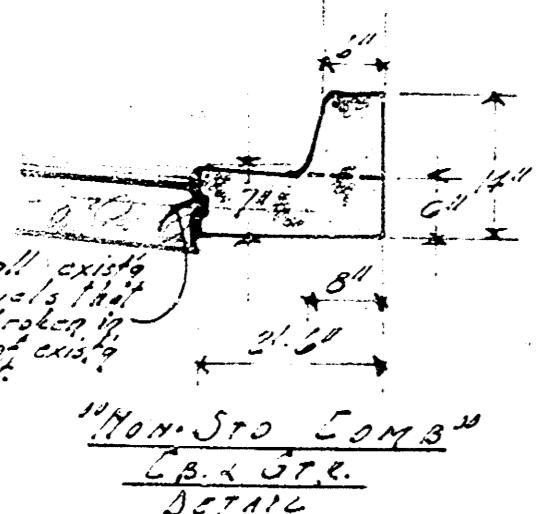


S.E. Smith
 City Engineer
 Date: 5/14/68





 5' So. Castle Drive
 base line = starting East of E. Castle Drive

NOTE TO CONTRACTOR
 This project will be constructed under
 the supervision of the CITY ENGINEER
 conforming to the SPECIFICATIONS
 of the CITY OF WICHITA. The CON-
 TRACTOR shall reimburse the City of
 Wichita for the cost of Engineering Plans,
 etc.

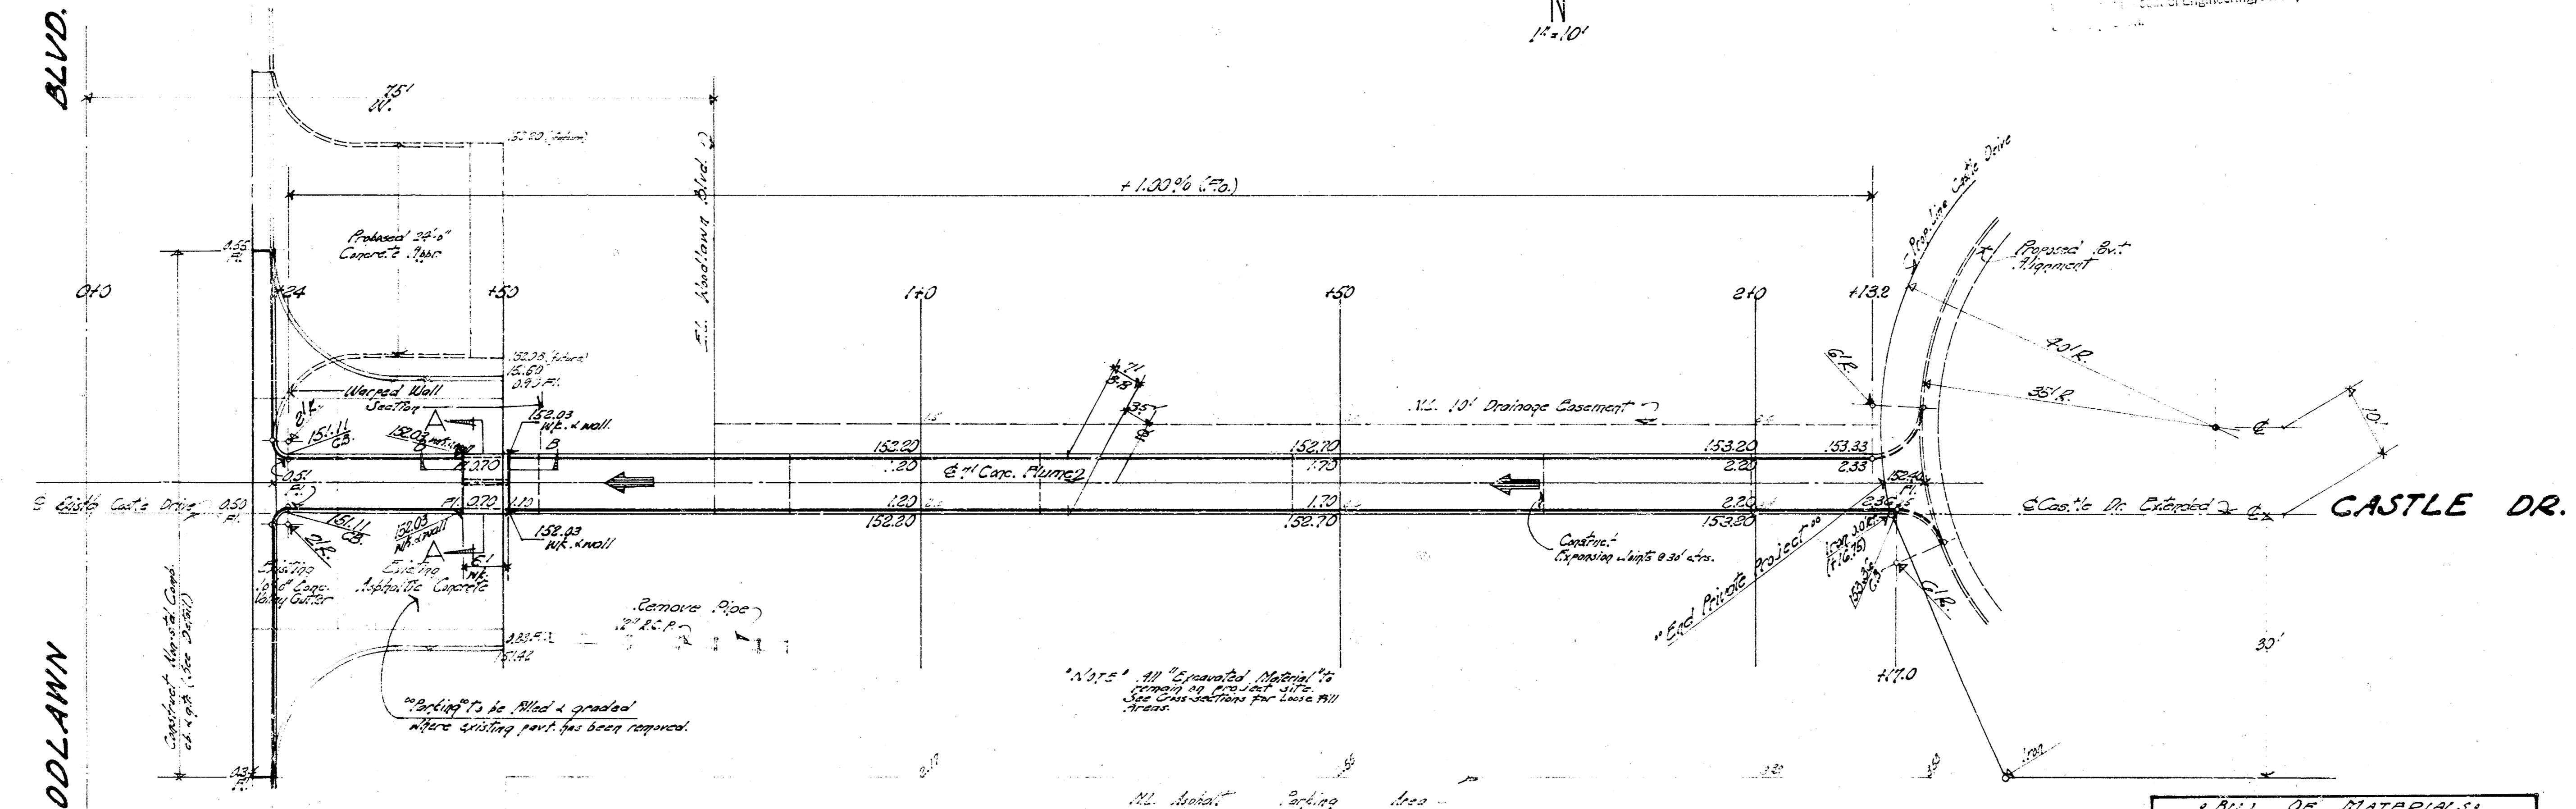

BILL OF MATERIALS



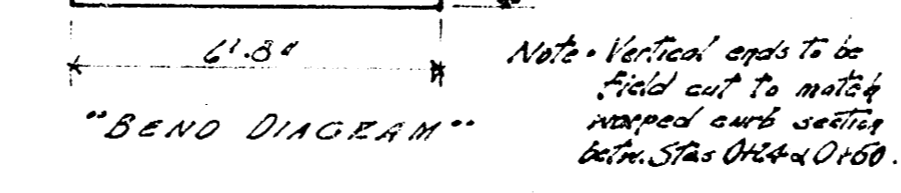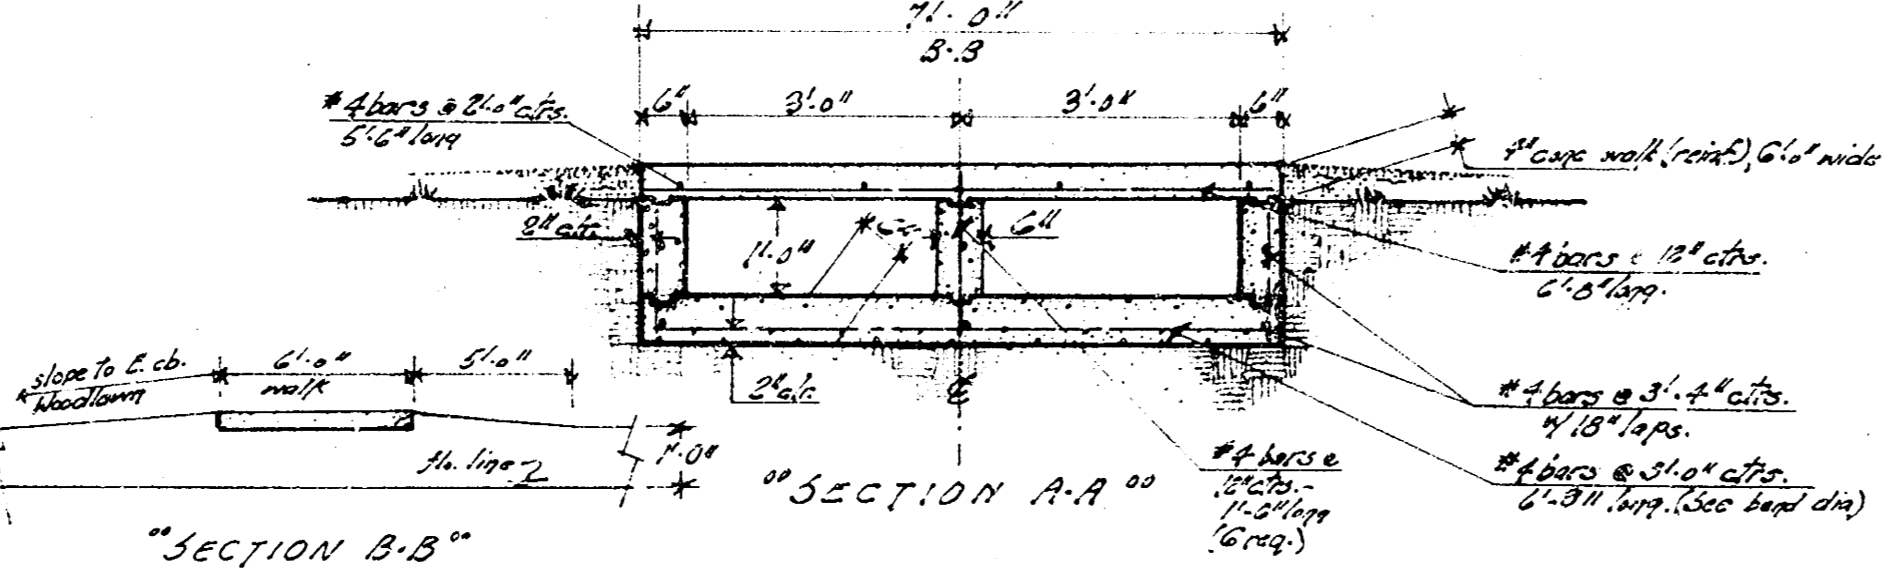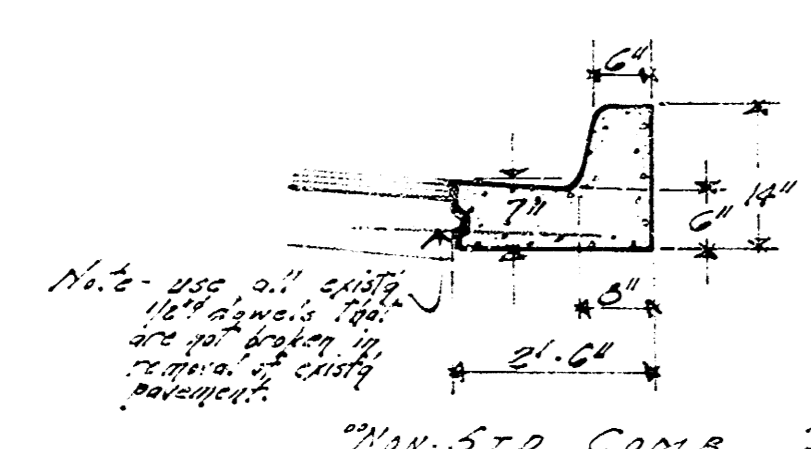

"7' REINF. CONG. FLUME"
 Between Castle Drive and Woodlawn Blvd.
 in Melvyn Addition.
CITY OF WICHITA, KANSAS
 S. E. Smith City Engineer




B.M. = 50.88 "Top of House North End of Drive, East Side Woodlawn Blvd.
 15' to Castle Drive.
 Base Line = Springing East of E. Castle Drive

NOTE TO CONTRACTOR
 This project will be constructed under the supervision of the CITY ENGINEER and conforming to the SPECIFICATIONS of the CITY OF WICHITA. The CONTRACTOR shall reimburse the City of Wichita for the cost of Engineering, Plans, and Printing.

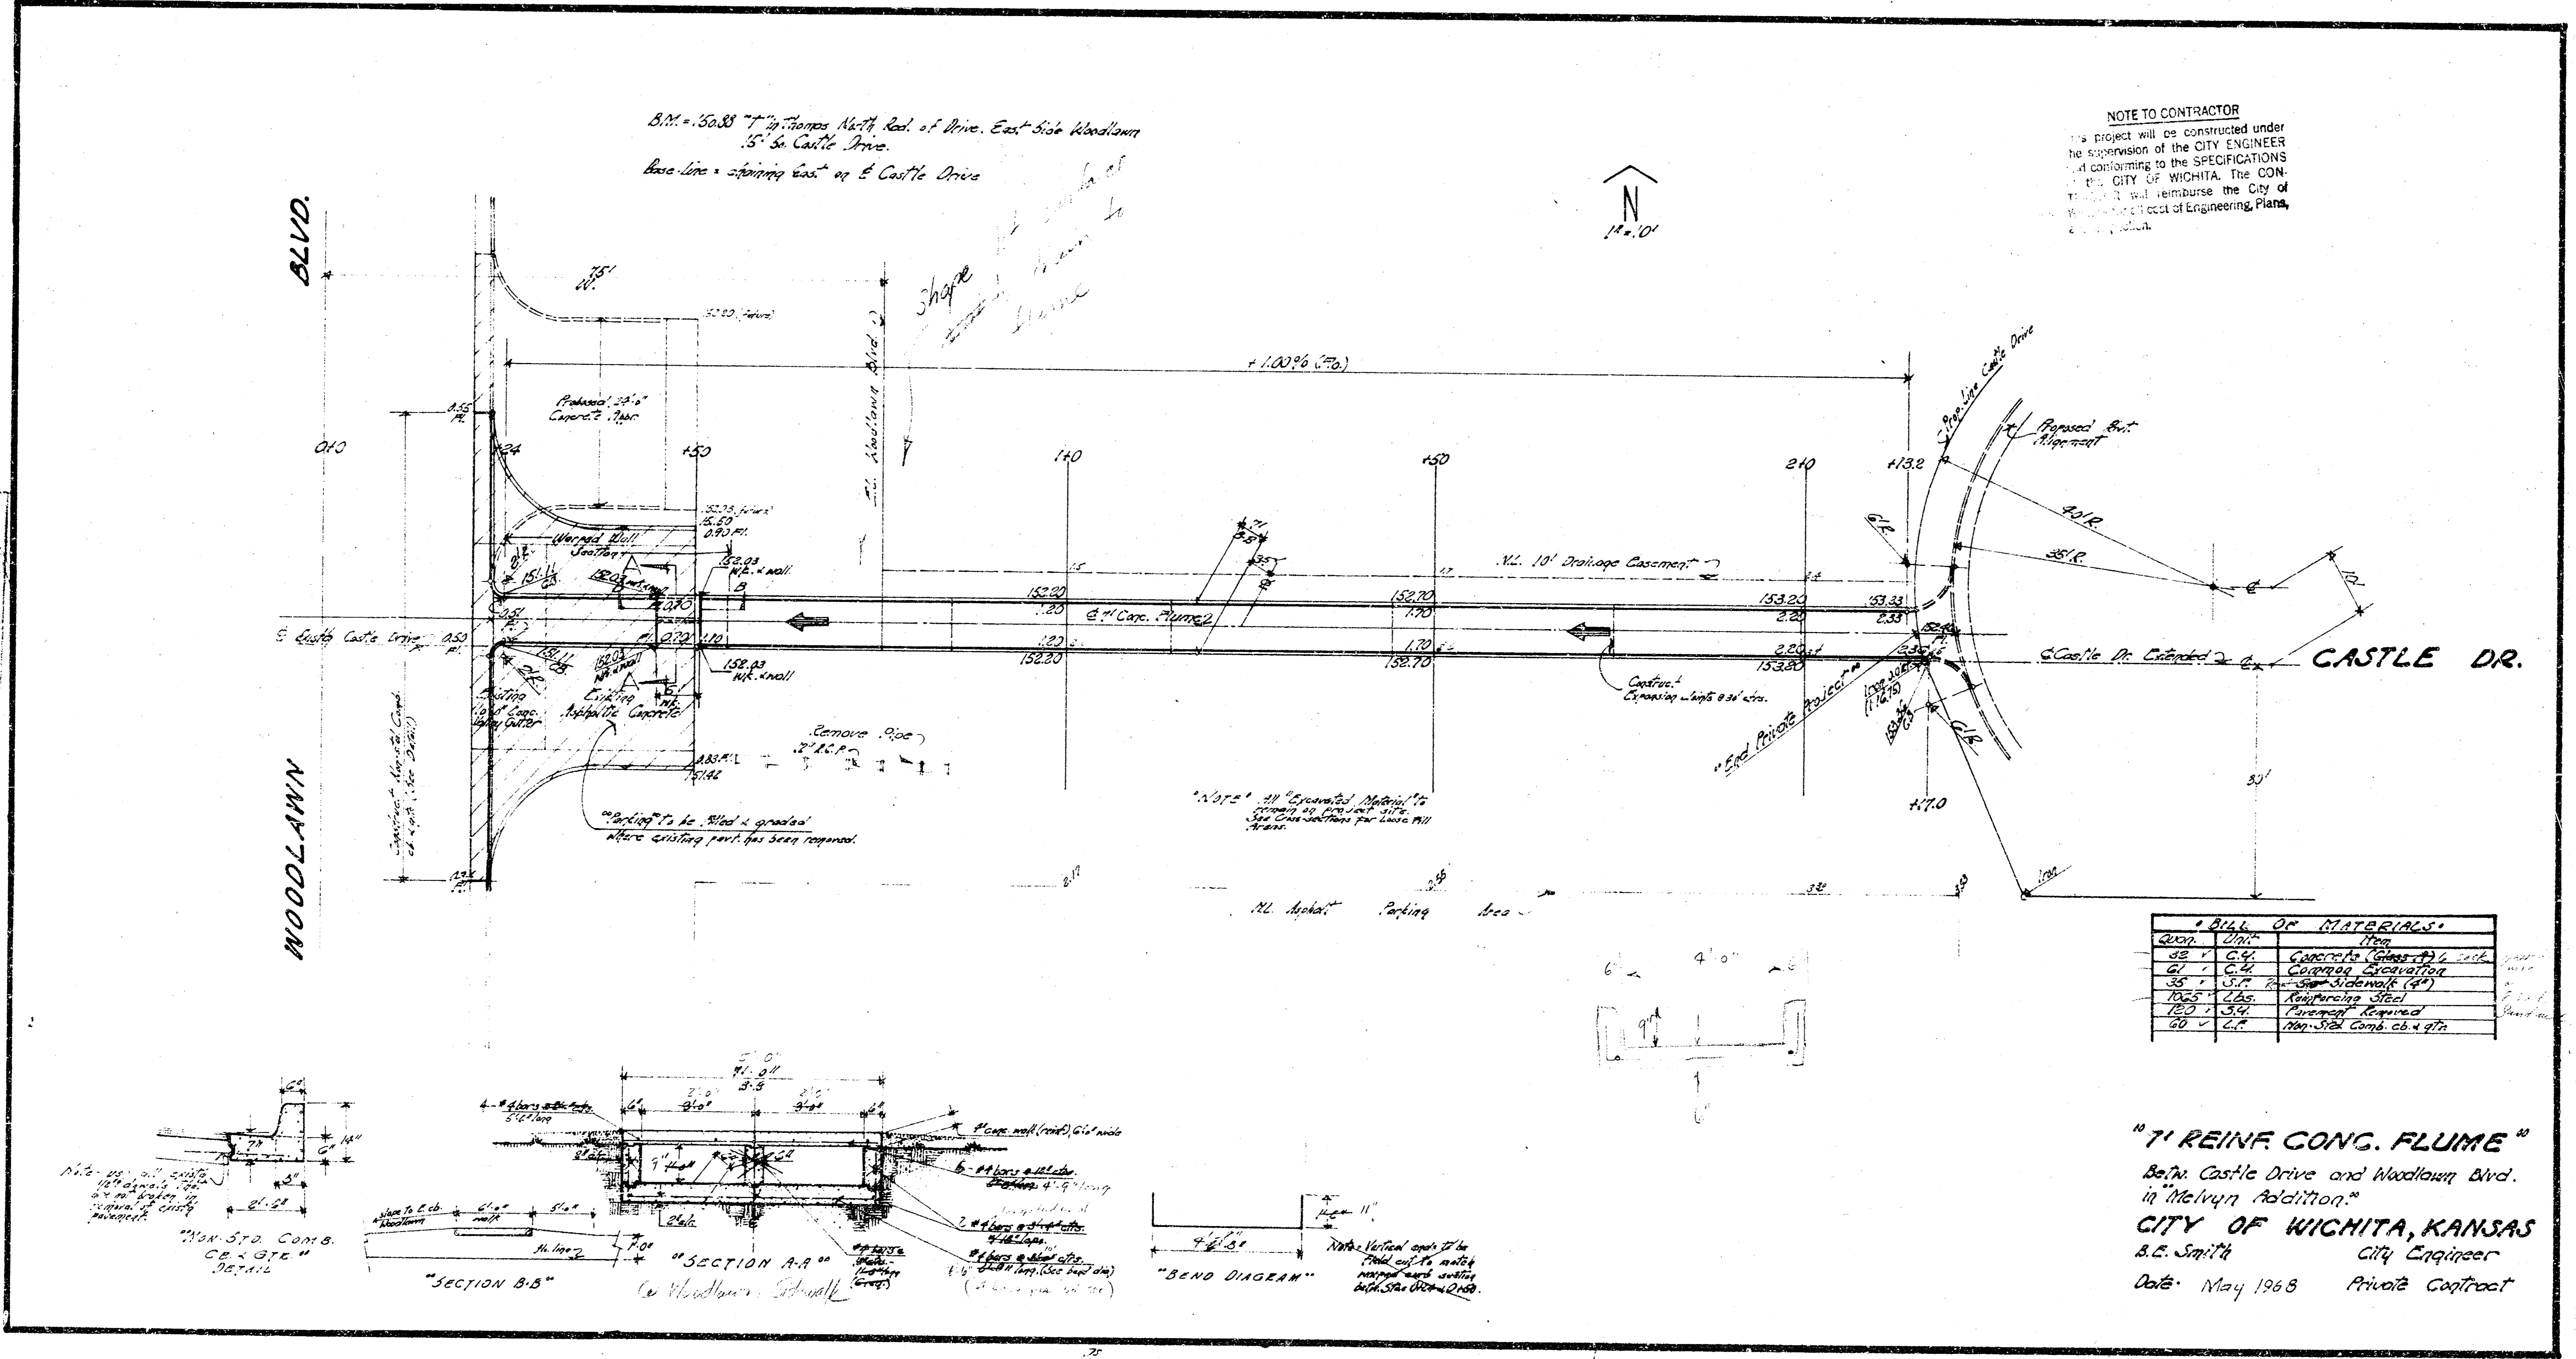

BILL OF MATERIALS

QTY	UNIT	ITEM

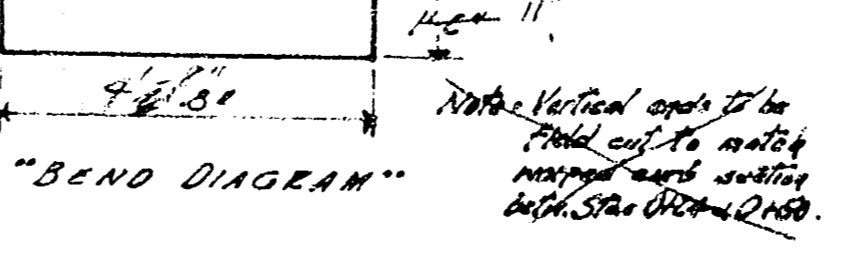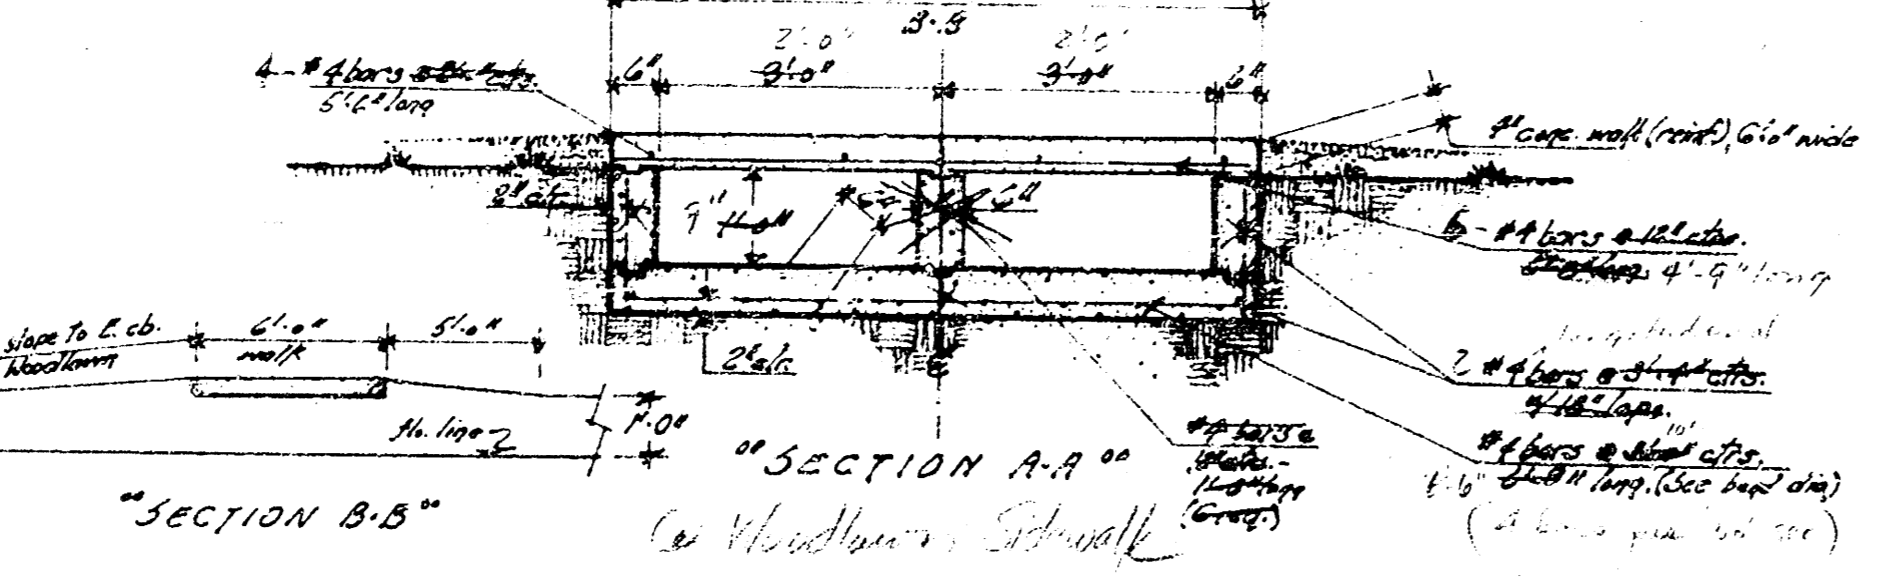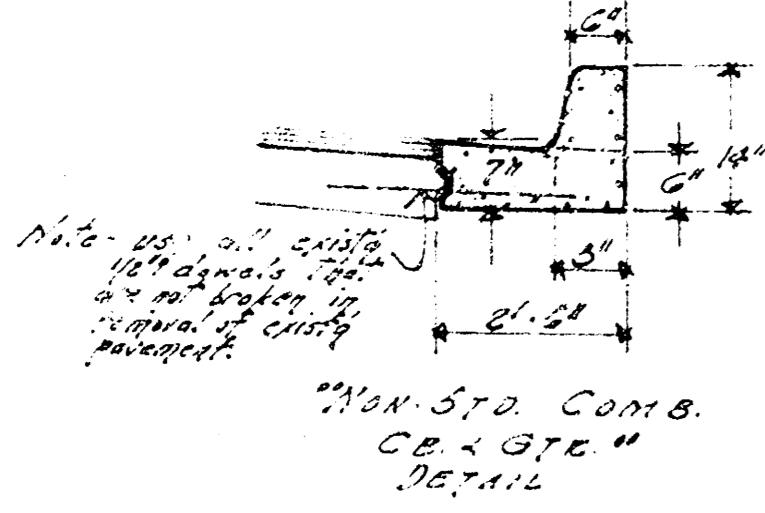

"7' REINF. CONG. FLUME"
 Betw. Castle Drive and Woodlawn Blvd.
 in Melvyn Addition.
CITY OF WICHITA, KANSAS
 A.E. Smith City Engineer
 Date: May 1968 Private Contract