




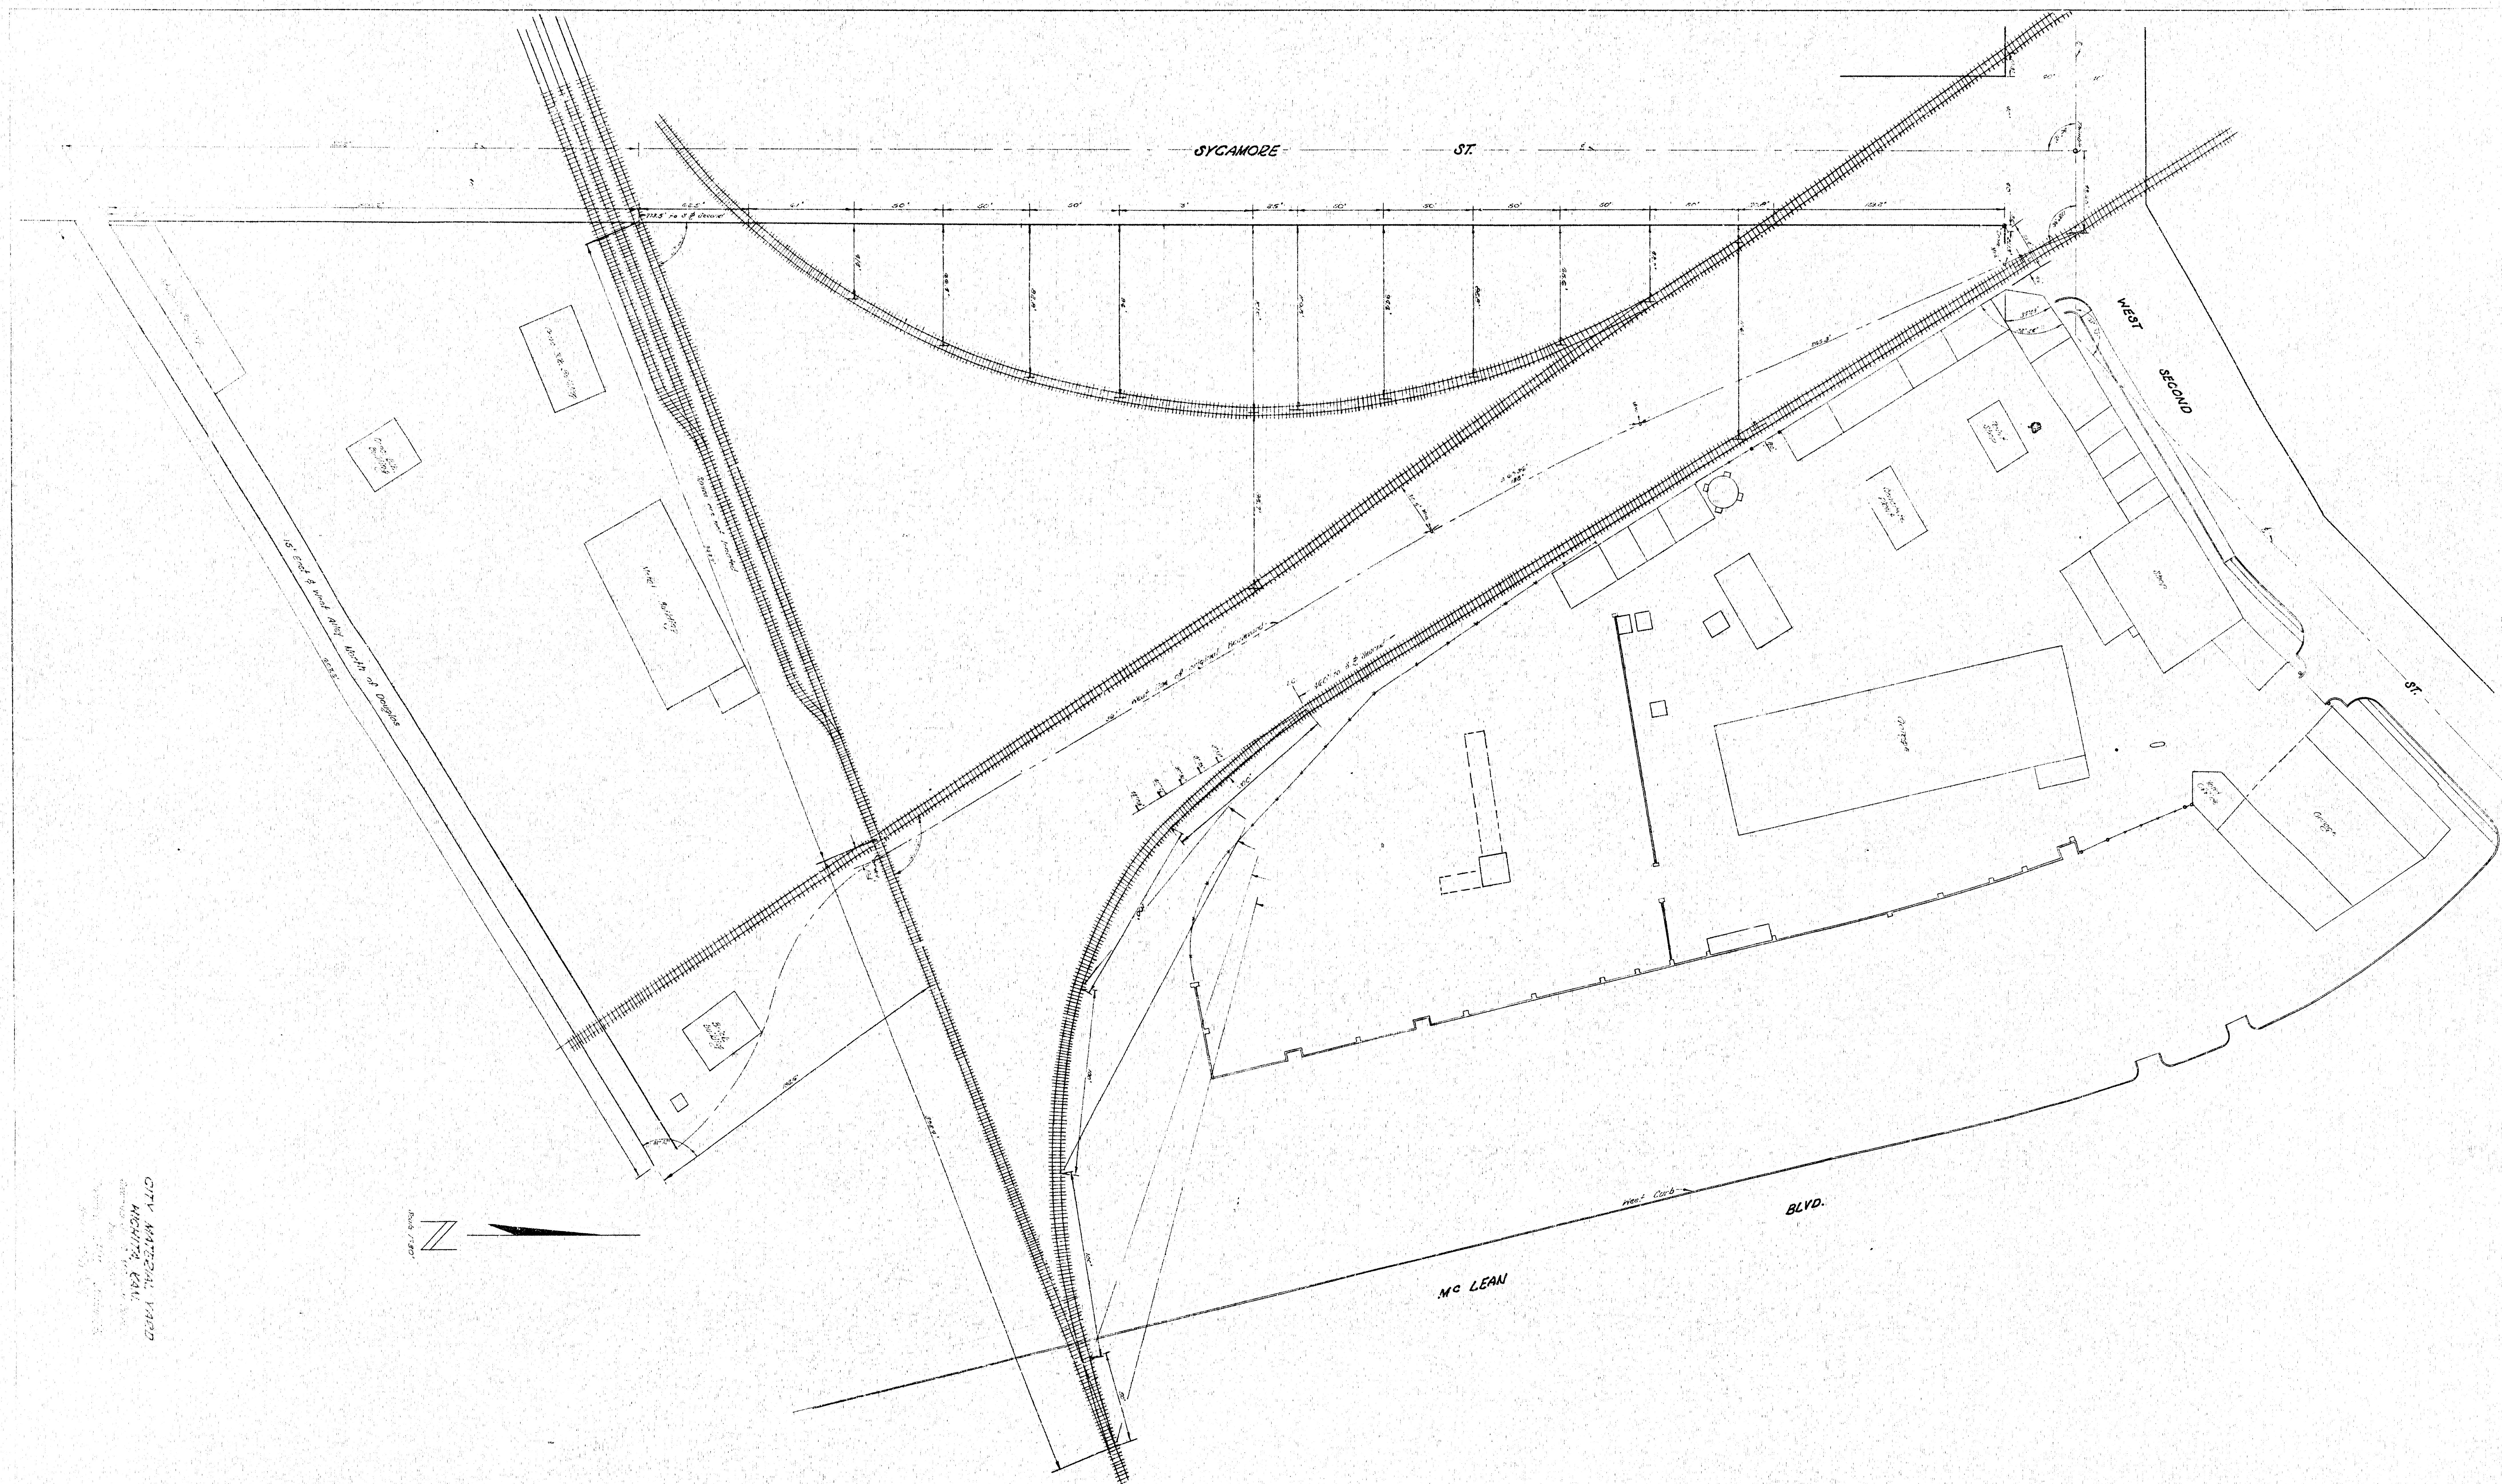

CITY ENGINEER AND  
SPECIAL AGENT  
CHAS. J. BROWN

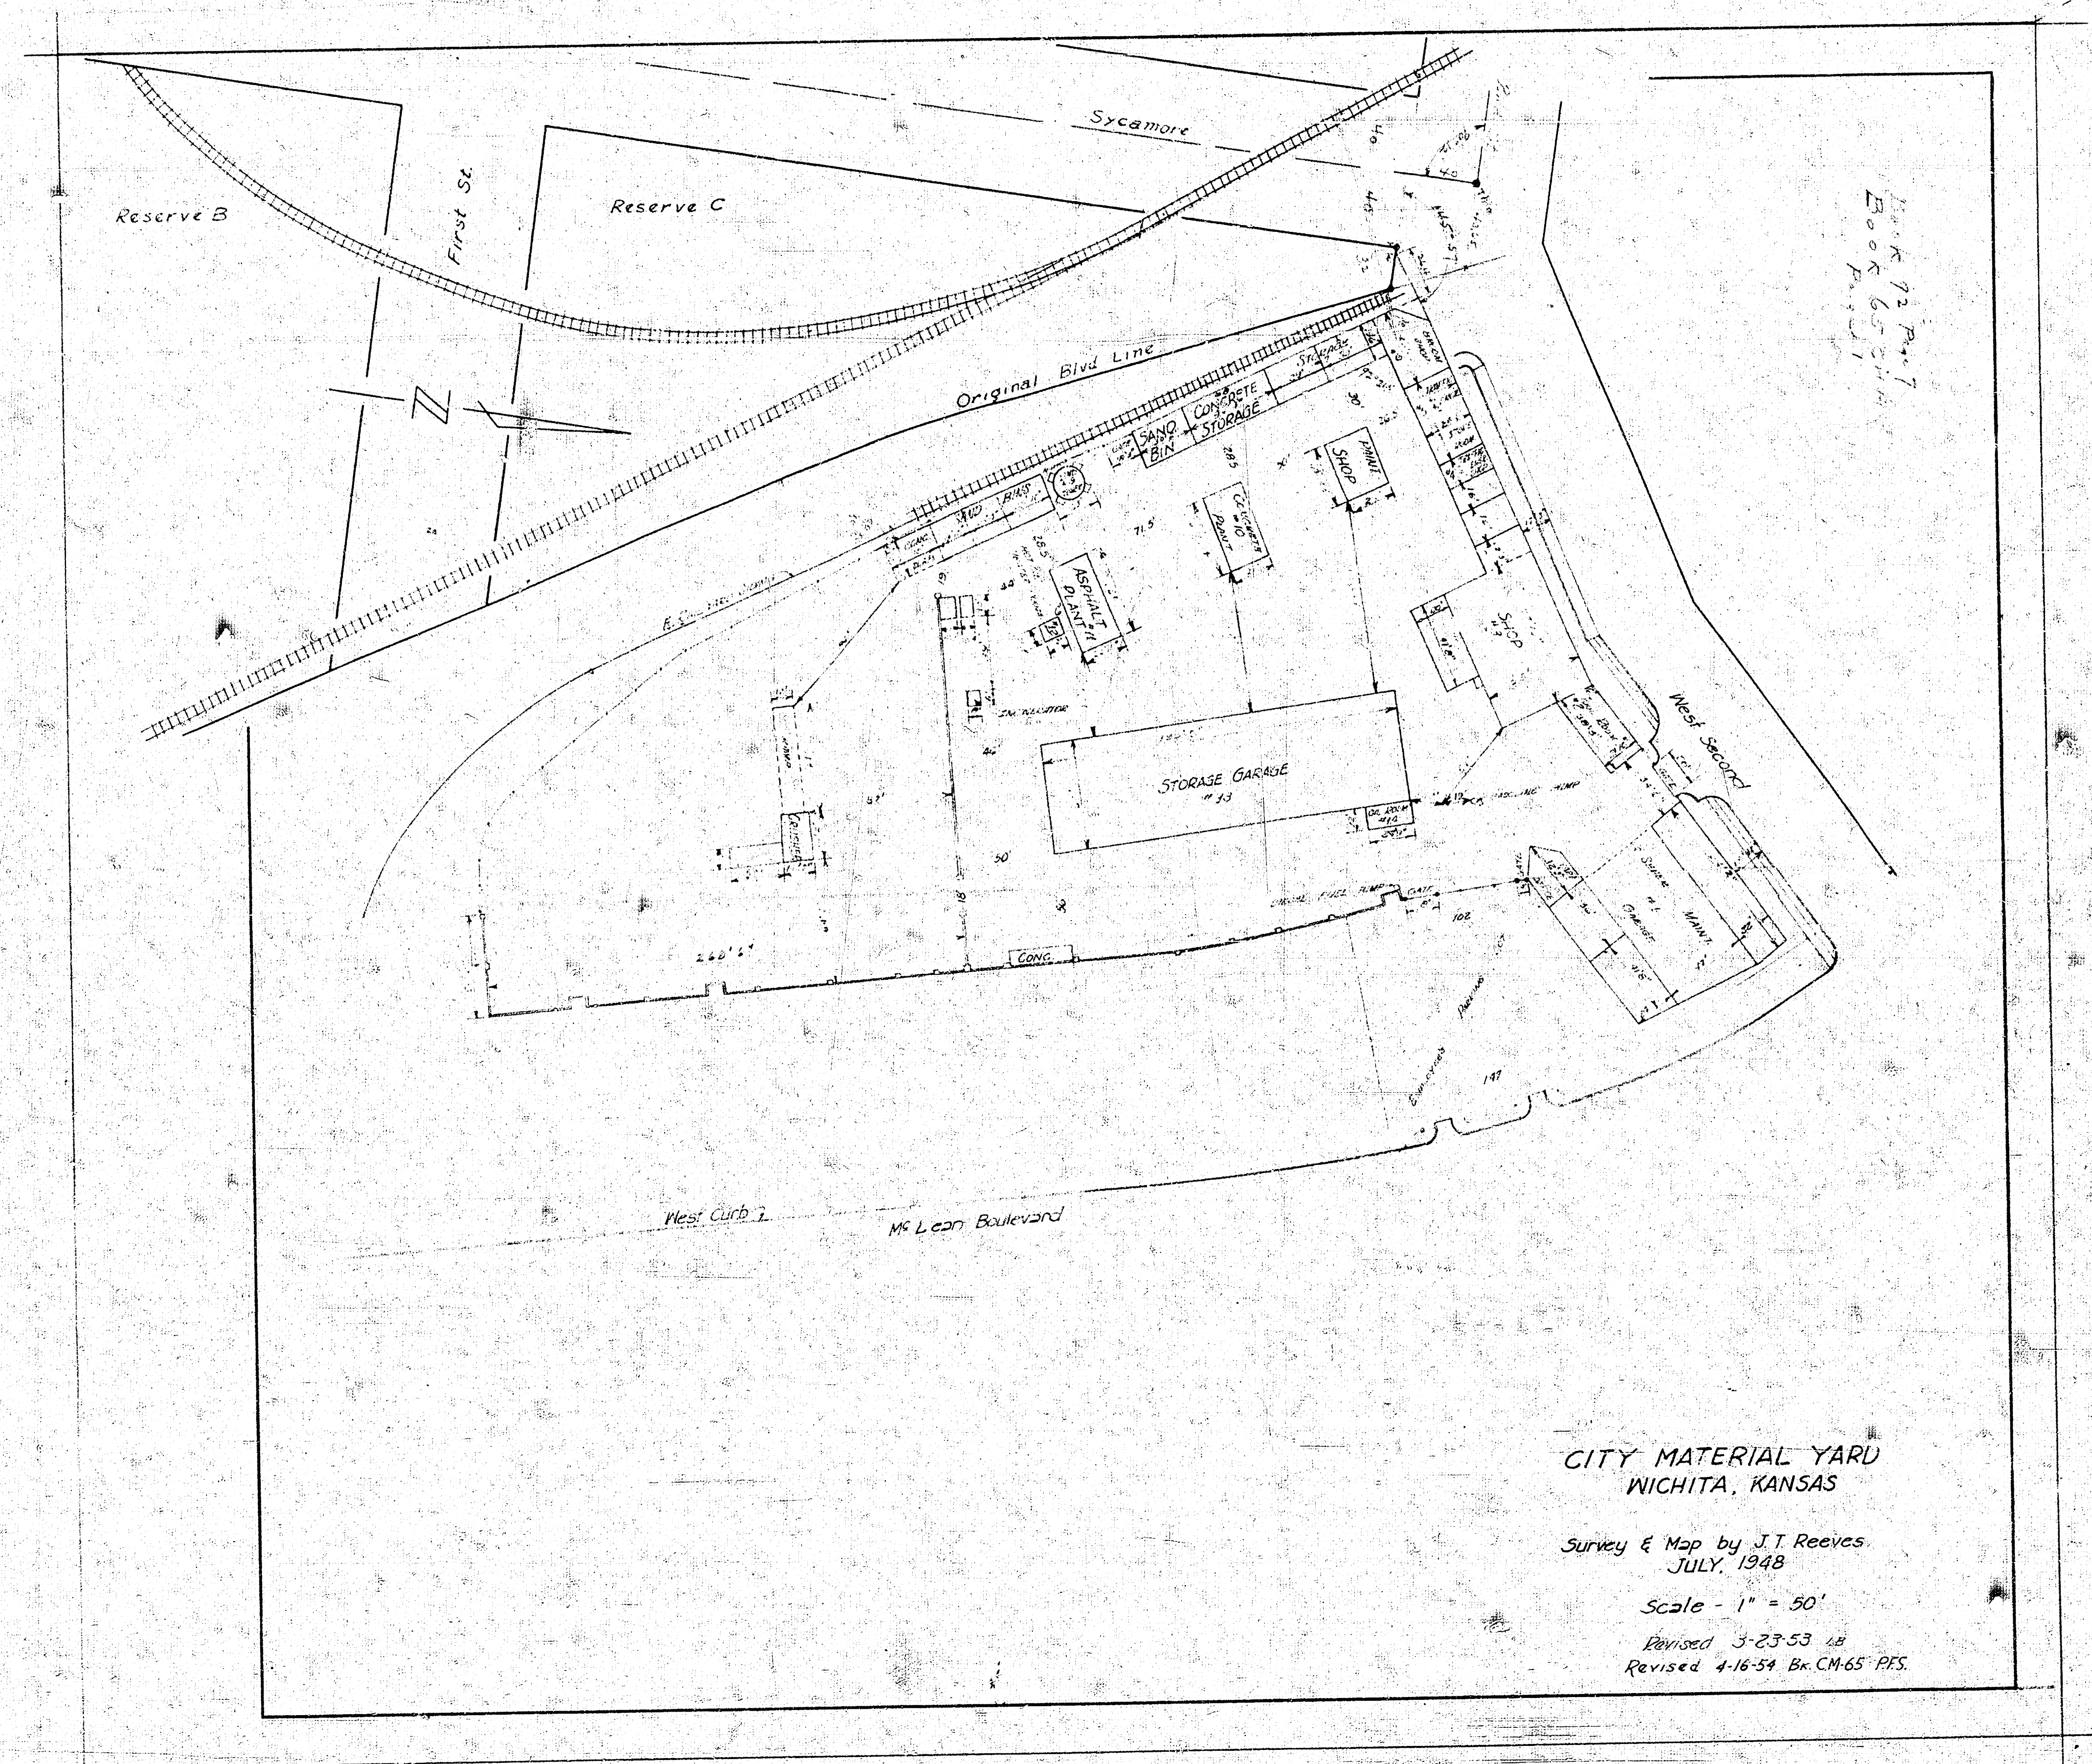

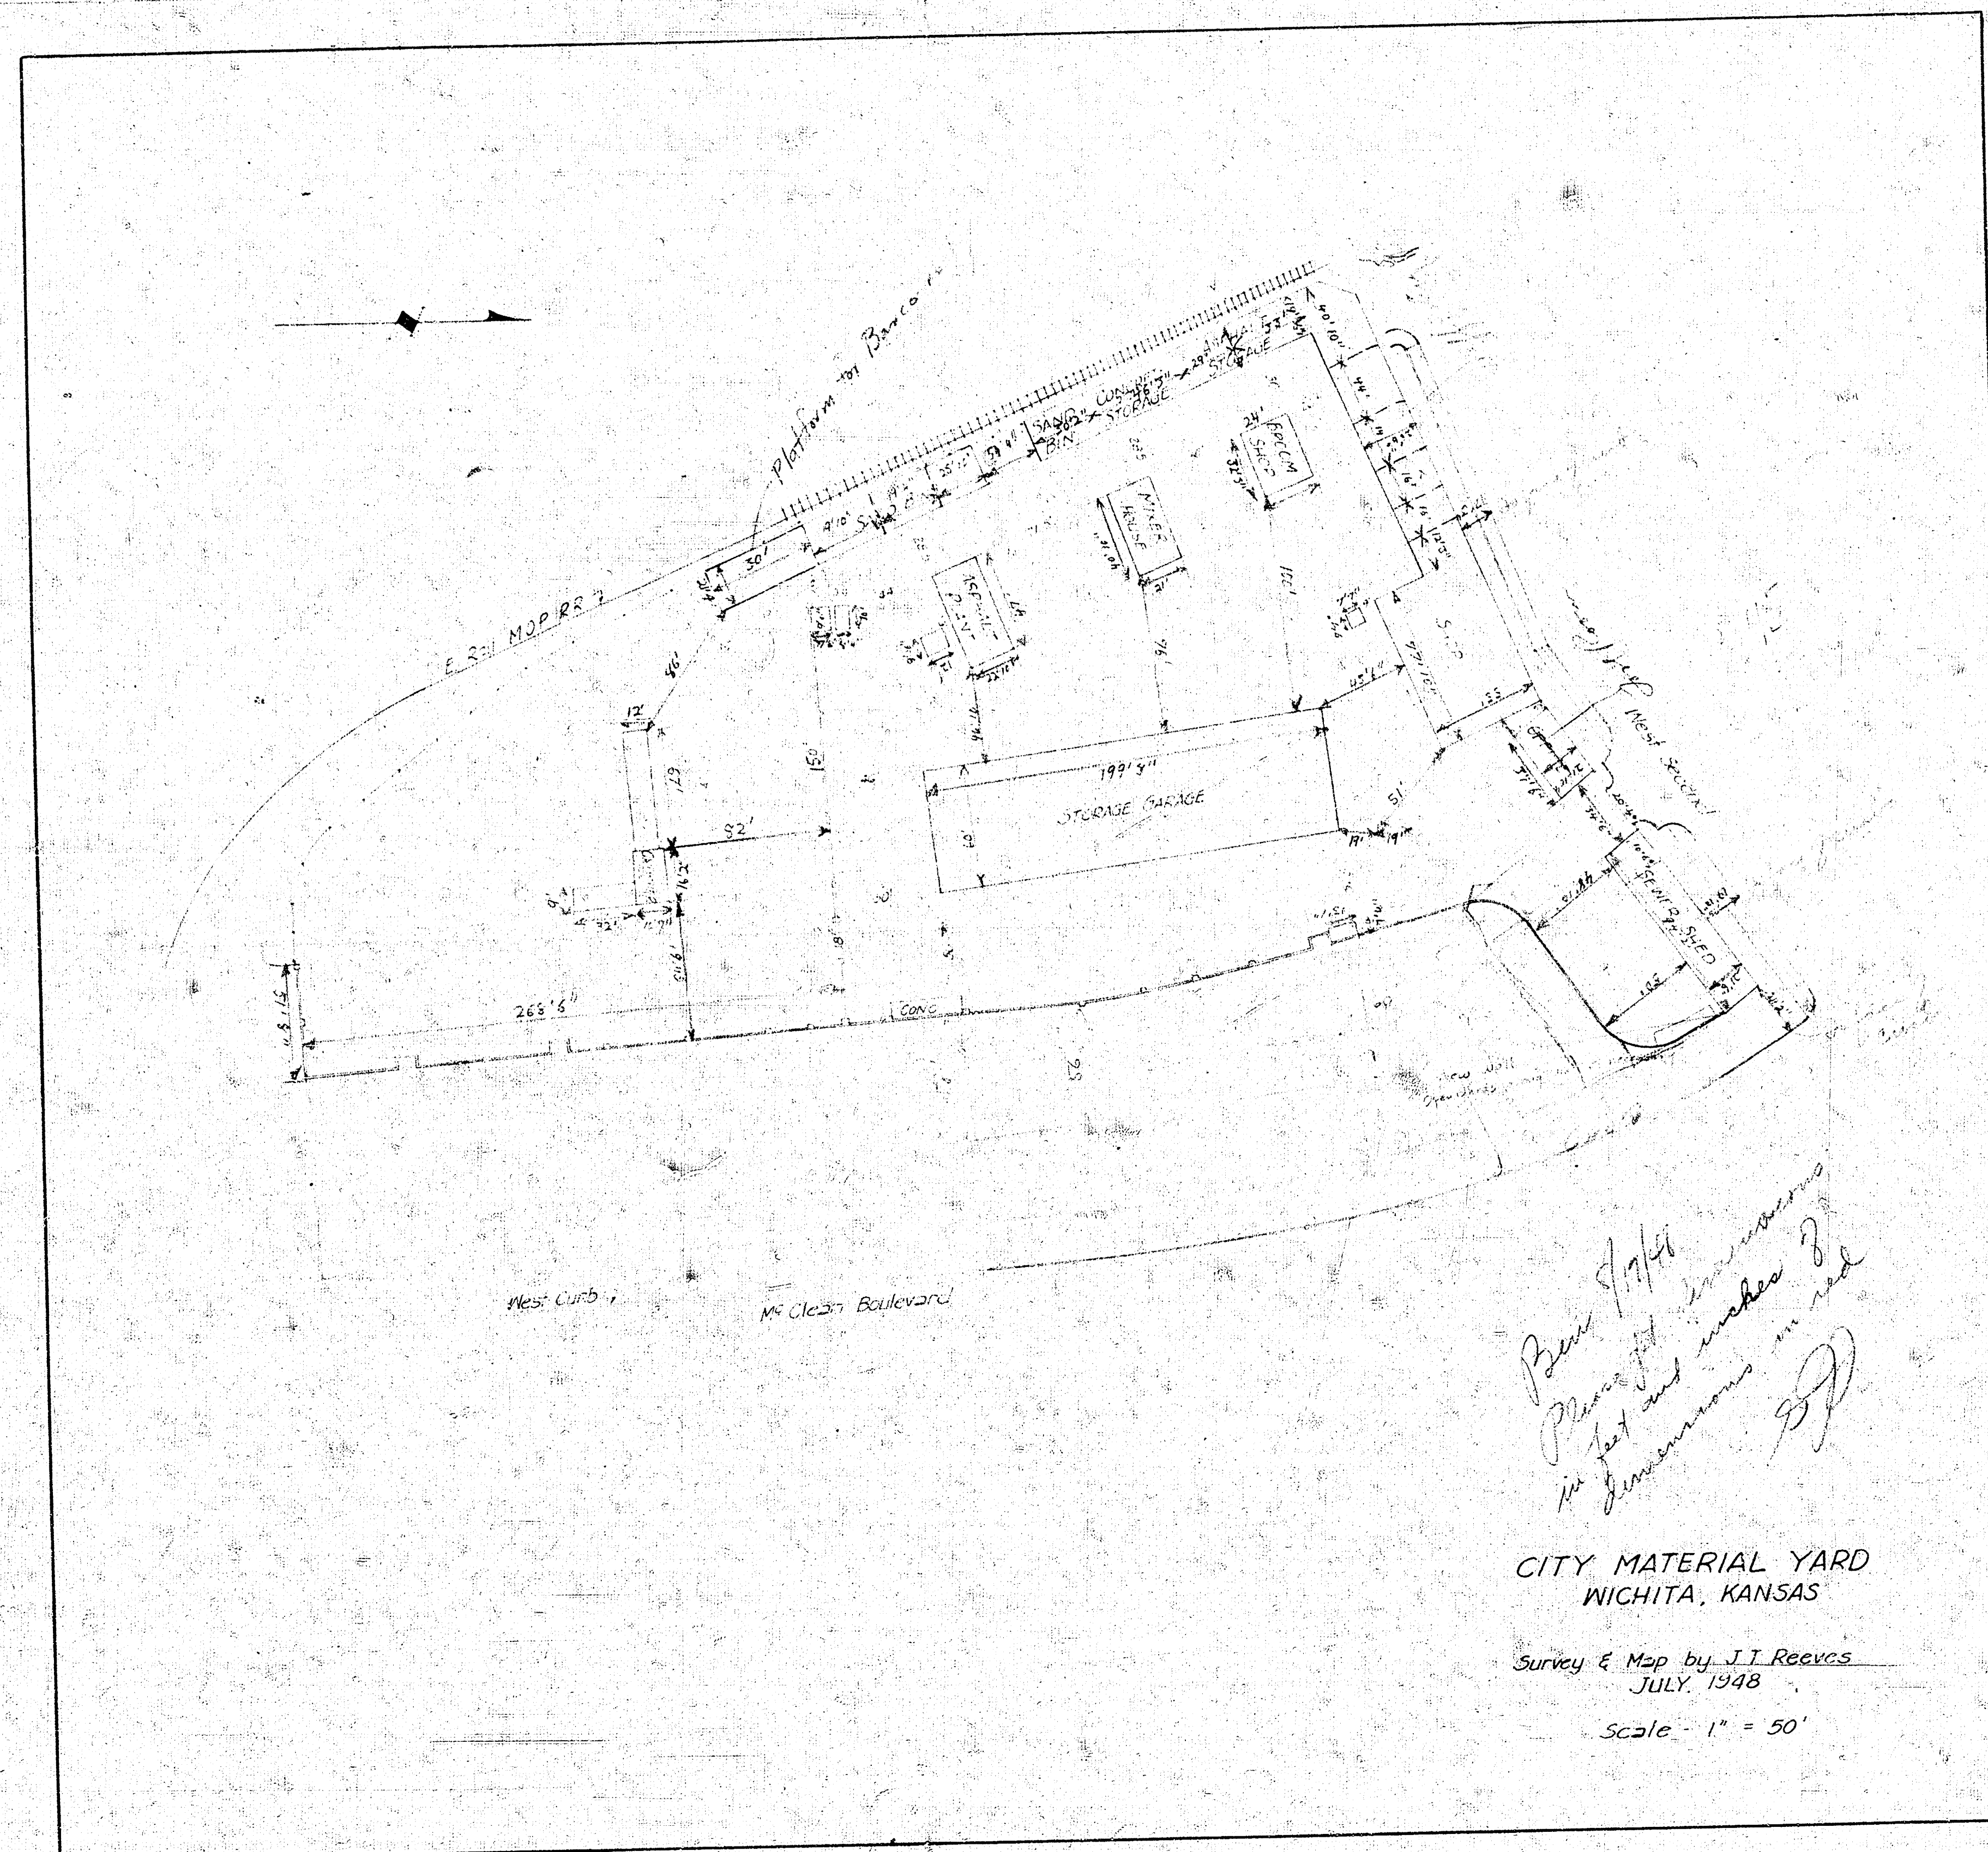

*From 8/7/48  
Please get dimensions  
in feet and inches of  
dimensions in red  
JD*

CITY MATERIAL YARD  
WICHITA, KANSAS

Survey & Map by J.I. Reeves  
JULY, 1948

Scale: 1" = 50'