


NOTE: WATCH FOR OIL TANK NO. LIBRARY
1.5' WATCH FOR WATER CISTERN IN EXIST.
CONC. DRIVE

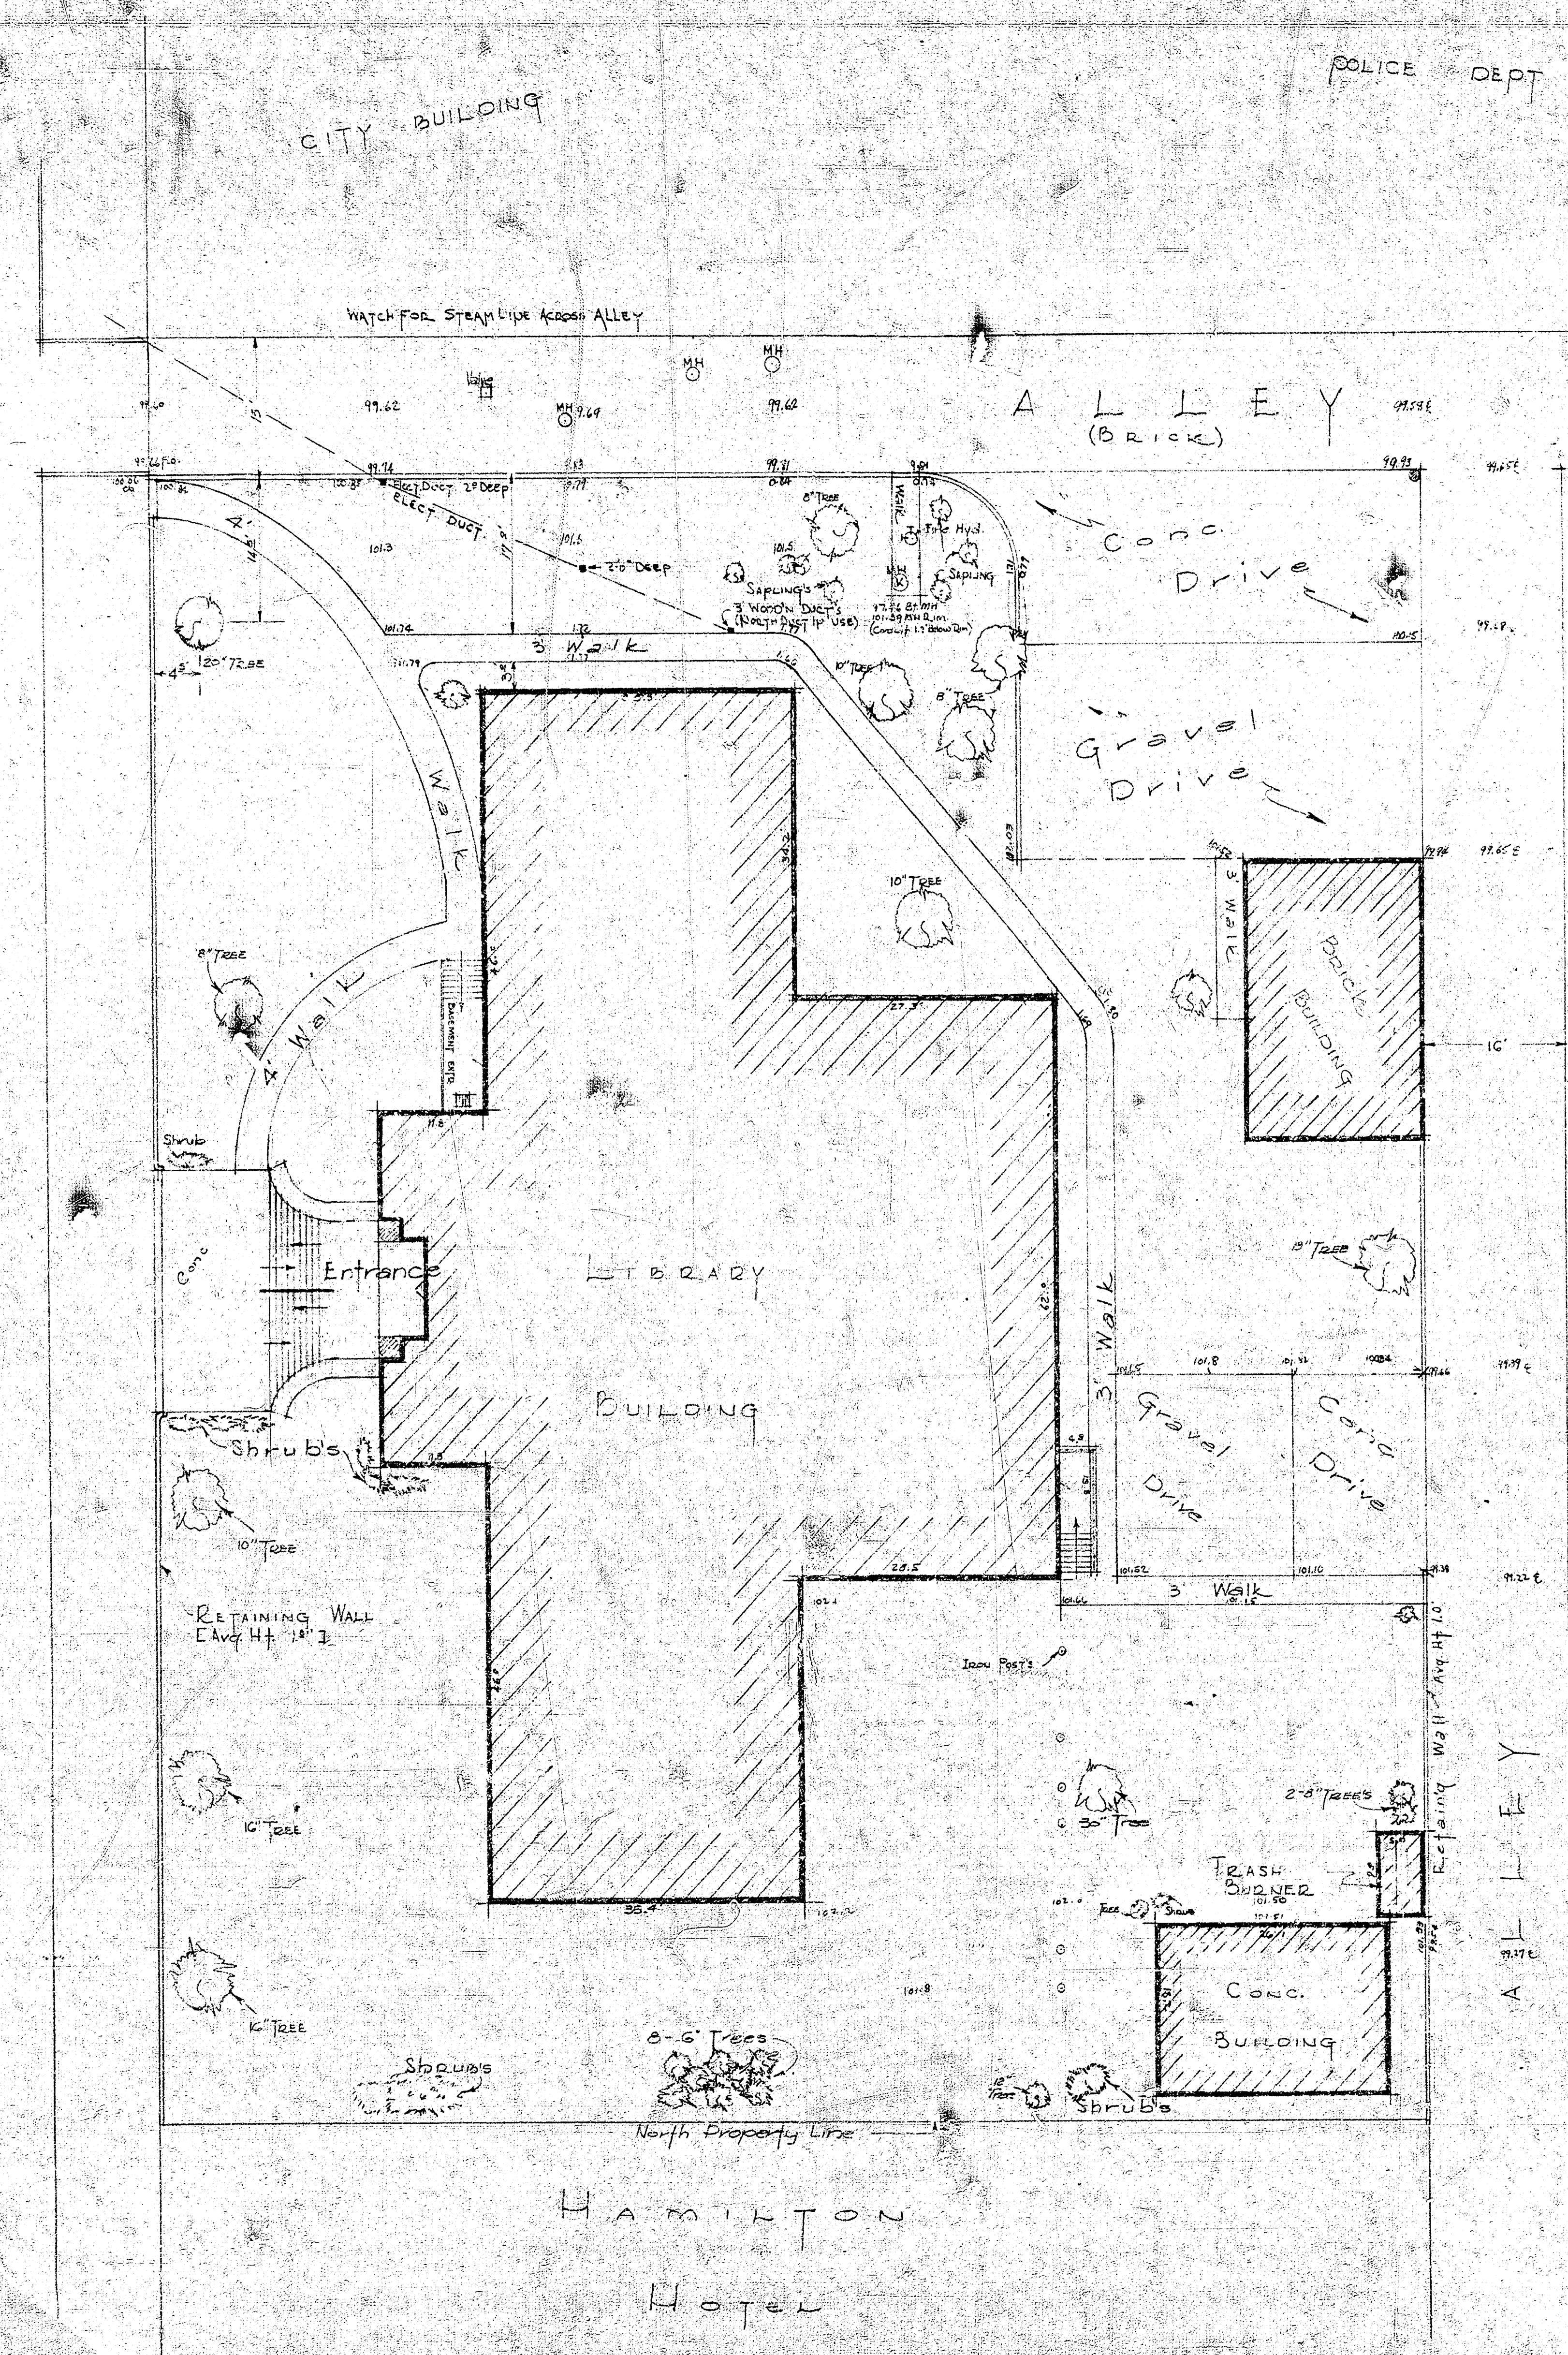

PROPOSED PARKING AREA
FOR CITY LIBRARY
L.K. WHITE CITY ENGINEER
DOWNBY-SQ. SEAL
1949