


MUTEL CO  
 C-9190-A10  





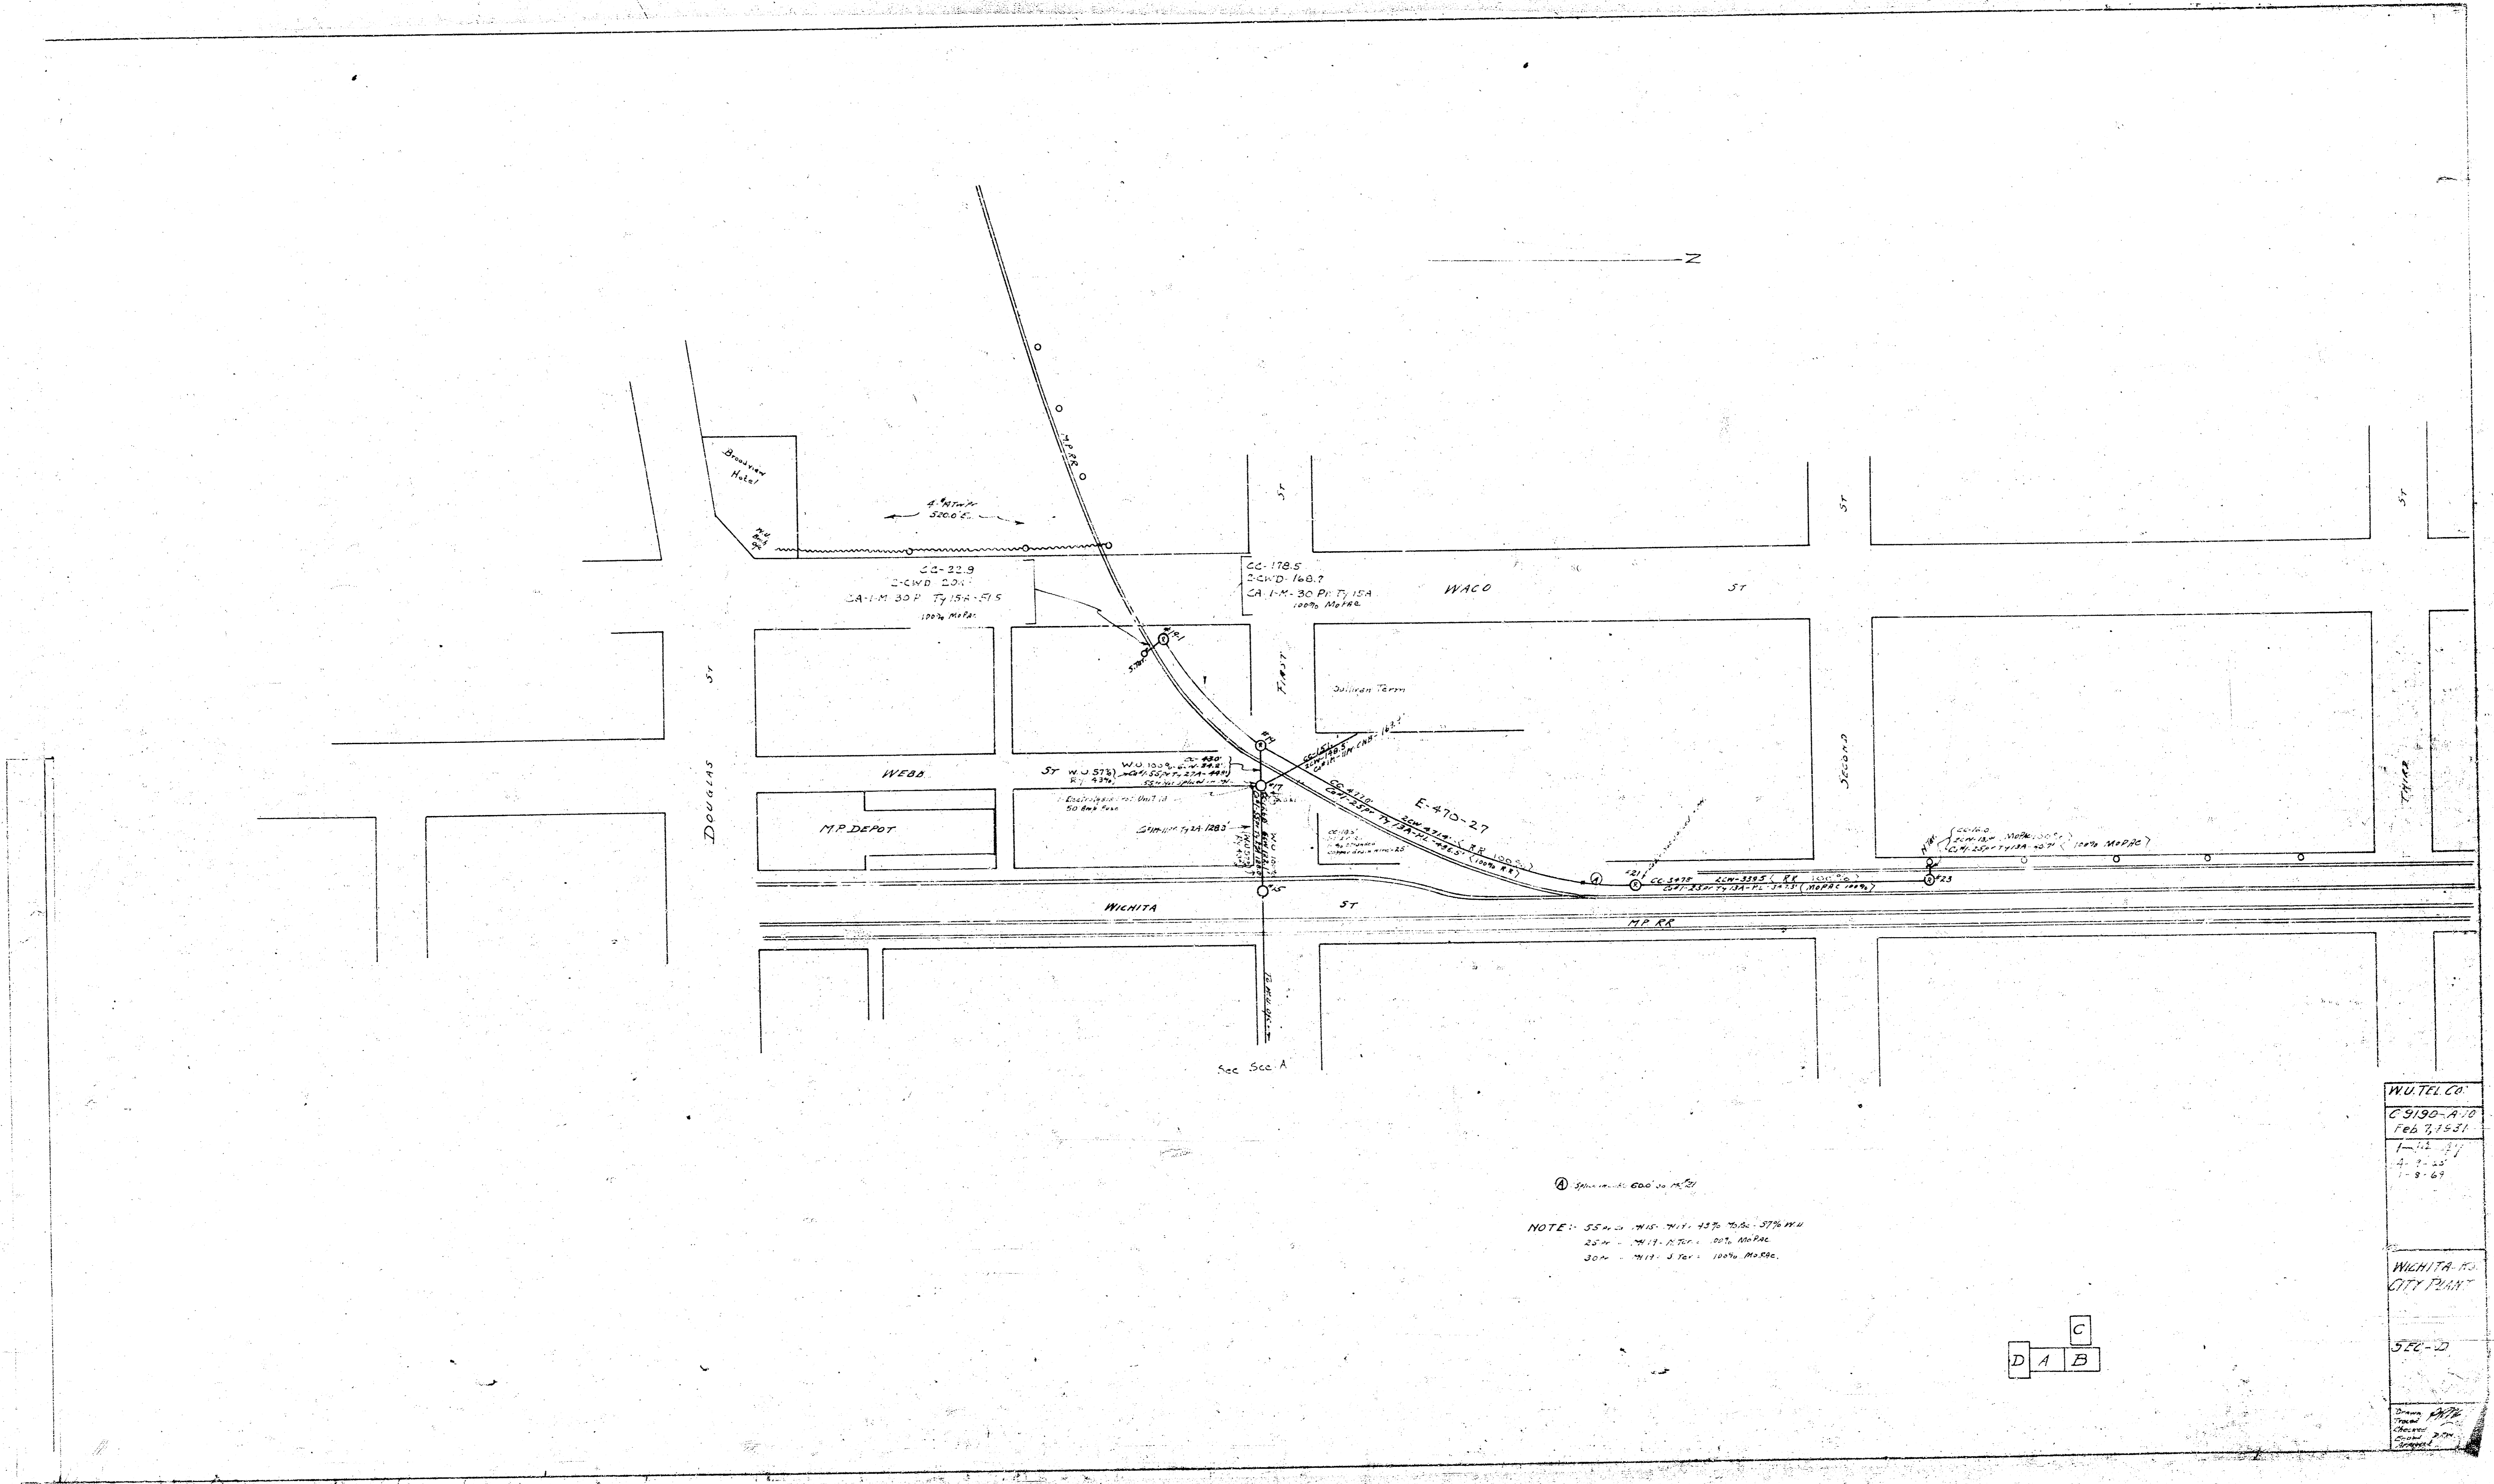


C  
 D A B

WUTEL CO.  
 C-9190-A-10  
 Feb 7, 1931  

WICHITA TO  
 CITY PLANT

SEC-D





