

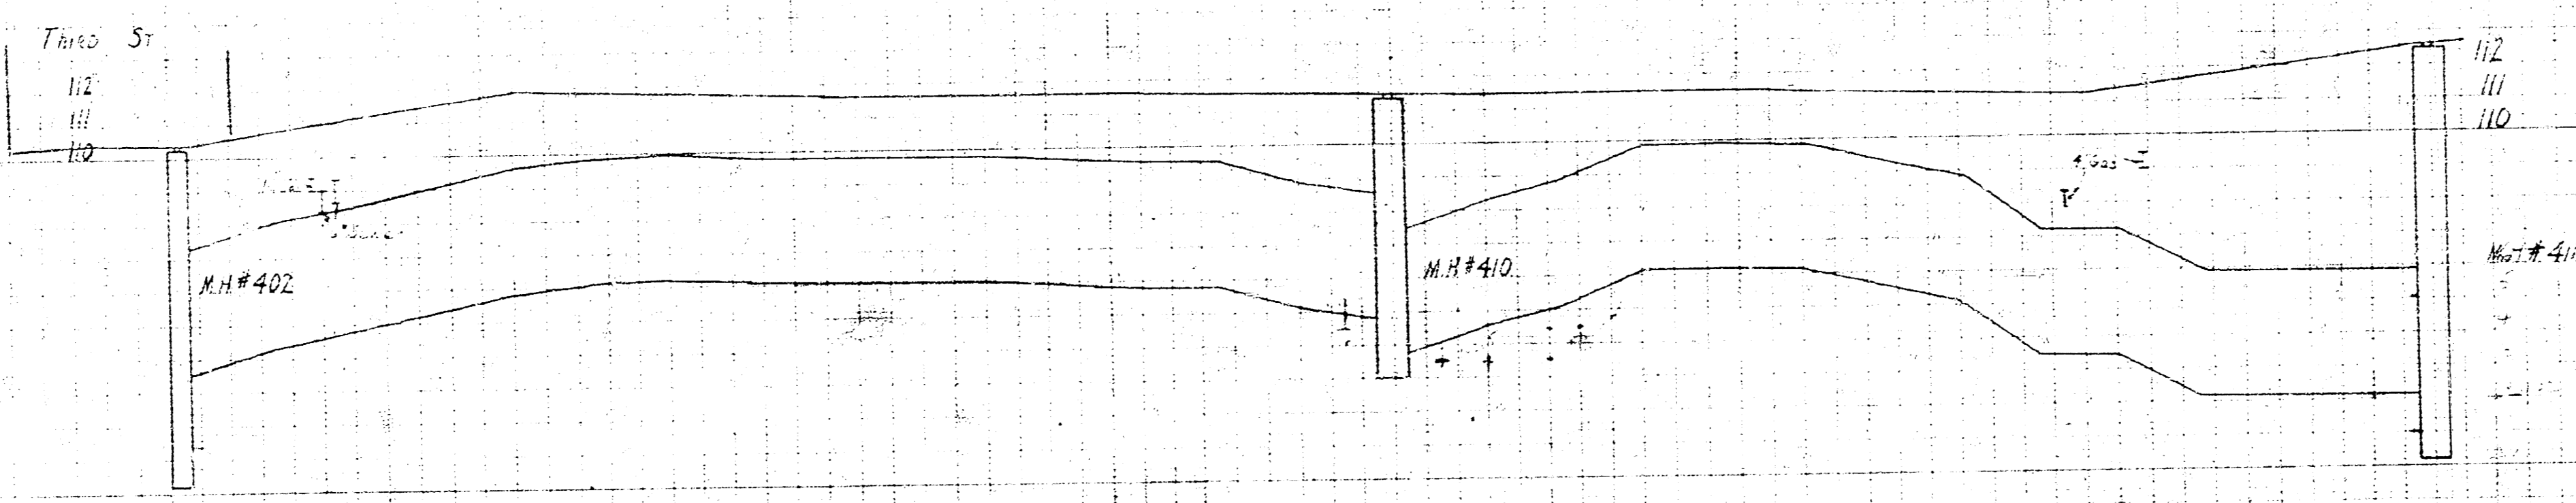


WICHITA UNDERGROUND SYSTEM
 CONDUIT CONSTRUCTION
 EXISTING SUBSURFACE STRUCTURES
 THIRD STREET
 MAY 7, 1925
 WICHITA, KAN. KD 1143

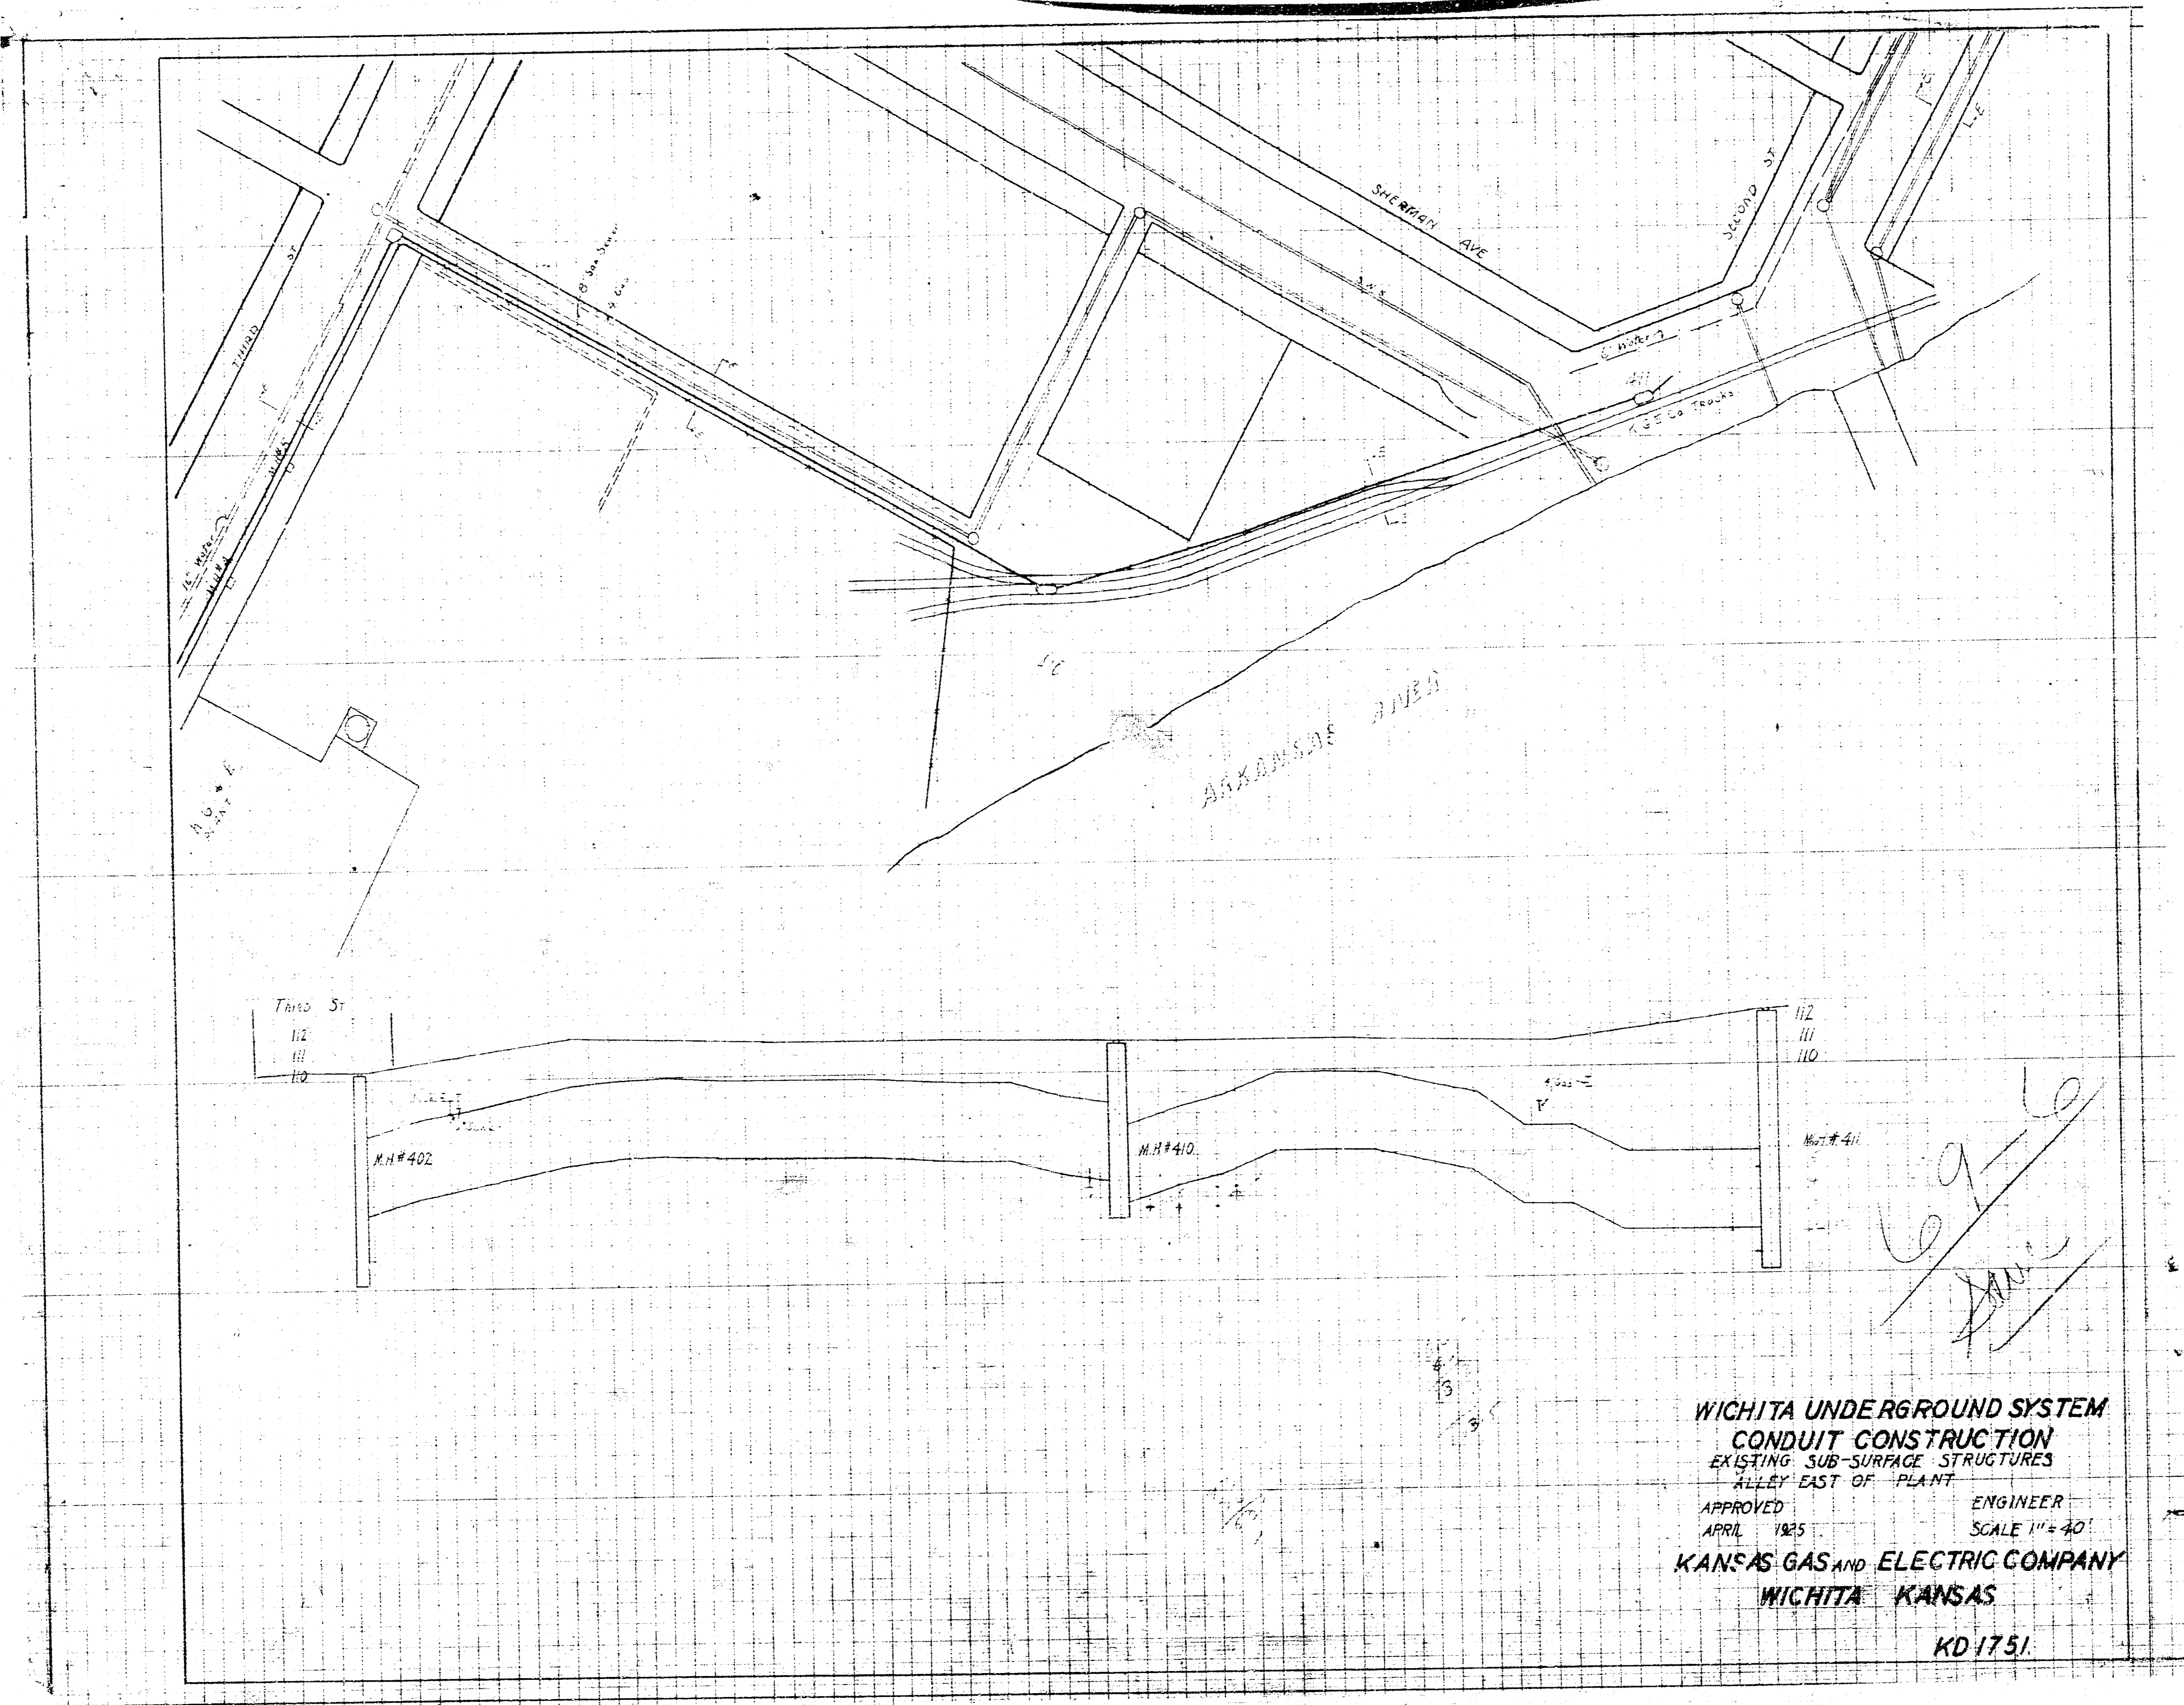

WICHITA UNDERGROUND SYSTEM
CONDUIT CONSTRUCTION
 EXISTING SUB-SURFACE STRUCTURES
 ALLEY EAST OF PLANT
 APPROVED APRIL 1925
 KANSAS GAS AND ELECTRIC COMPANY
 WICHITA KANSAS
 KD 1751

69.6
JAN

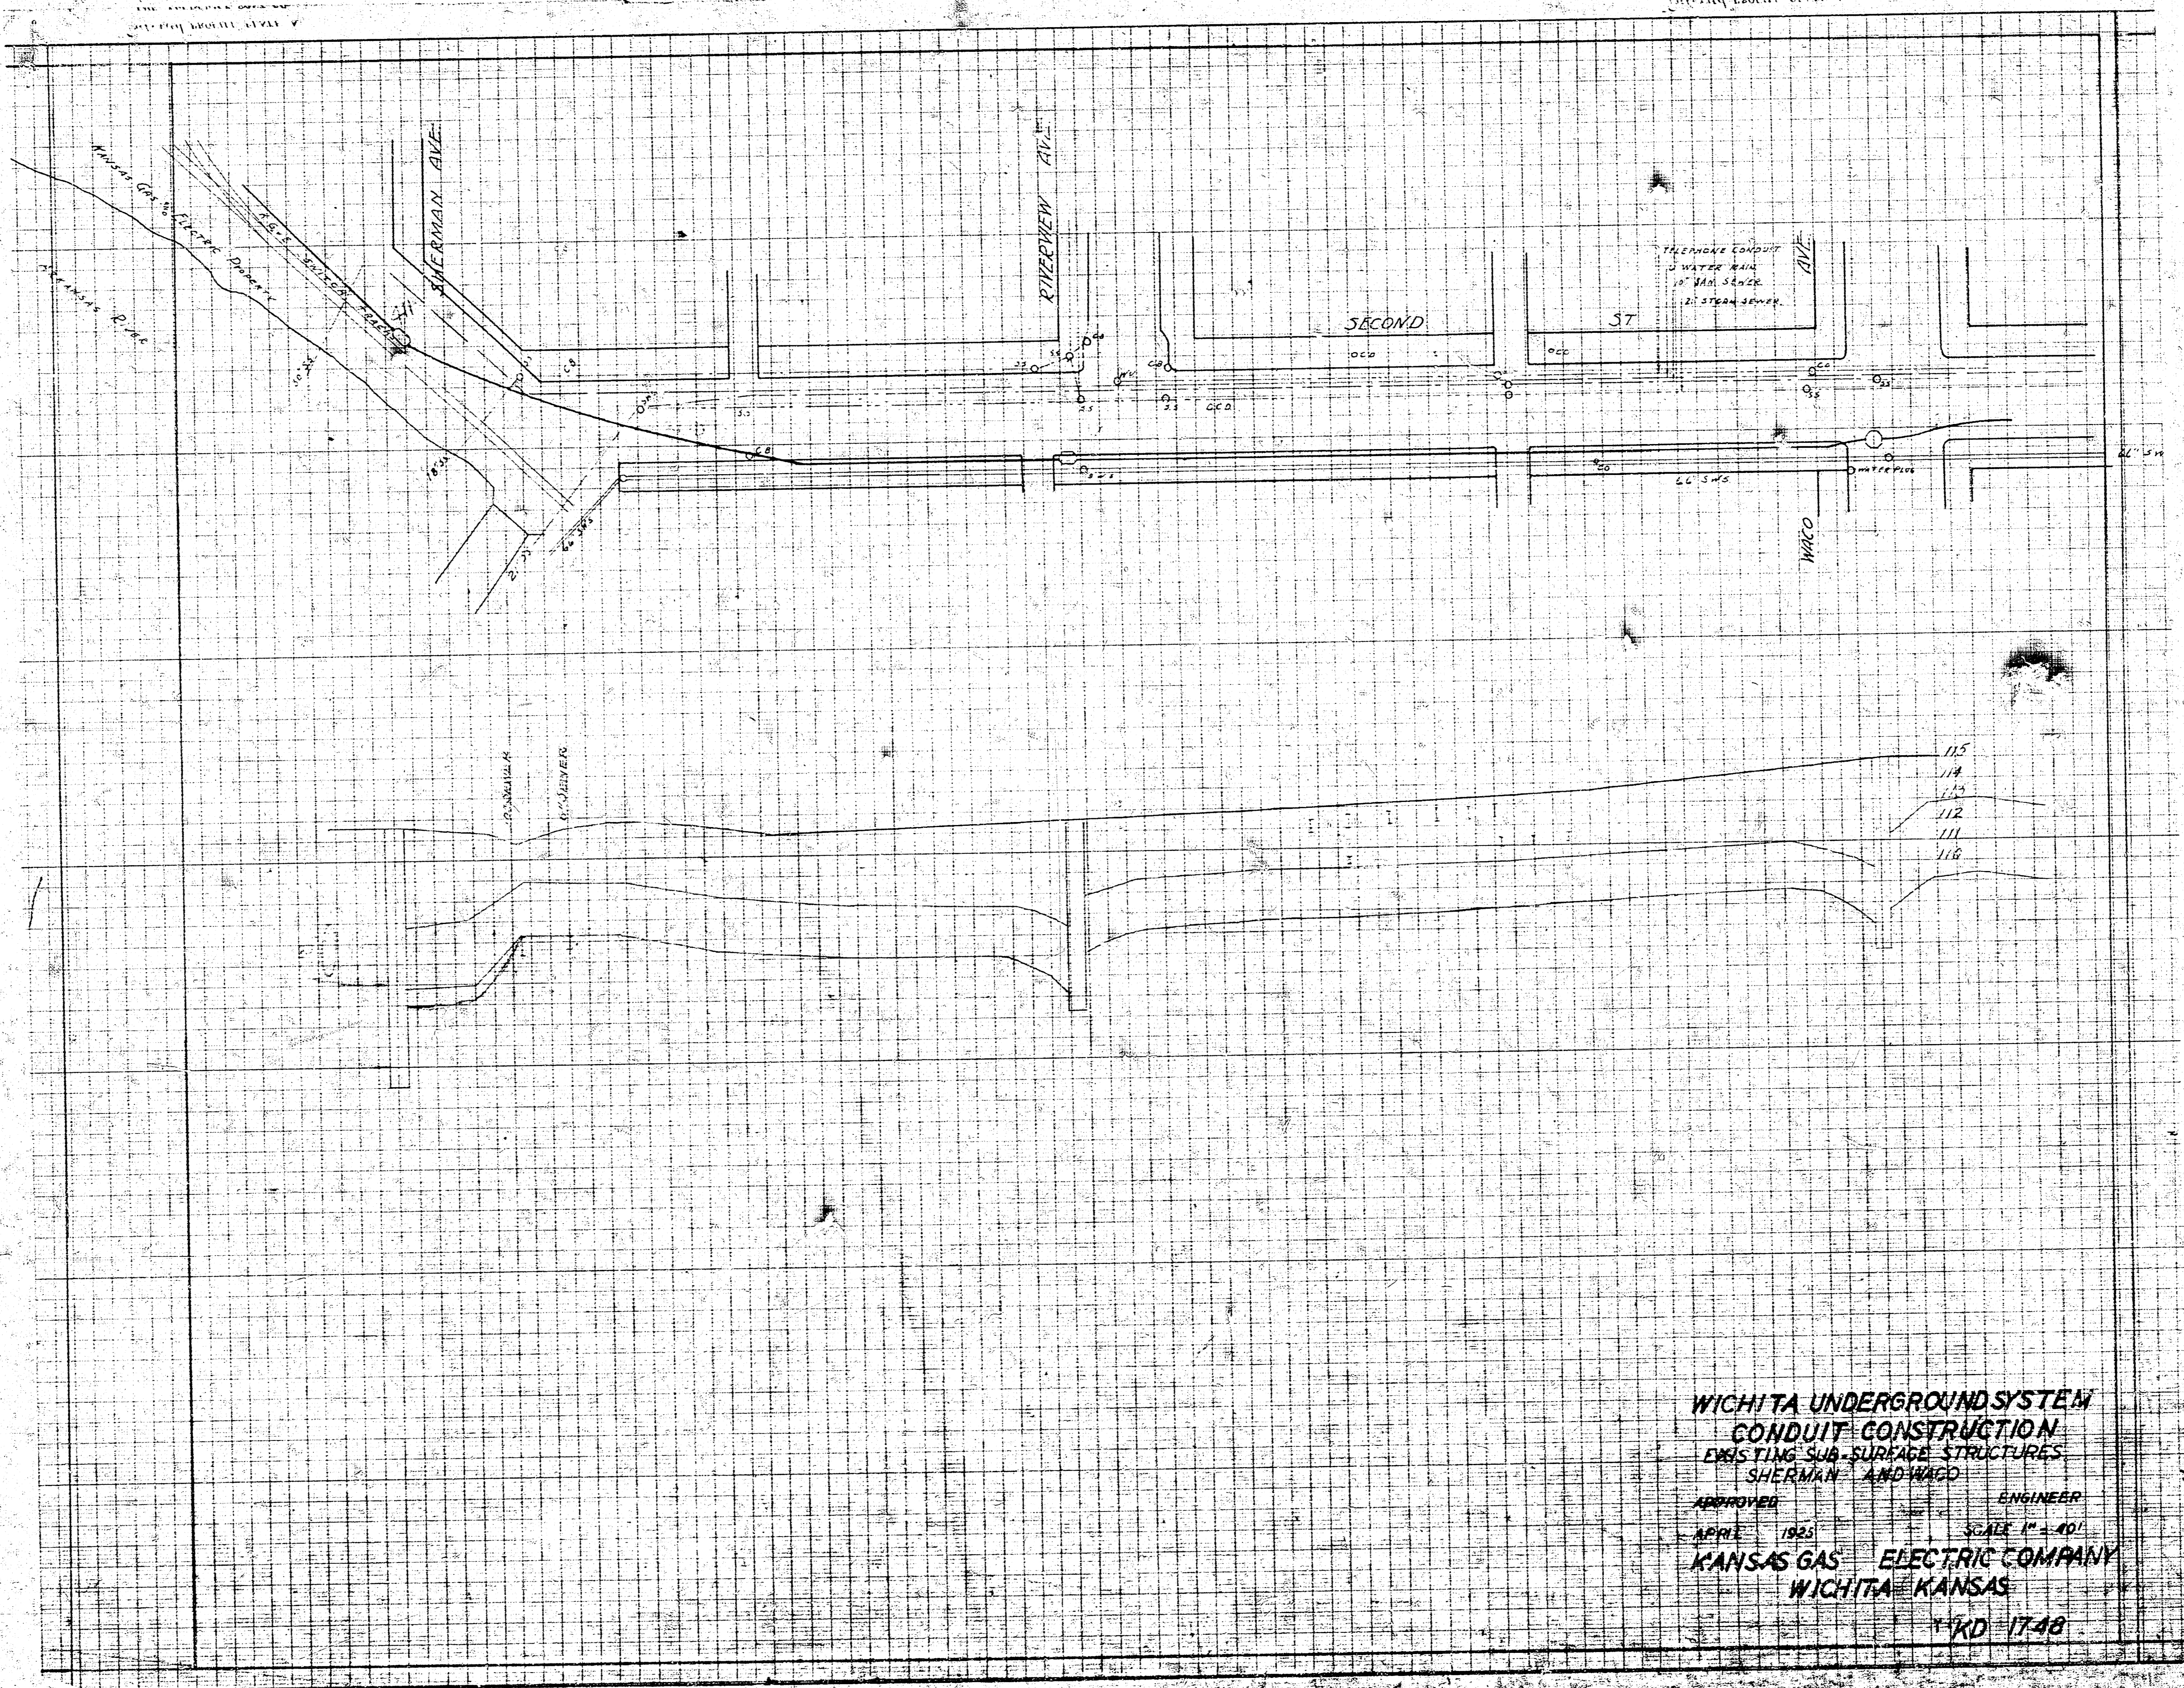

WICHITA UNDERGROUND SYSTEM
CONDUIT CONSTRUCTION
 EXISTING SUB-SURFACE STRUCTURES
 SHERMAN AND WAGO
 APPROVED: _____ ENGINEER
 APRIL 1925 SCALE 1" = 40'
KANSAS GAS ELECTRIC COMPANY
 WICHITA, KANSAS
 KD 1748