



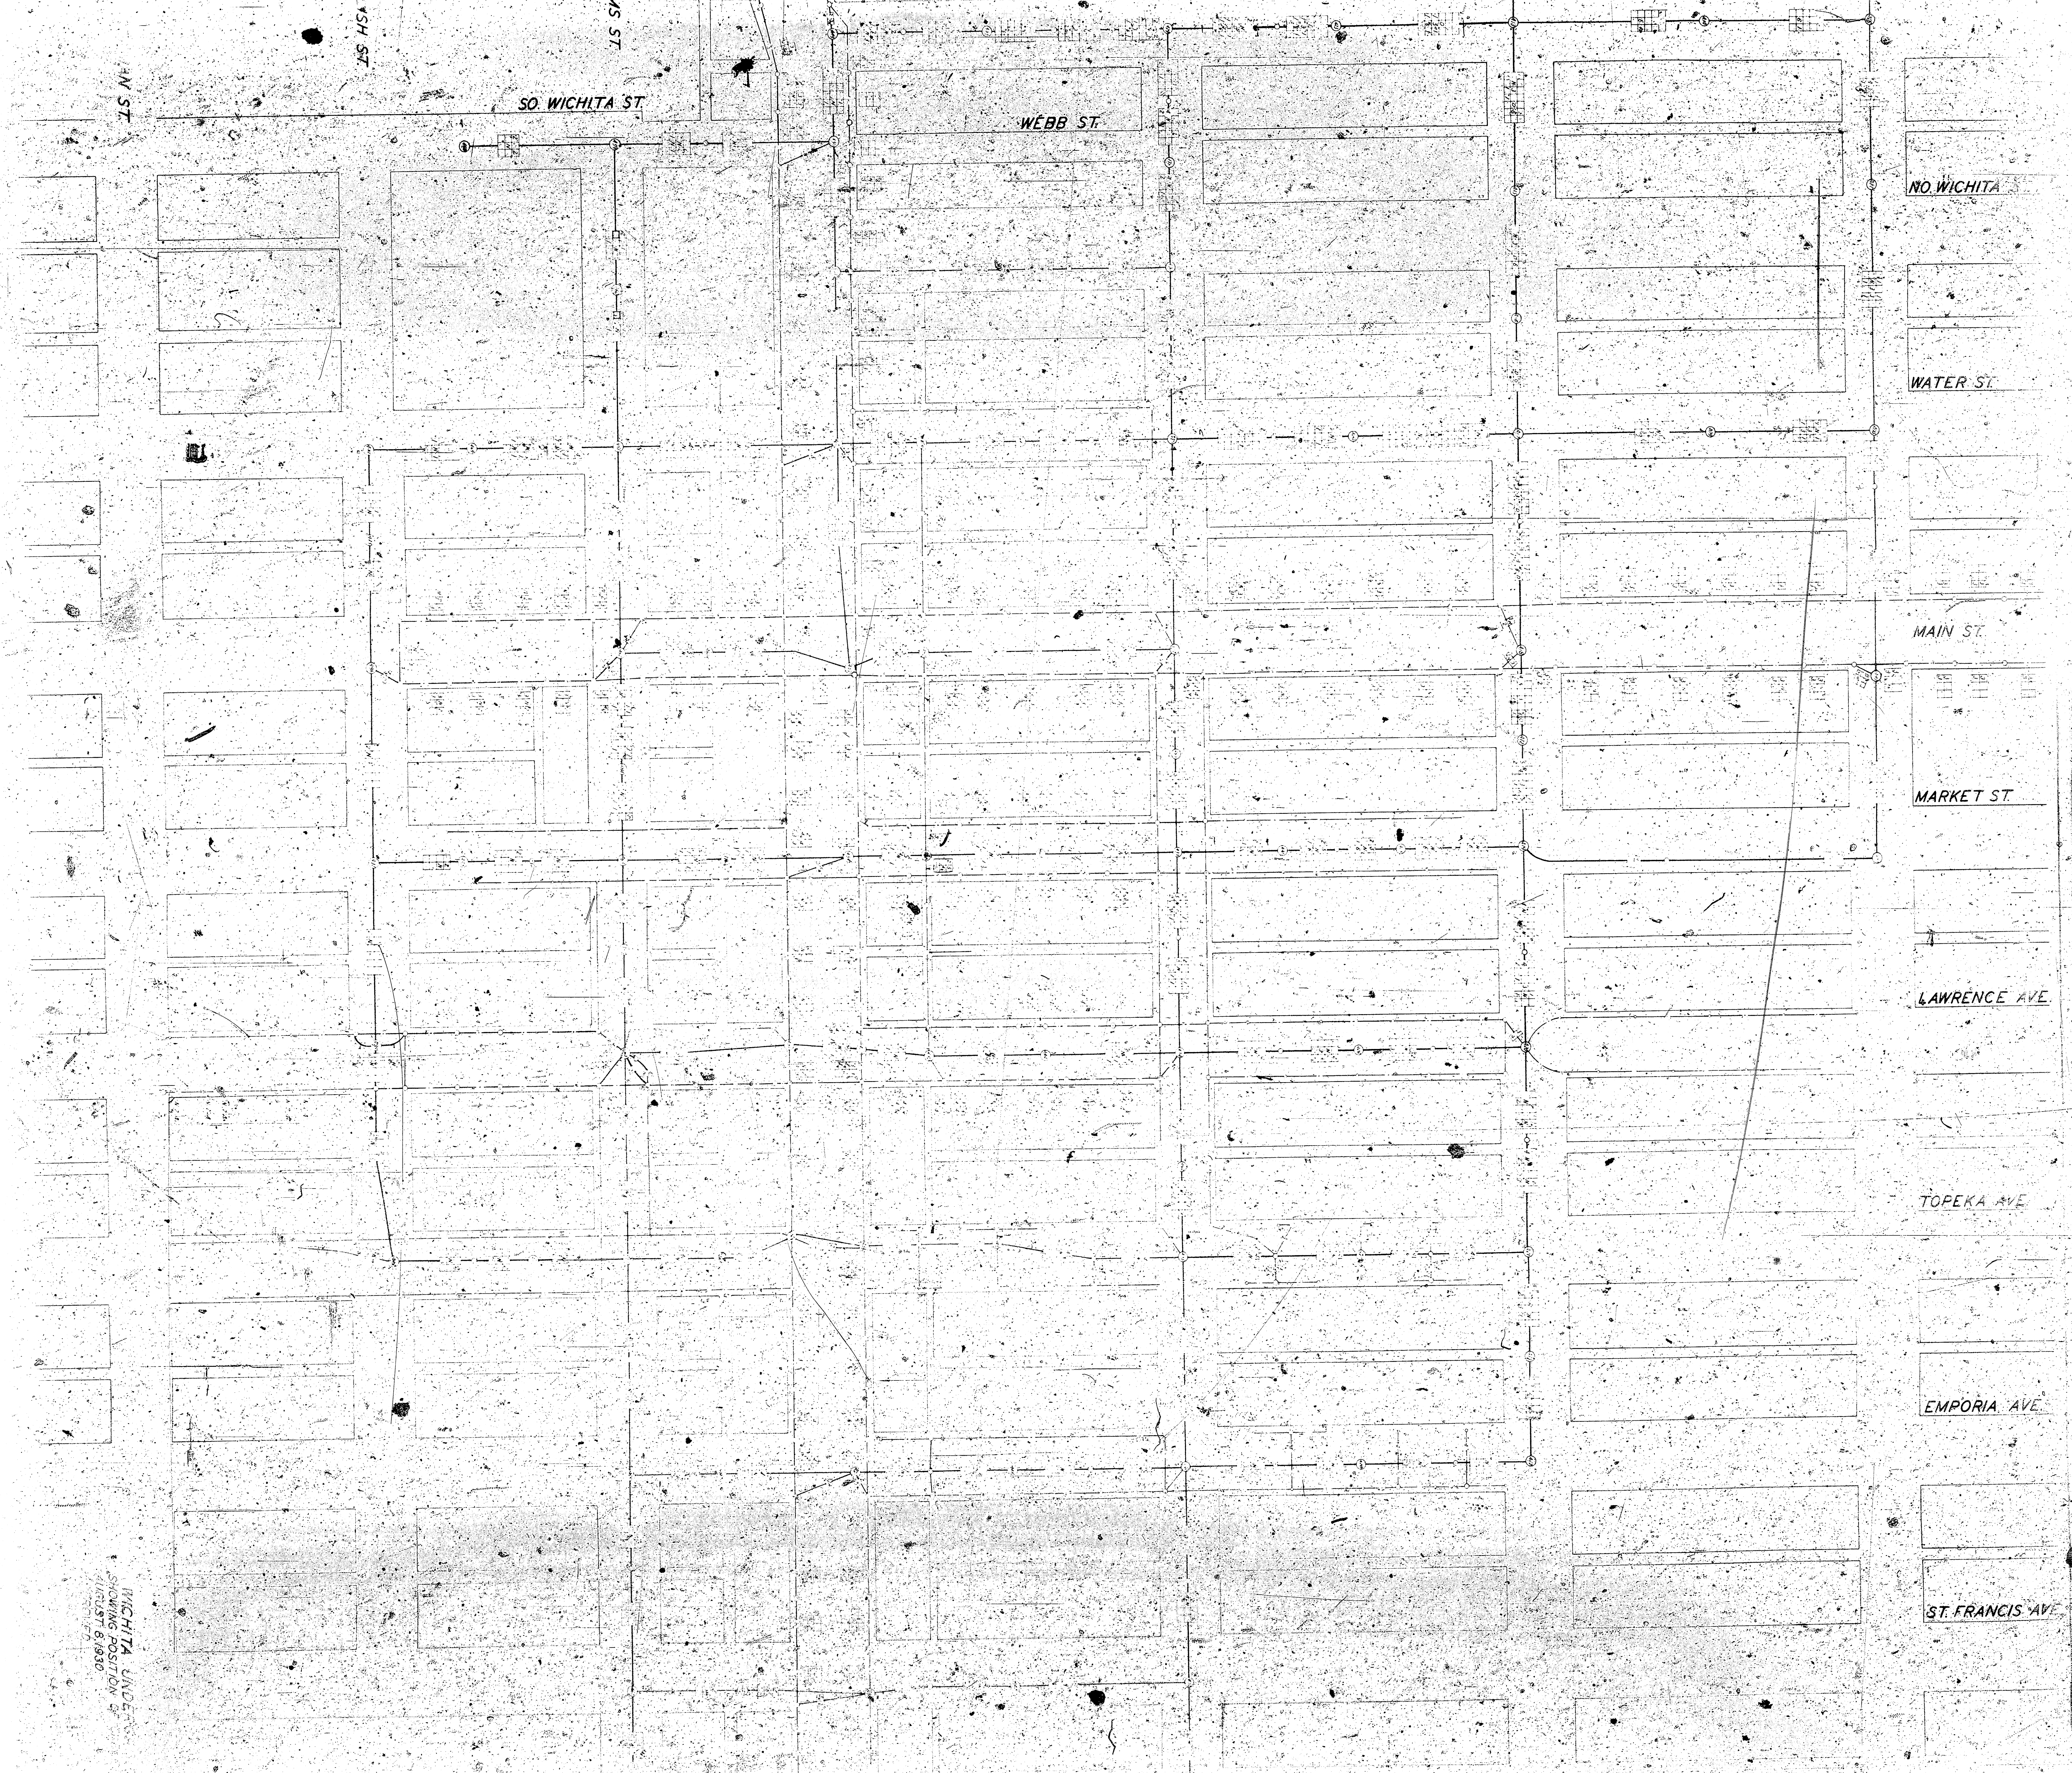

WICHITA, KANSAS
SHOWING POSITION OF
AUGUST 8, 1930

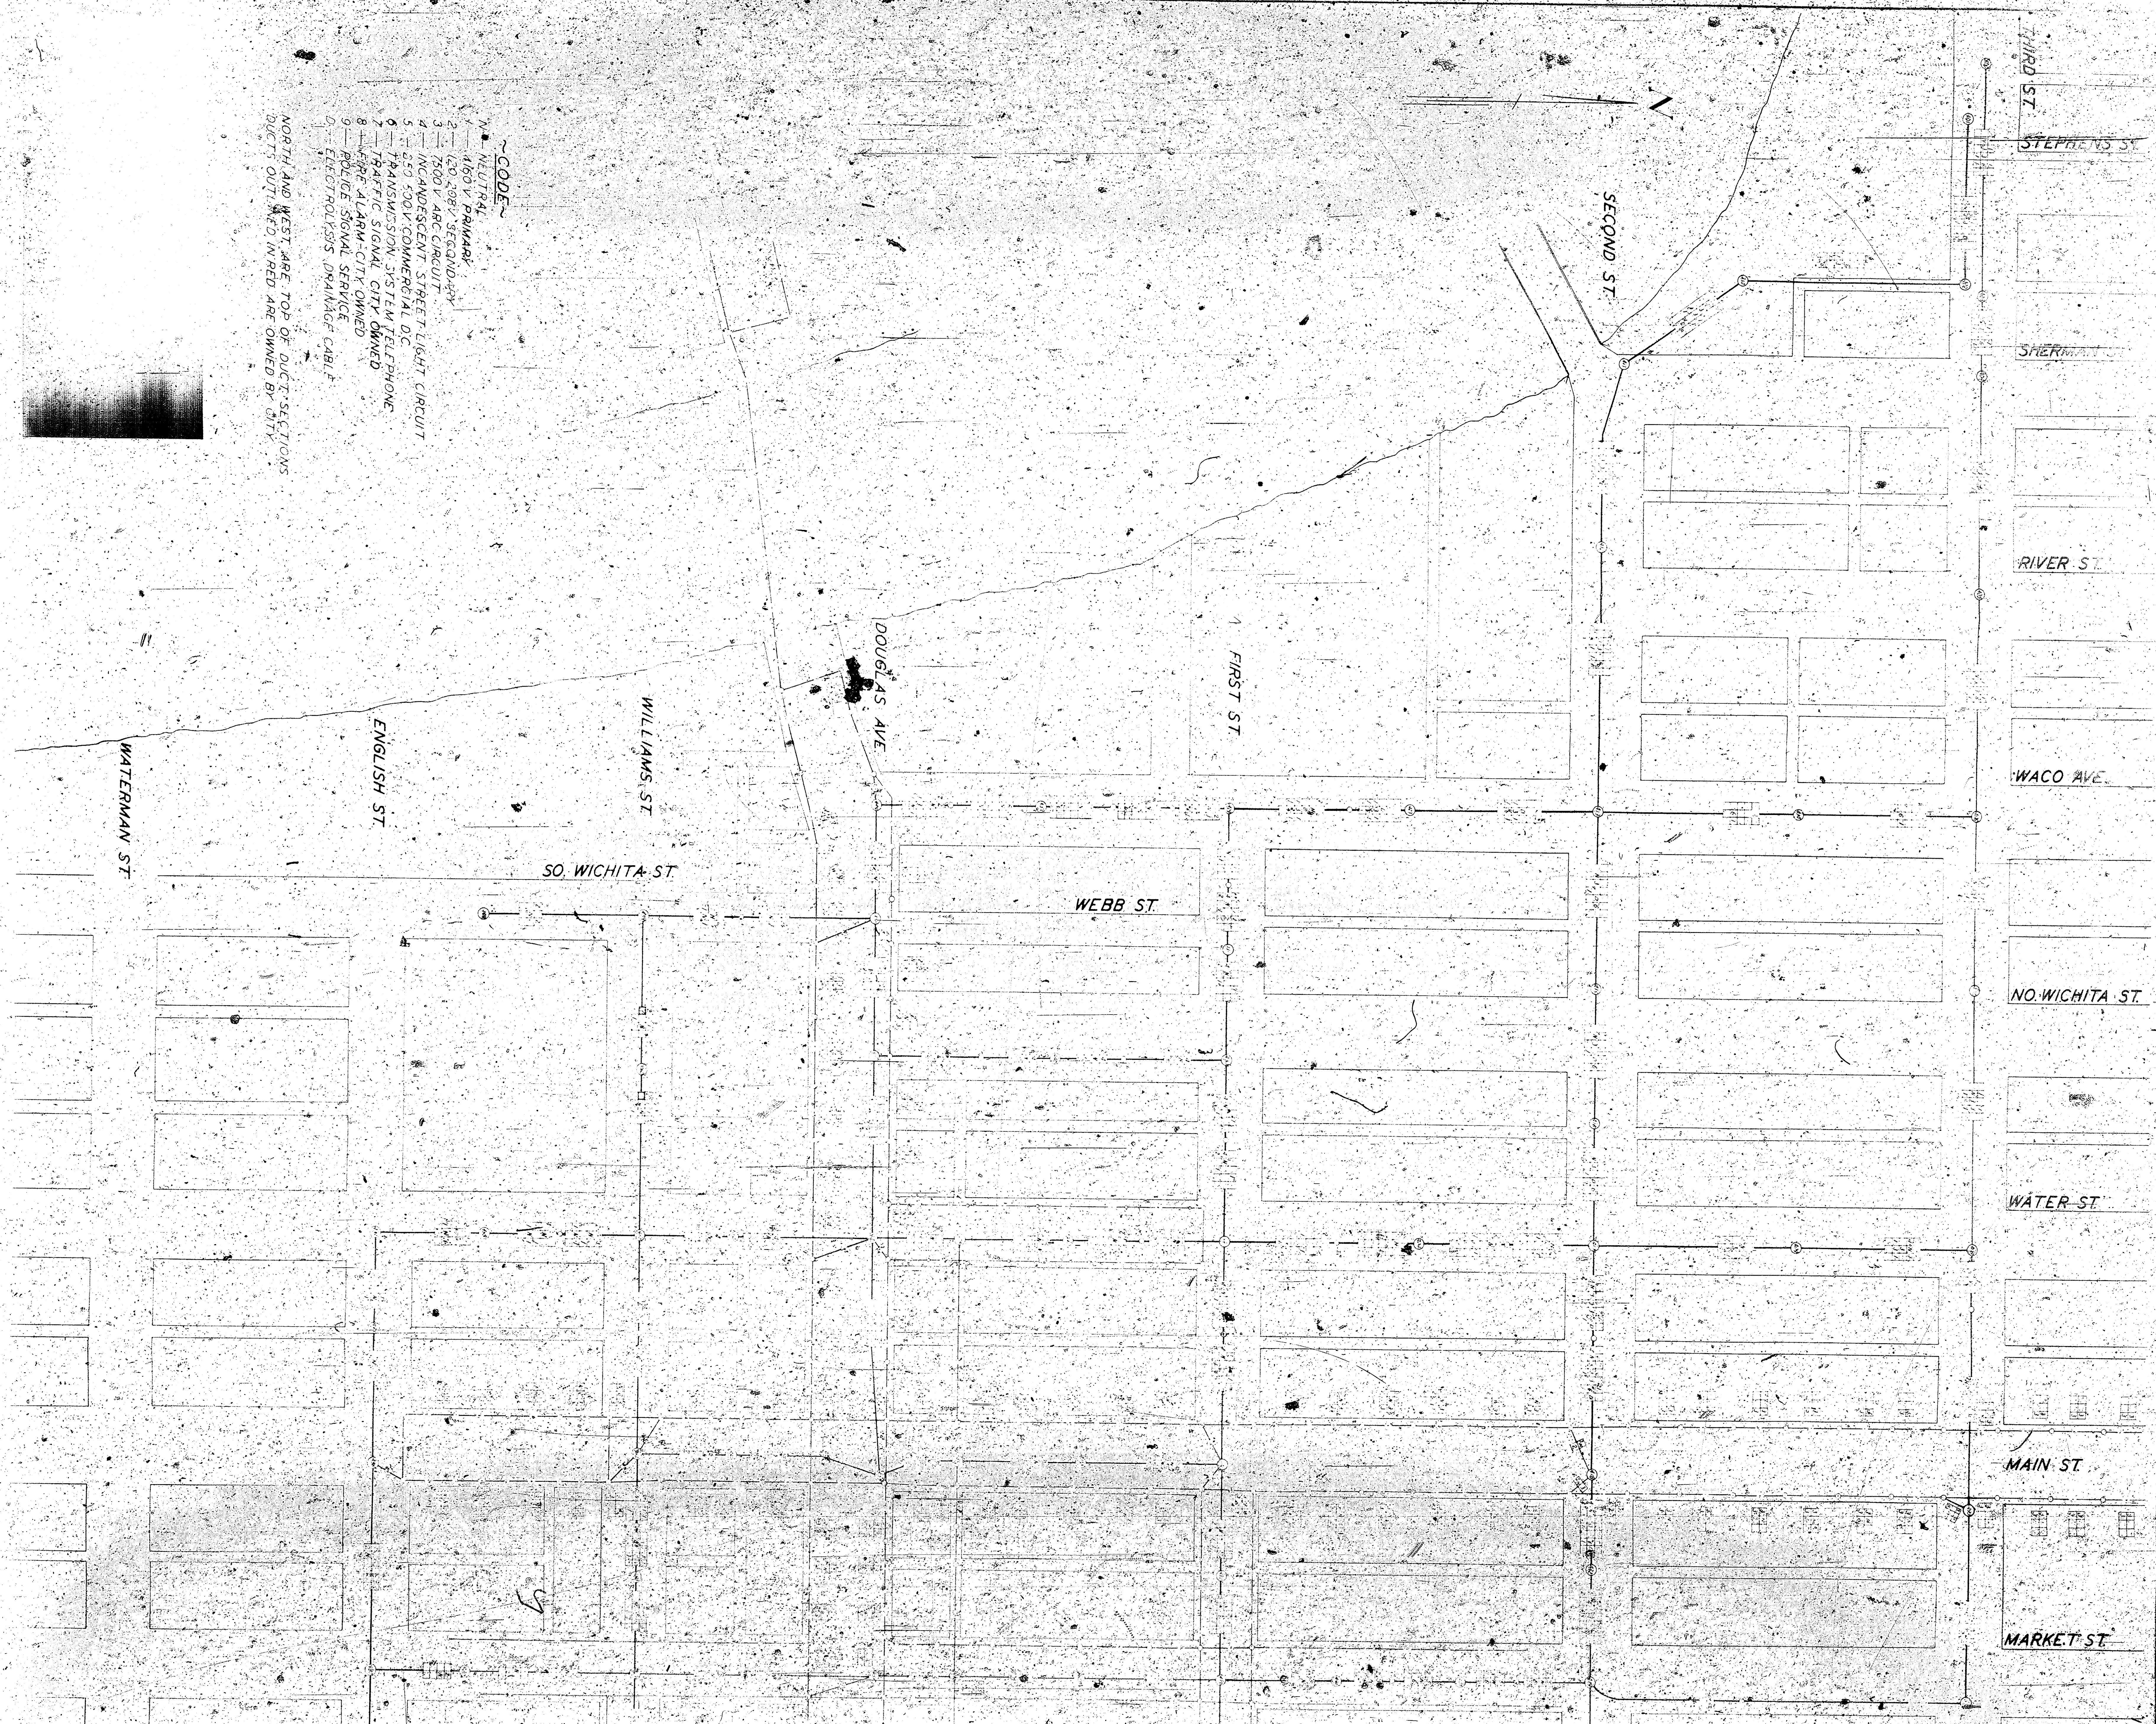

~CODE~
 1. ~UTILITY~
 2. 110V PRIMARY
 3. 120, 208V SECONDARY
 4. 1500V ARC CIRCUIT
 5. INCANDESCENT STREET LIGHT CIRCUIT
 6. 550 100V COMMERCIAL DC
 7. TRANSMISSION SYSTEM TELEPHONE
 8. TRAFFIC SIGNAL CITY OWNED
 9. TRAFFIC SIGNAL CITY OWNED
 10. POLICE SIGNAL SERVICE
 11. ELECTROLYSIS DRAINAGE CABLE
 NORTH AND WEST ARE TOP OF DUCT SECTIONS
 DUCTS OUT AND IN RED ARE OWNED BY CITY

ST. FRANCIS AVE

WEBB ST

WICHITA UNDERGROUND
SHOWING POSITION OF CAB-111
AUGUST 8, 1930.
APPROVED
KANSAS GAS AND ELECTRIC CO.

DESIGNED BY: *BOA* 8-8-30
CHECKED BY: *BOA* 8-8-30

- CODE
N — NEUTRAL
1 — 460 V. PRIMARY
2 — 120 208V SECONDARY
3 — 7500 V. ARC CIRCUIT
4 — INCANDESCENT STREET LIGHT CIRCUIT
5 — 250 500V COMMERCIAL D.C.
6 — TRANSMISSION SYSTEM TELEPHONE
7 — PRACTIC. SIGNAL CITY OWNED
8 — FIRE ALARM CITY OWNED
9 — POLICE SIGNAL SERVICE

NORTH AND WEST ARE TOP OF DUCT SECTIONS
DUCTS OUTLINED IN RED ARE OWNED BY CITY

