



REVISED AS TO	SOURCE	DATE	DRAFTSMAN
Photo: King Stan	331516 1532-B	12-31-39	J. A. Wolfgram
Reg. Ltr. NO 235-C, BR. NO. 33A	331014 1537-B	1-34-39	A. G. Stevenson
with Ltr. BR. NO. 150, T. BR. 3398			
A. V. T. & Conn Relocated	331715 1537-B	9-34-39	A. G. Stevenson

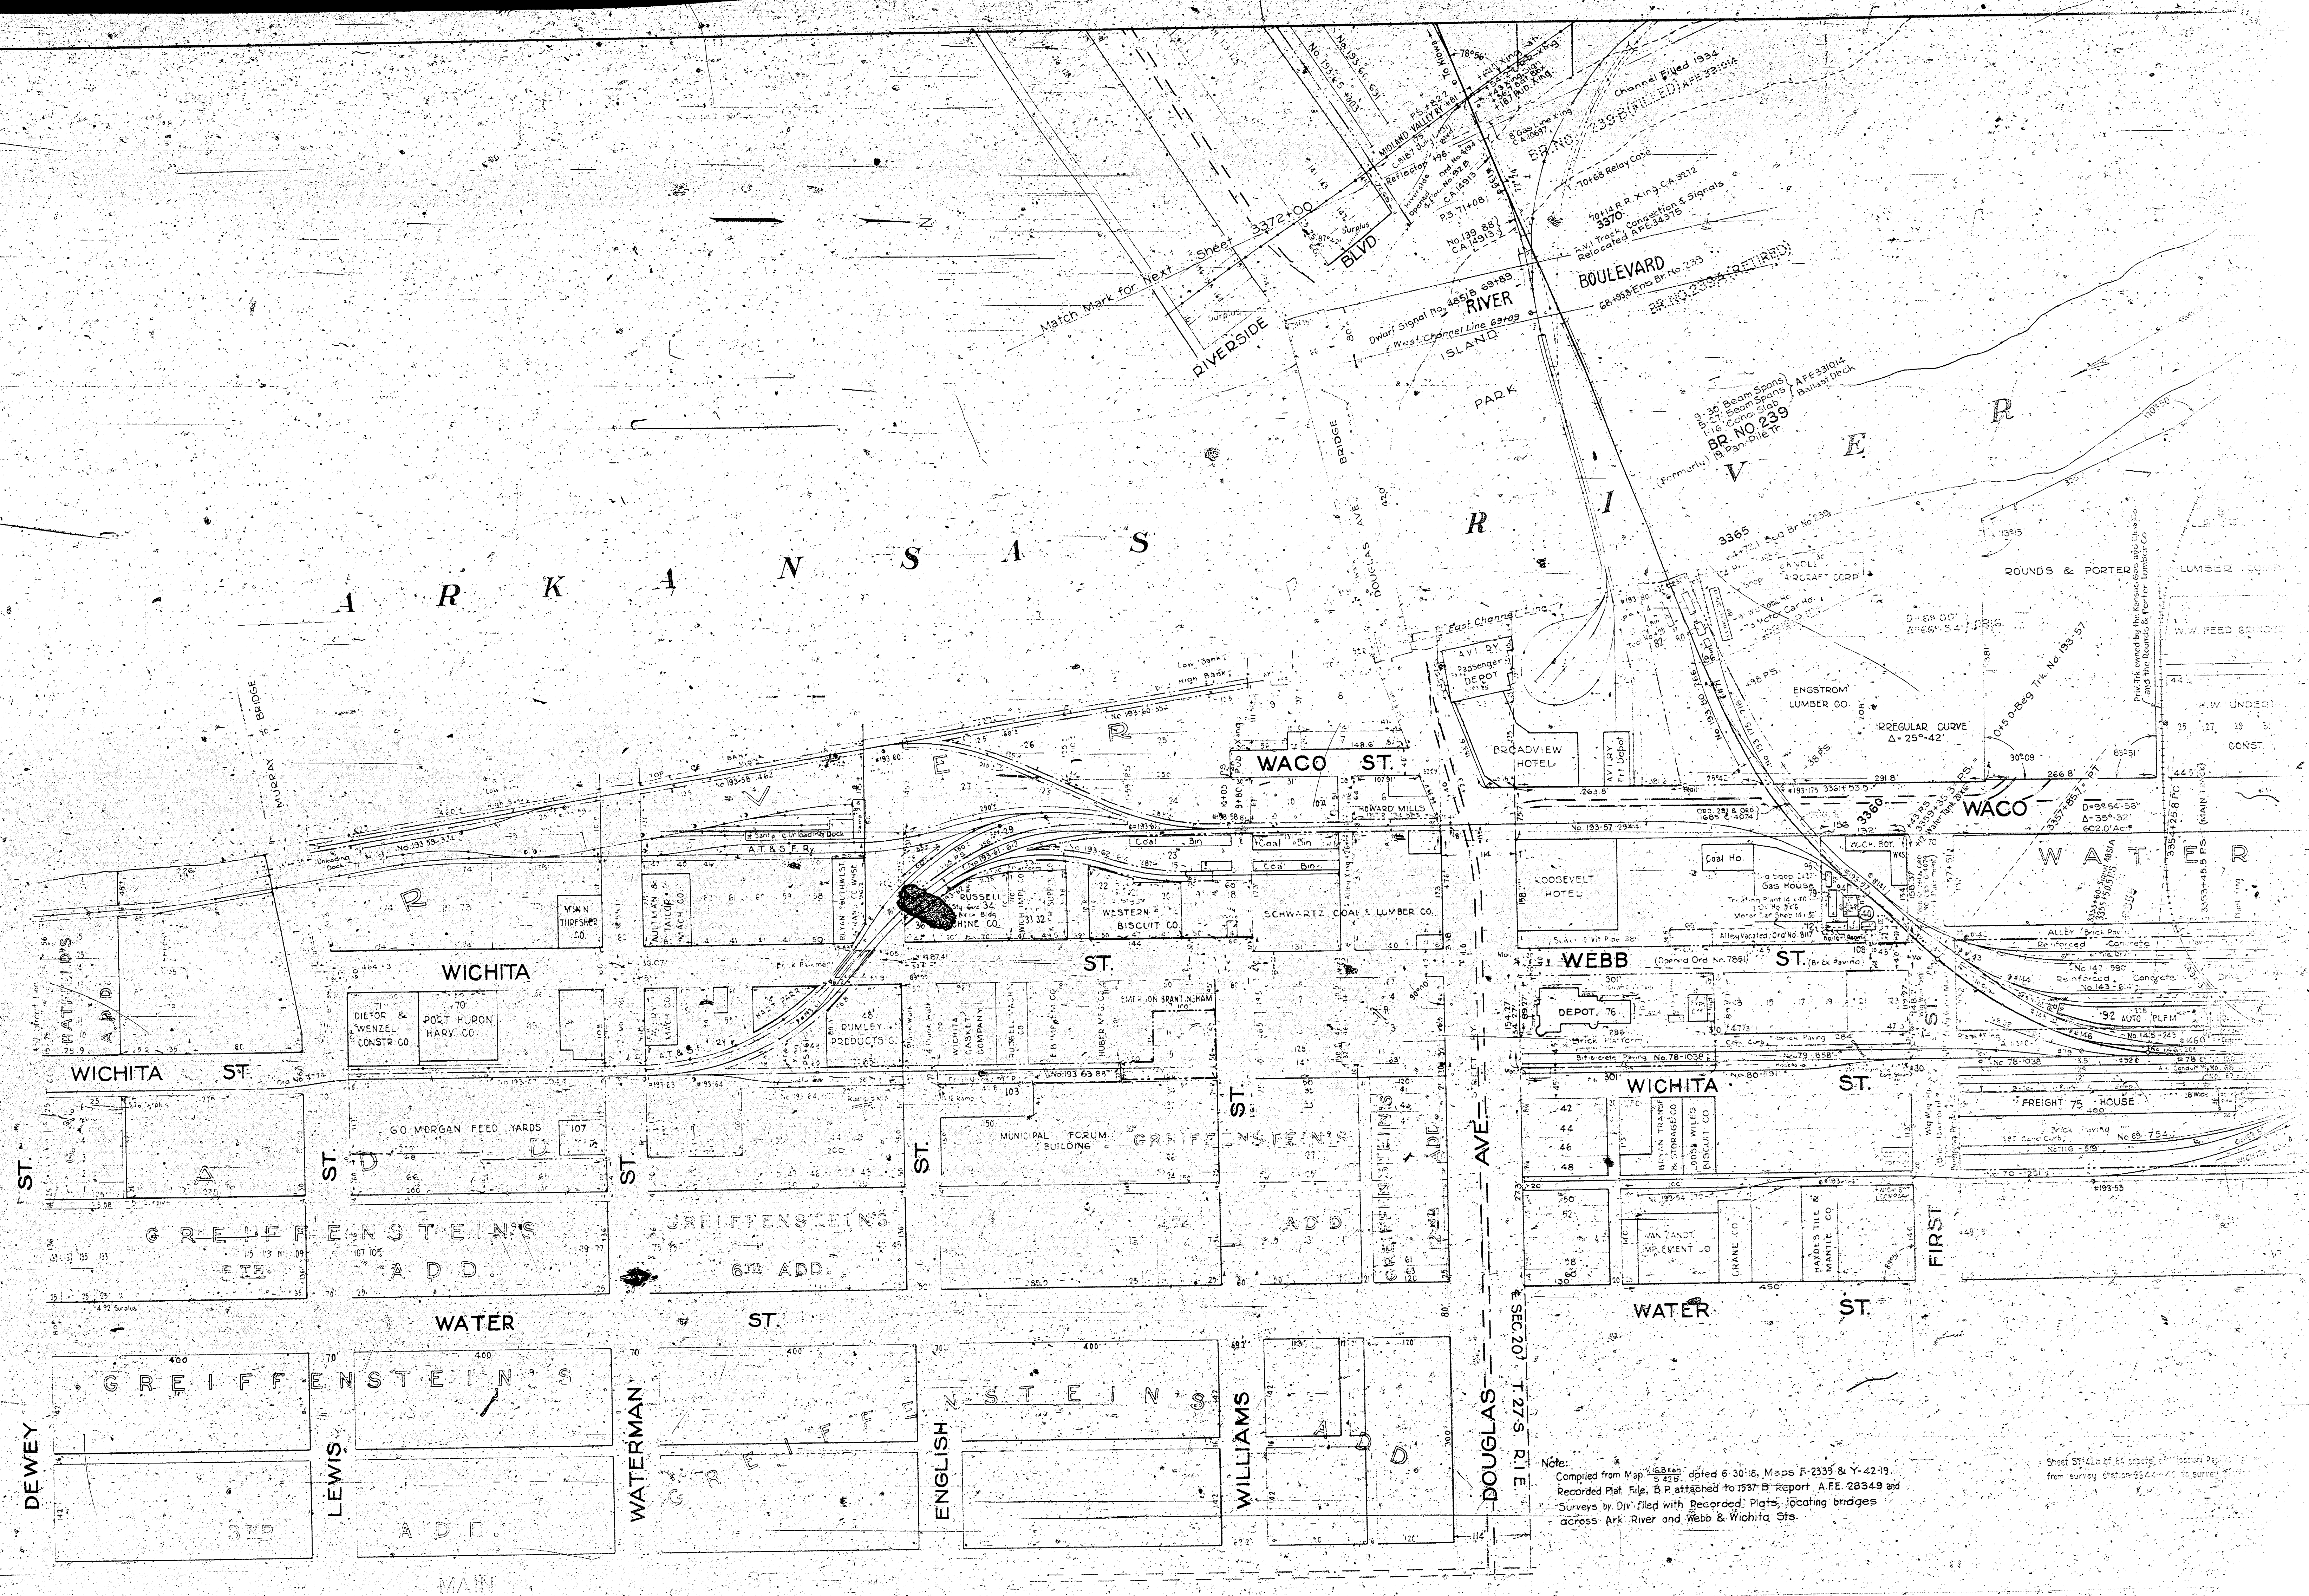

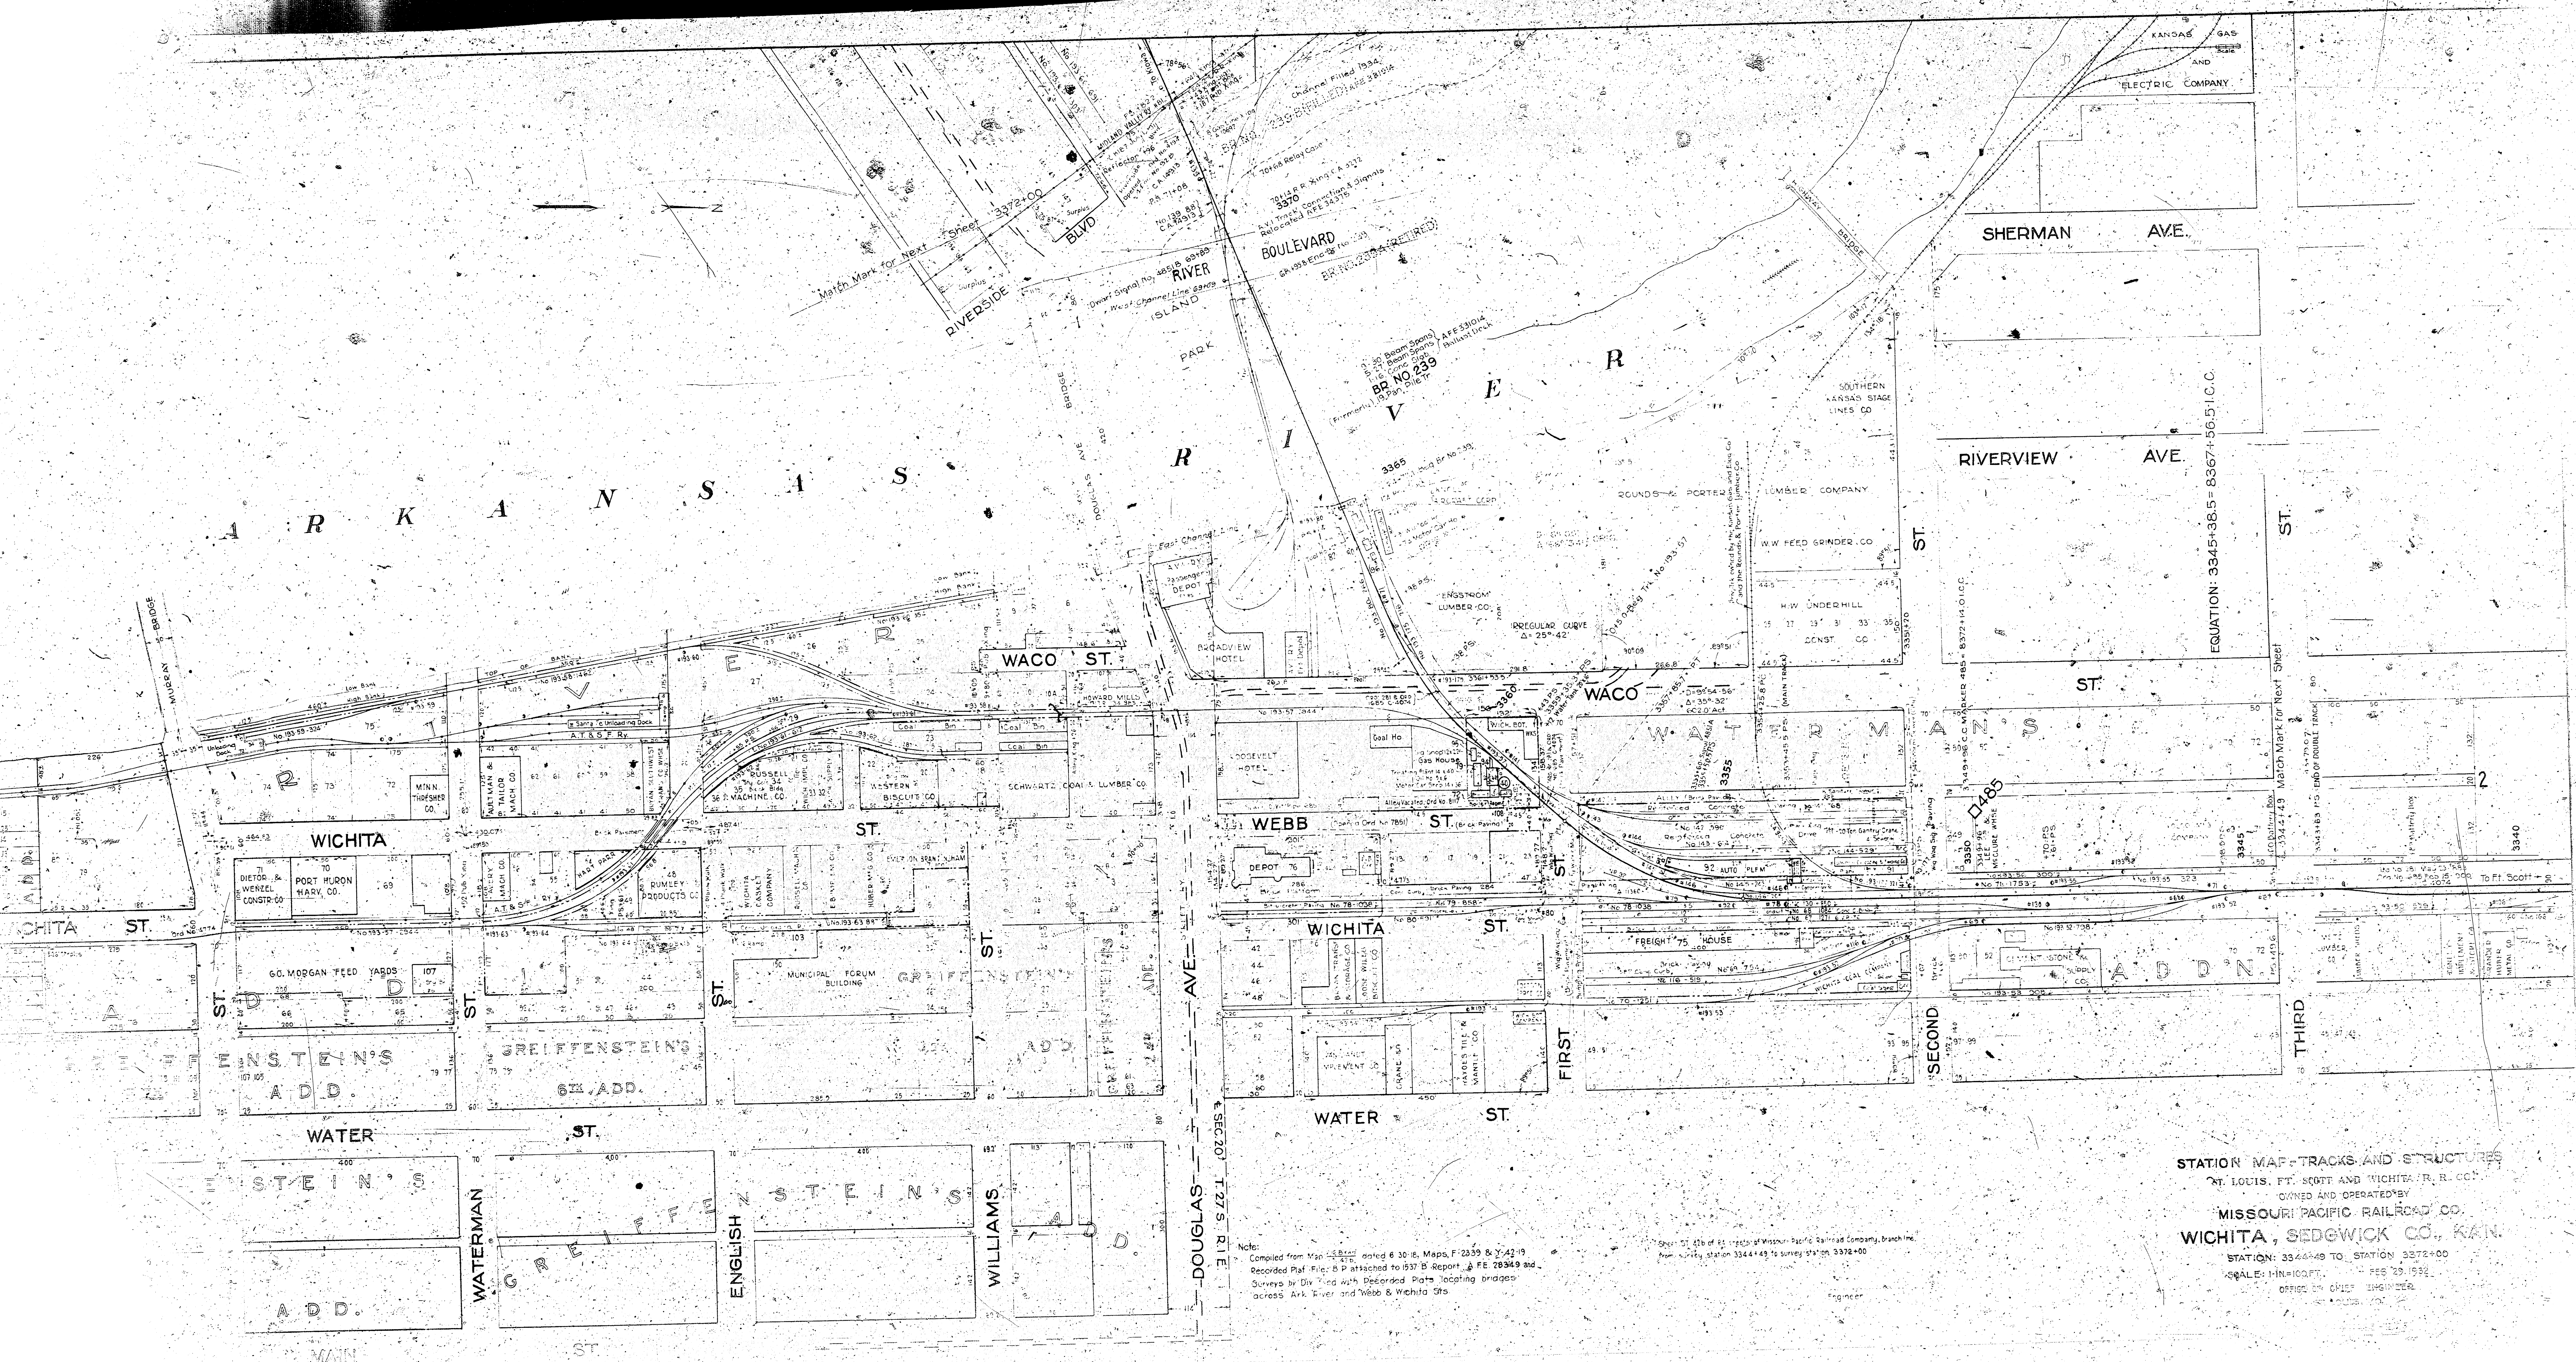

STATION MAP - TRACKS AND STRUCTURES
ST. LOUIS, FT. SCOTT AND WICHITA, R. R. CO.
OWNED AND OPERATED BY
MISSOURI PACIFIC RAILROAD CO.
WICHITA, SEDGWICK CO., KAN.
STATION: 3344+49 TO STATION 3372+00
SCALE: 1"=100 FT.
OFFICE OF CHIEF ENGINEER

Note:
Compiled from Map 1-3-37, dated 6-30-36, Maps F-2339 & Y-4219
Recorded Plat. File: B-P attached to 1937 B-Report, & FE 20349 and
Surveys by Div. 1 and 2, with Recorded Plats, including bridges
across Ark. River and Webb & Wichita R.R.

Sheet 17, 18 of 25, Map of Wichita, Kansas, showing
the location of the station 3344+49 to station 3372+00
Engineer