





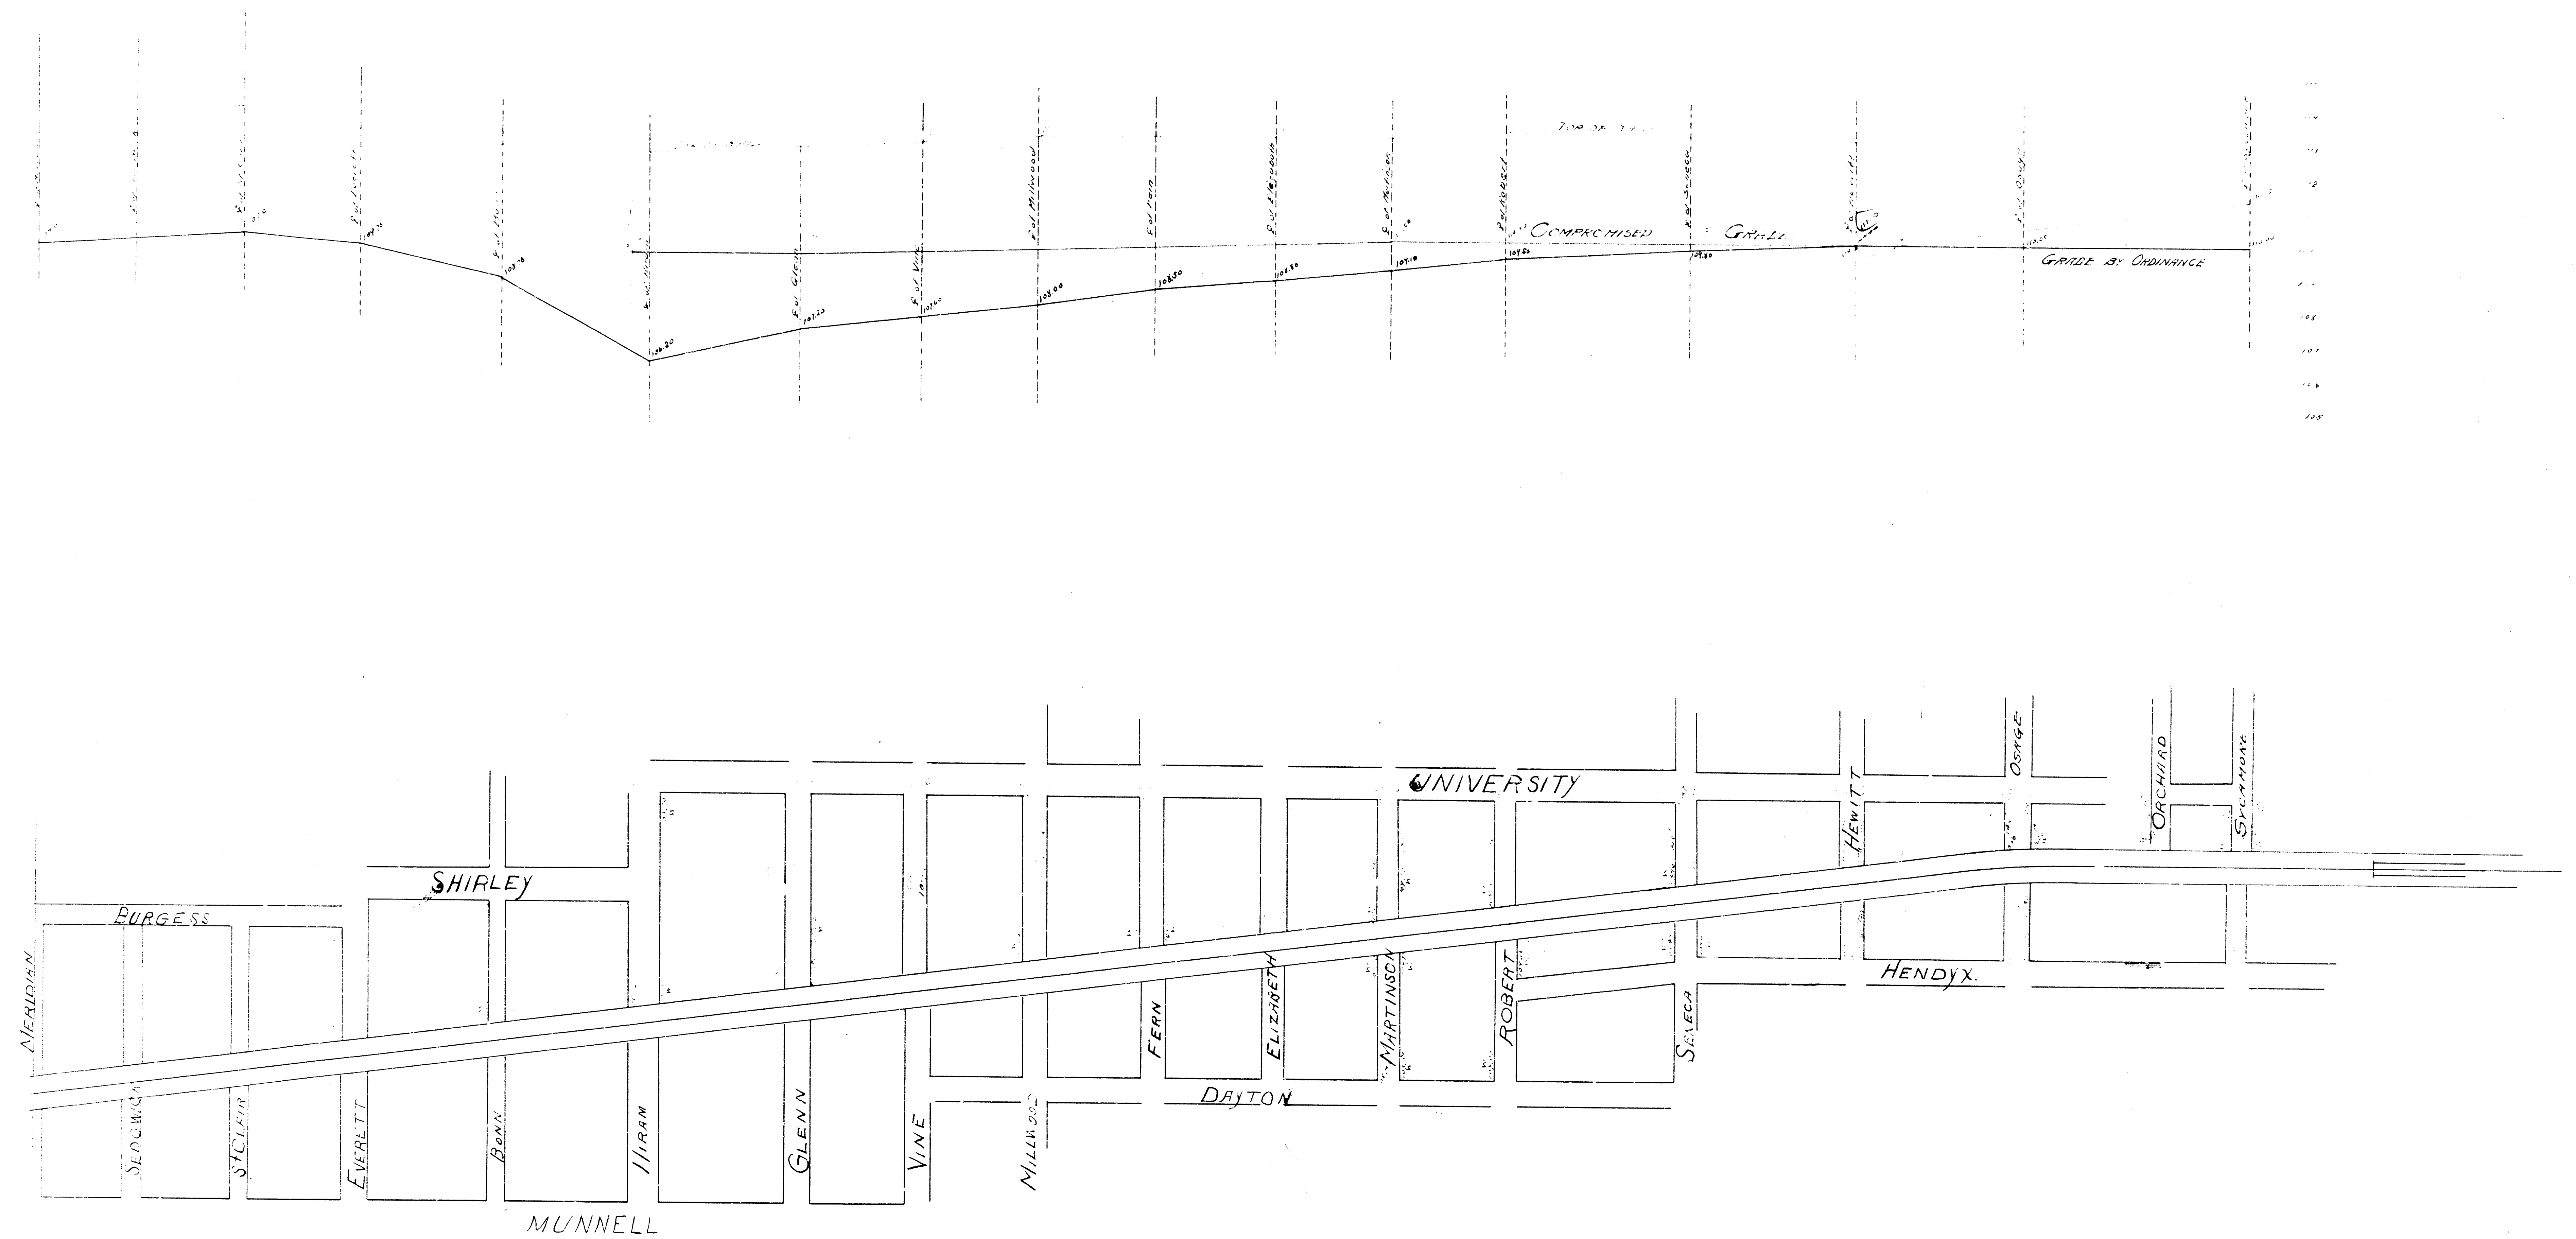

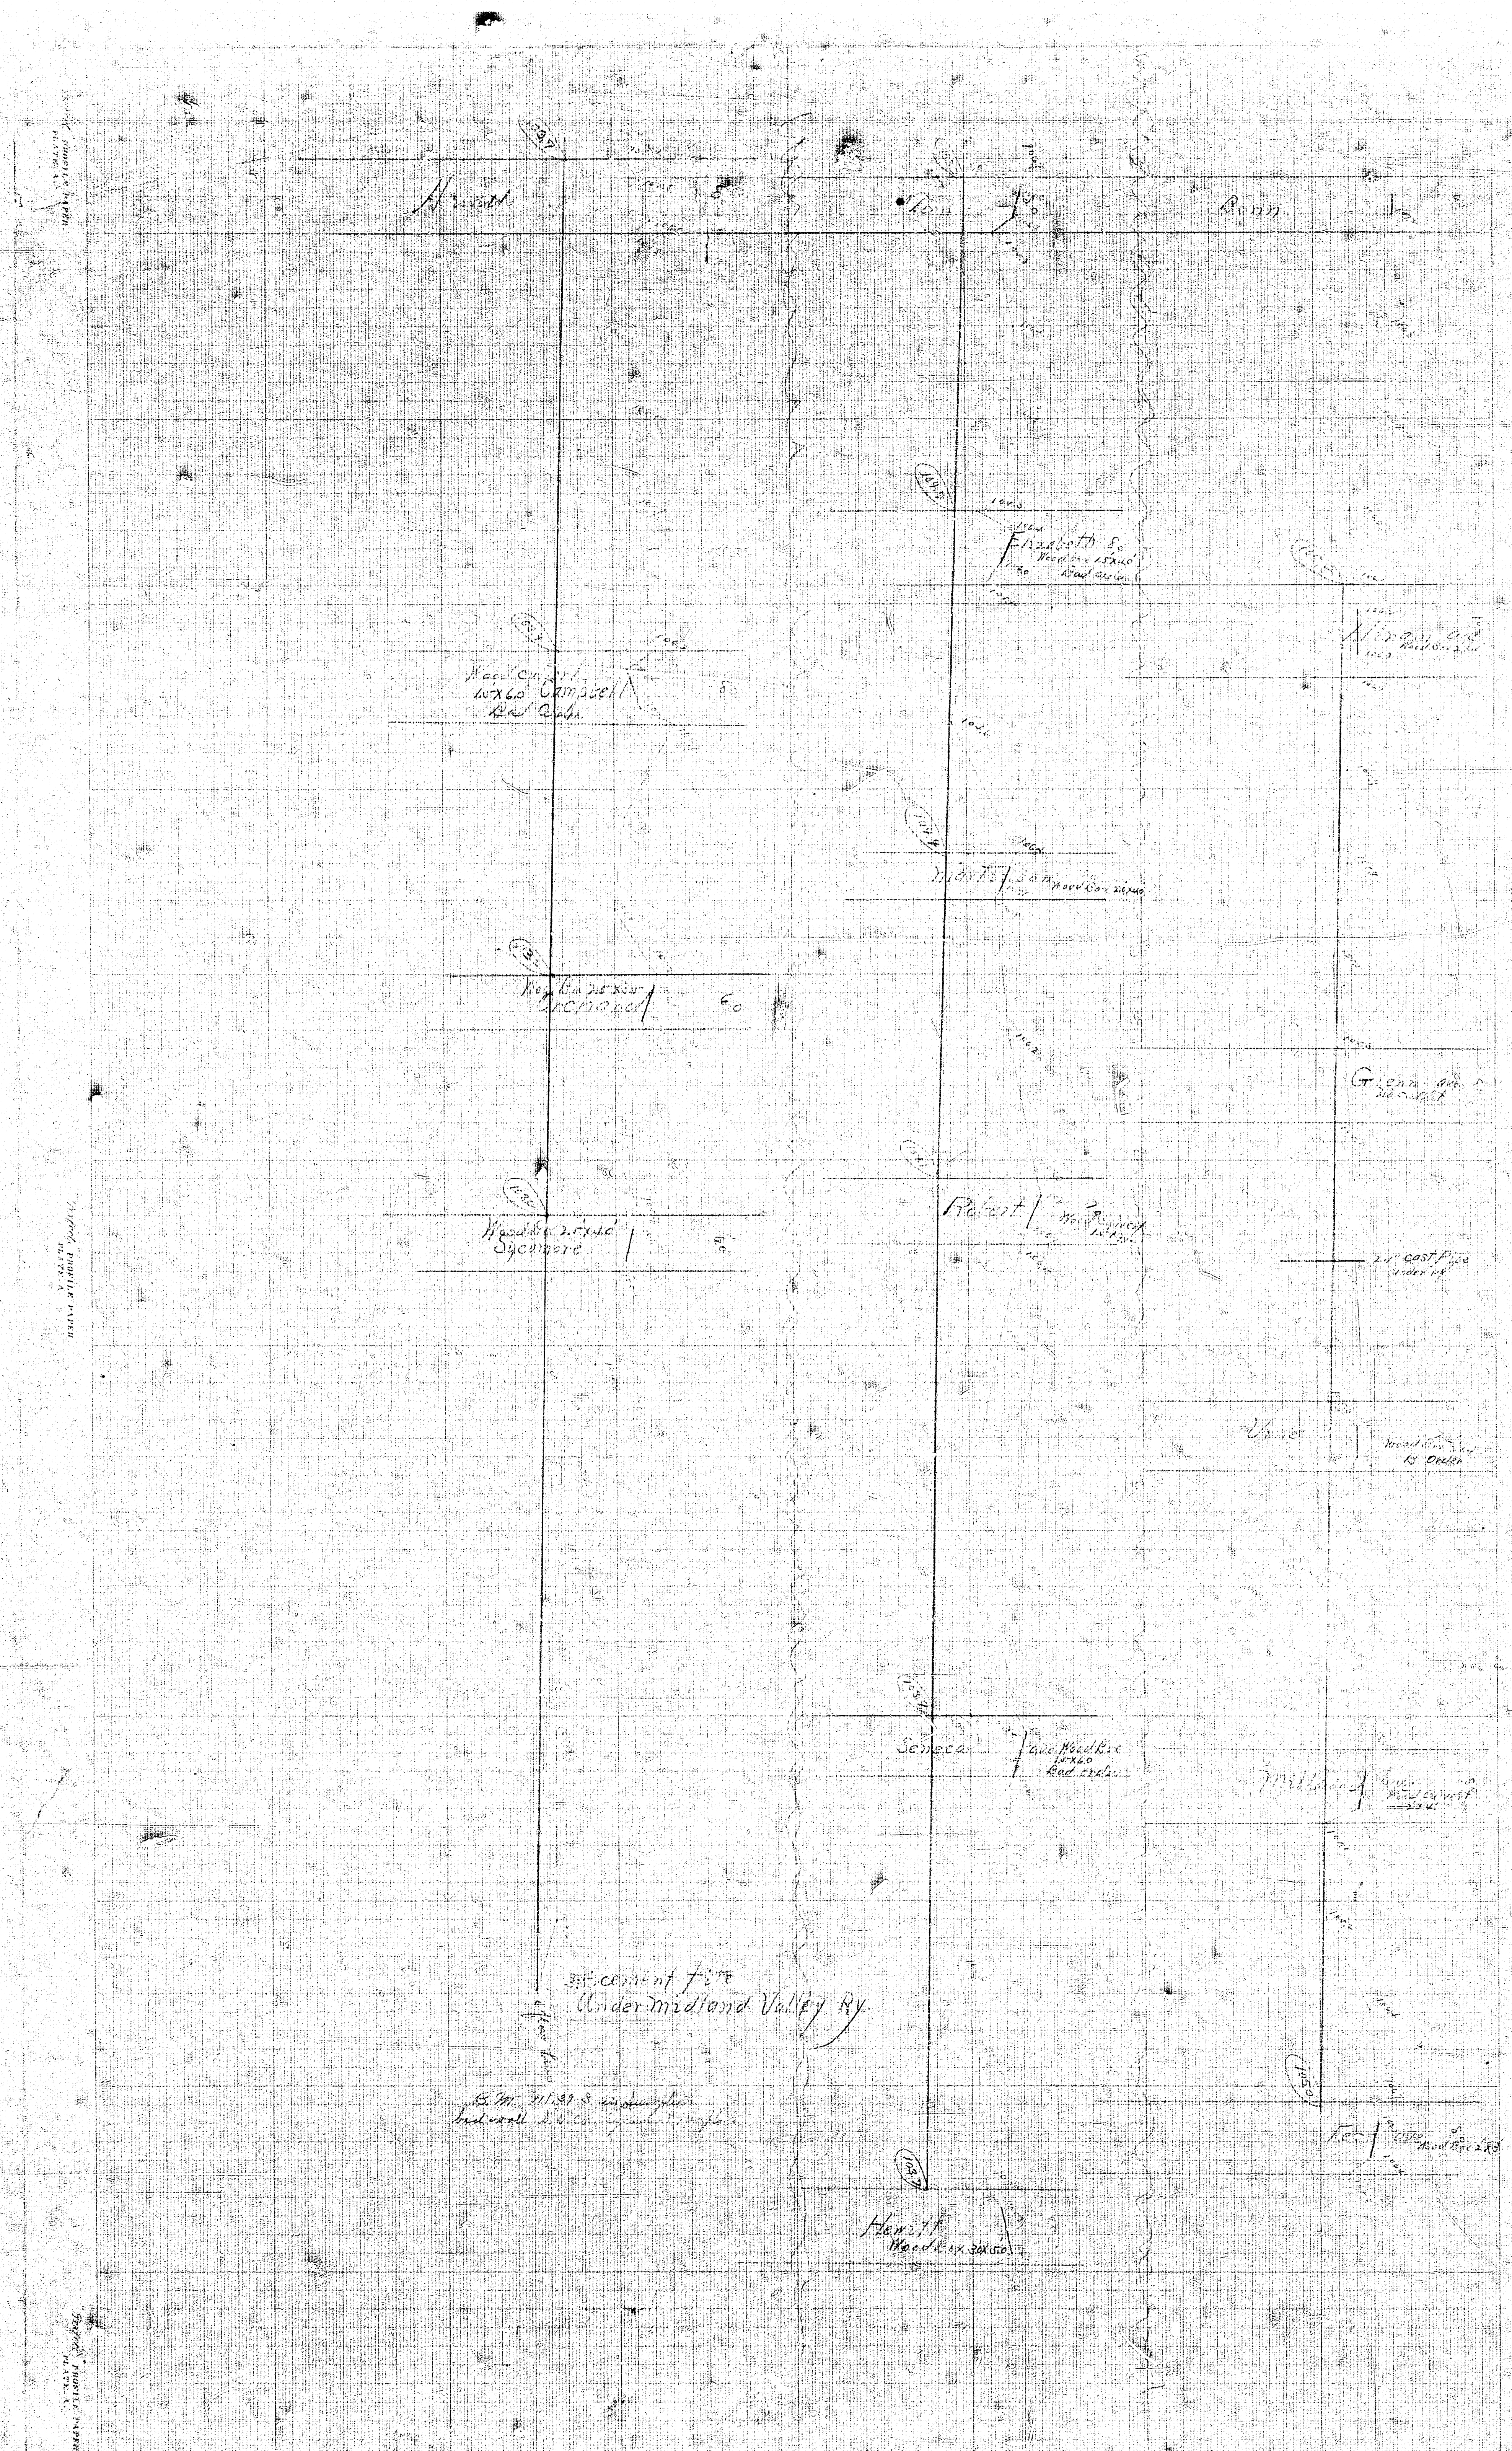

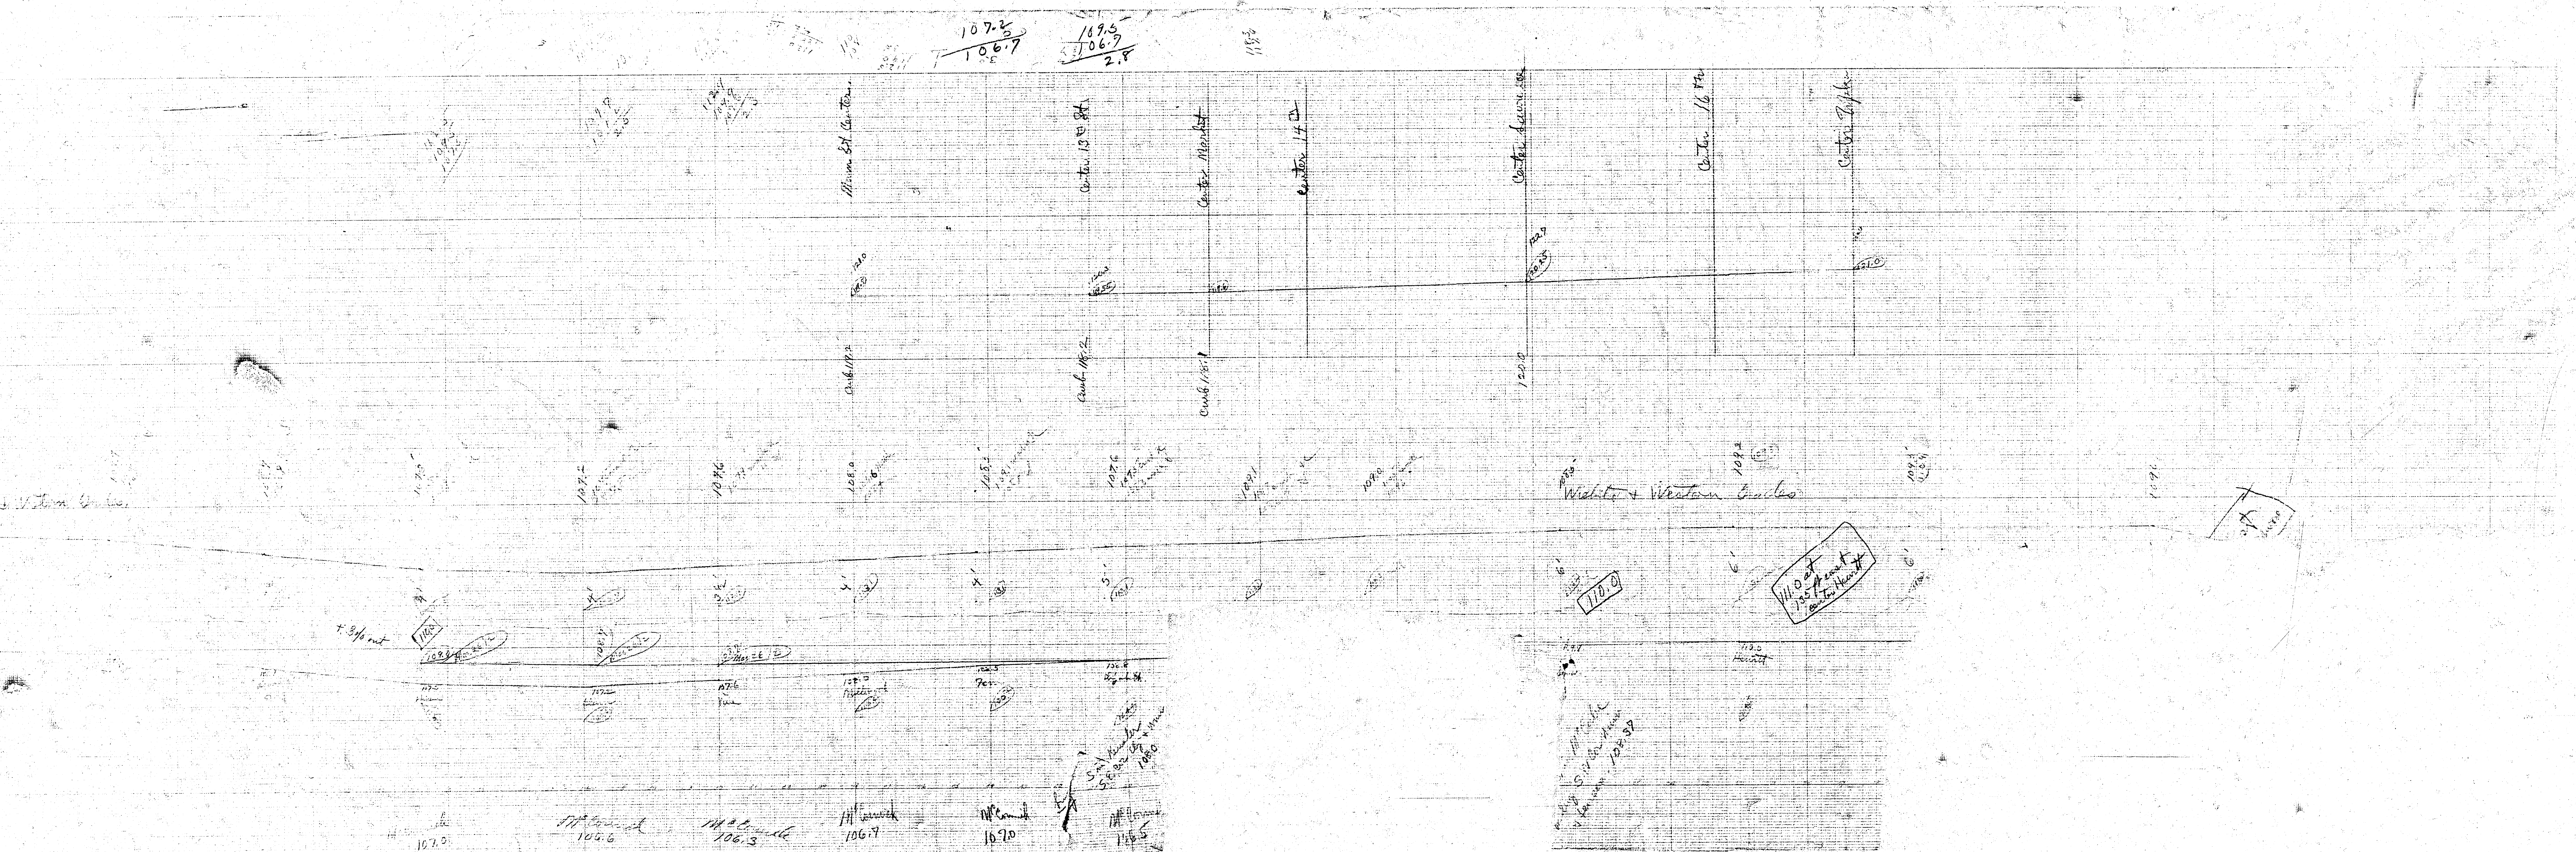

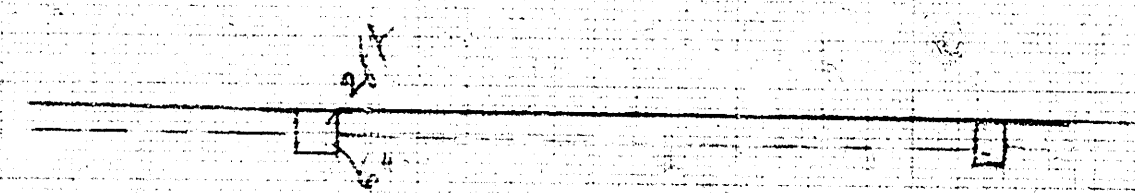

12' 1/2 ft
12' 1/2 ft
6' 1/2 ft

125

115

109.5

109.0

108.5

108.0

107.5

107.0

106.5

106.0

105.5

105.0

104.5


104.0

103.5

103.0



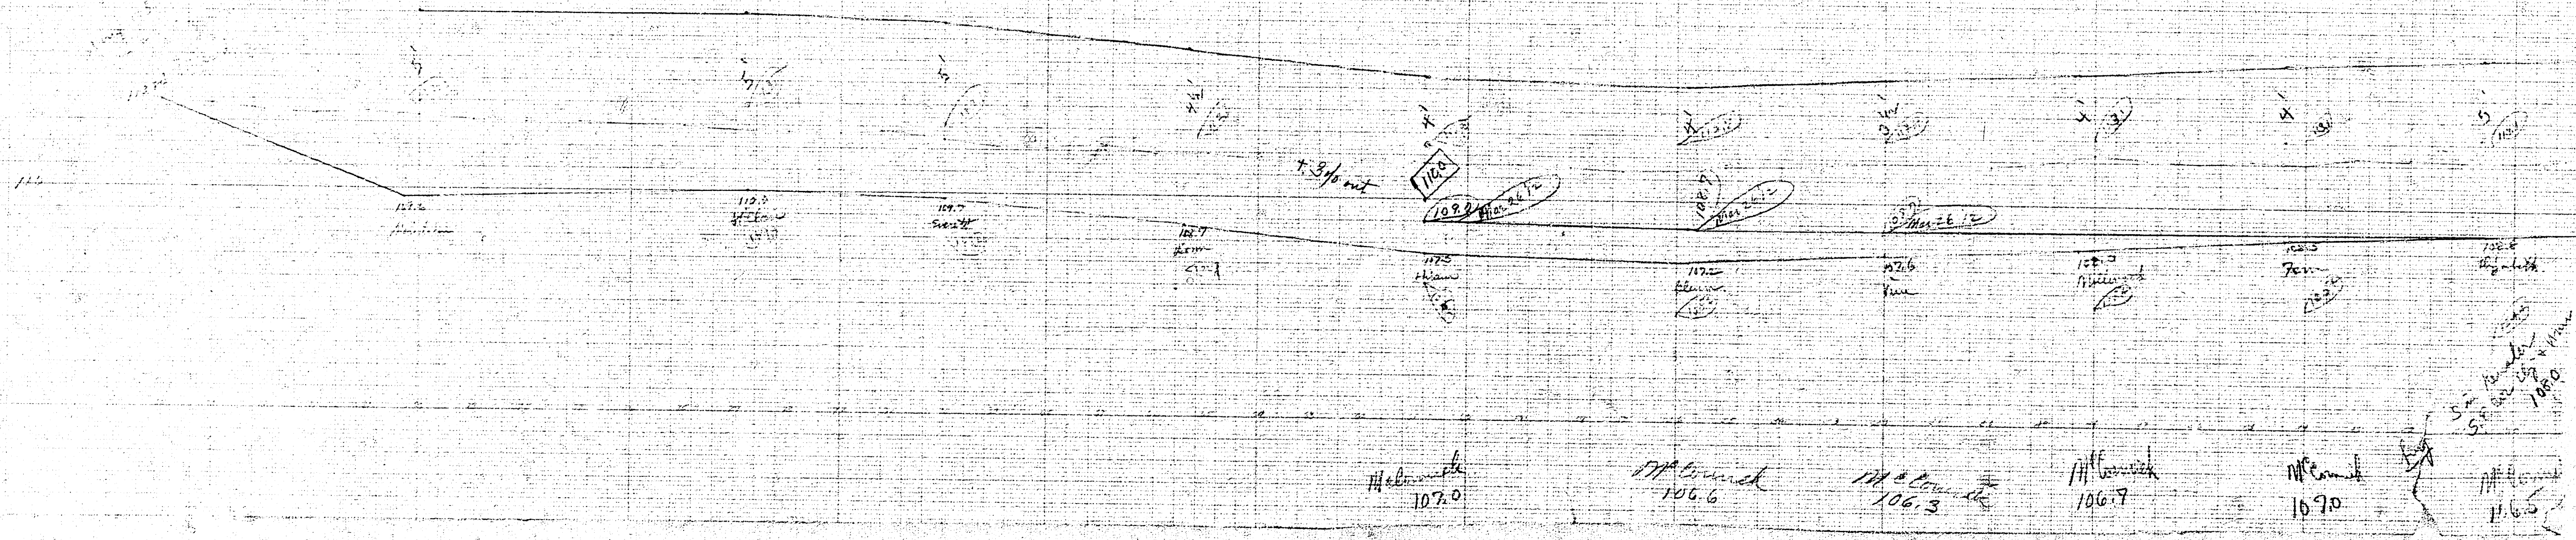

107.0

106.6

106.3

106.7

107.0

106.5

106.0

106.5