=Pl 134.19 S.W. cor. conc. porch to N.E. cor. Fountain & Blake

NOTE: Sta. on 9' offset S. of N.R. 0+00 to 1+54.37
& on N.R. 1+54.37 to 7+18.59
Grades set on cb. line distances.

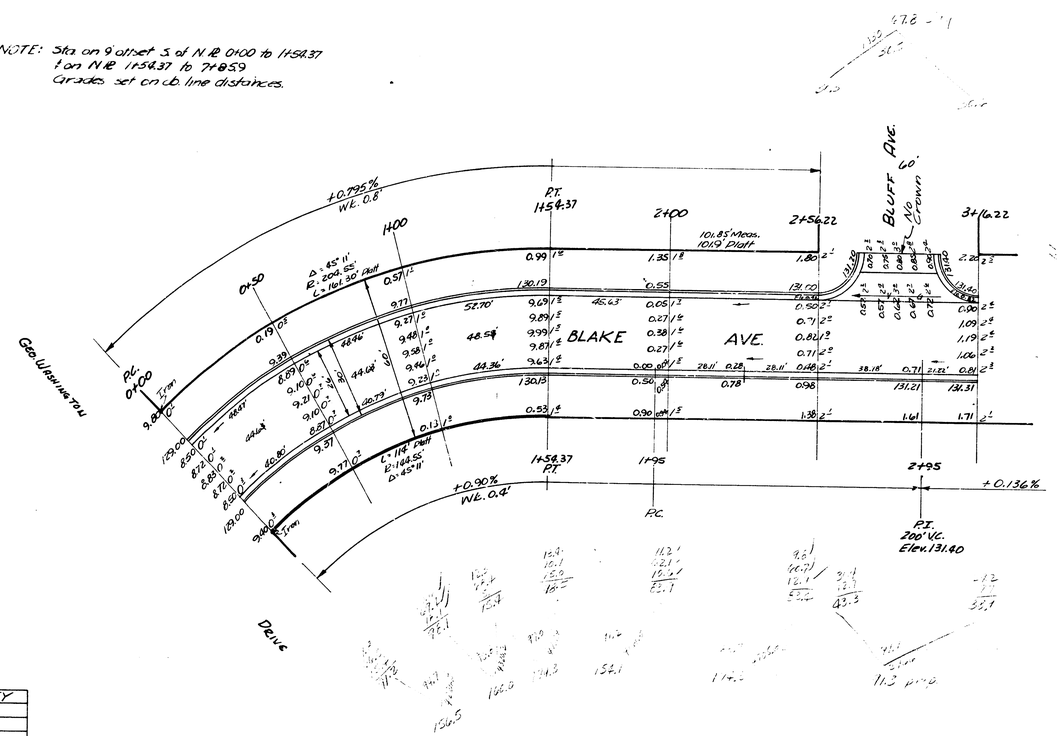


1" = 20'

B. E. SMITH
LICENSED
436
KANSAS
PROFESSIONAL ENGINEER

BLAKE AVE.
E.L. GEO. WASH. DR. TO E.L. MURRY'S 2ND.
26-2-30 A.C.

CITY OF WICHITA, KANSAS
B.E. SMITH — CITY ENGINEER
JAN. 21, 1953 — PROJ. NO. C12-211

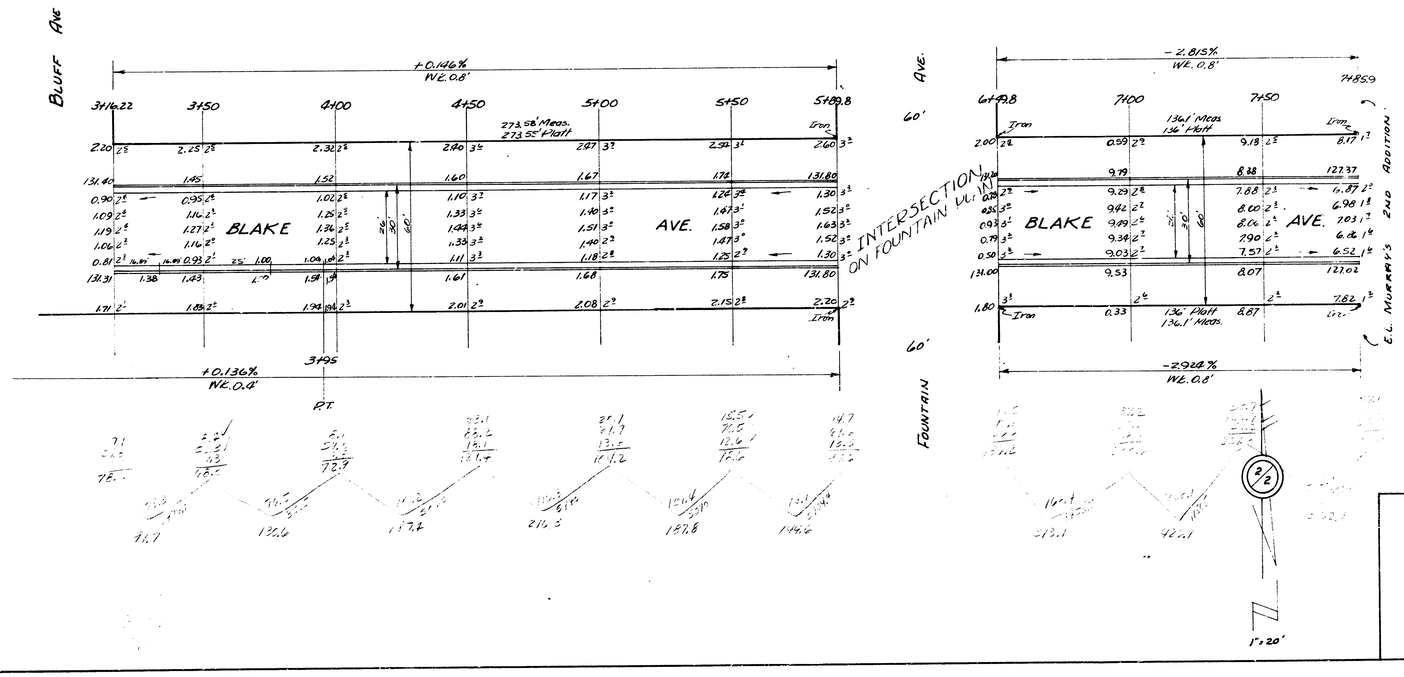
BLUFF AVE
+0.146%
WE. 0.8'
3+16.22
3+50
4+00
4+50
5+00
5+50
5+89.8
273.58' Meas.
273.55' Platt
Iron
BLAKE
AVE.
INTERSECTION ON FOUNTAIN
+0.136%
WE. 0.4'
3+95
P.T.
FOUNTAIN AVE.
-2.815%
WE. 0.8'
6+49.8
7+00
7+50
74859
136.1' Meas.
136' Platt
-2.924%
WE. 0.8'
E.L. MURRAY'S 2ND ADDITION
1"=20'

BLAKE AVE.