



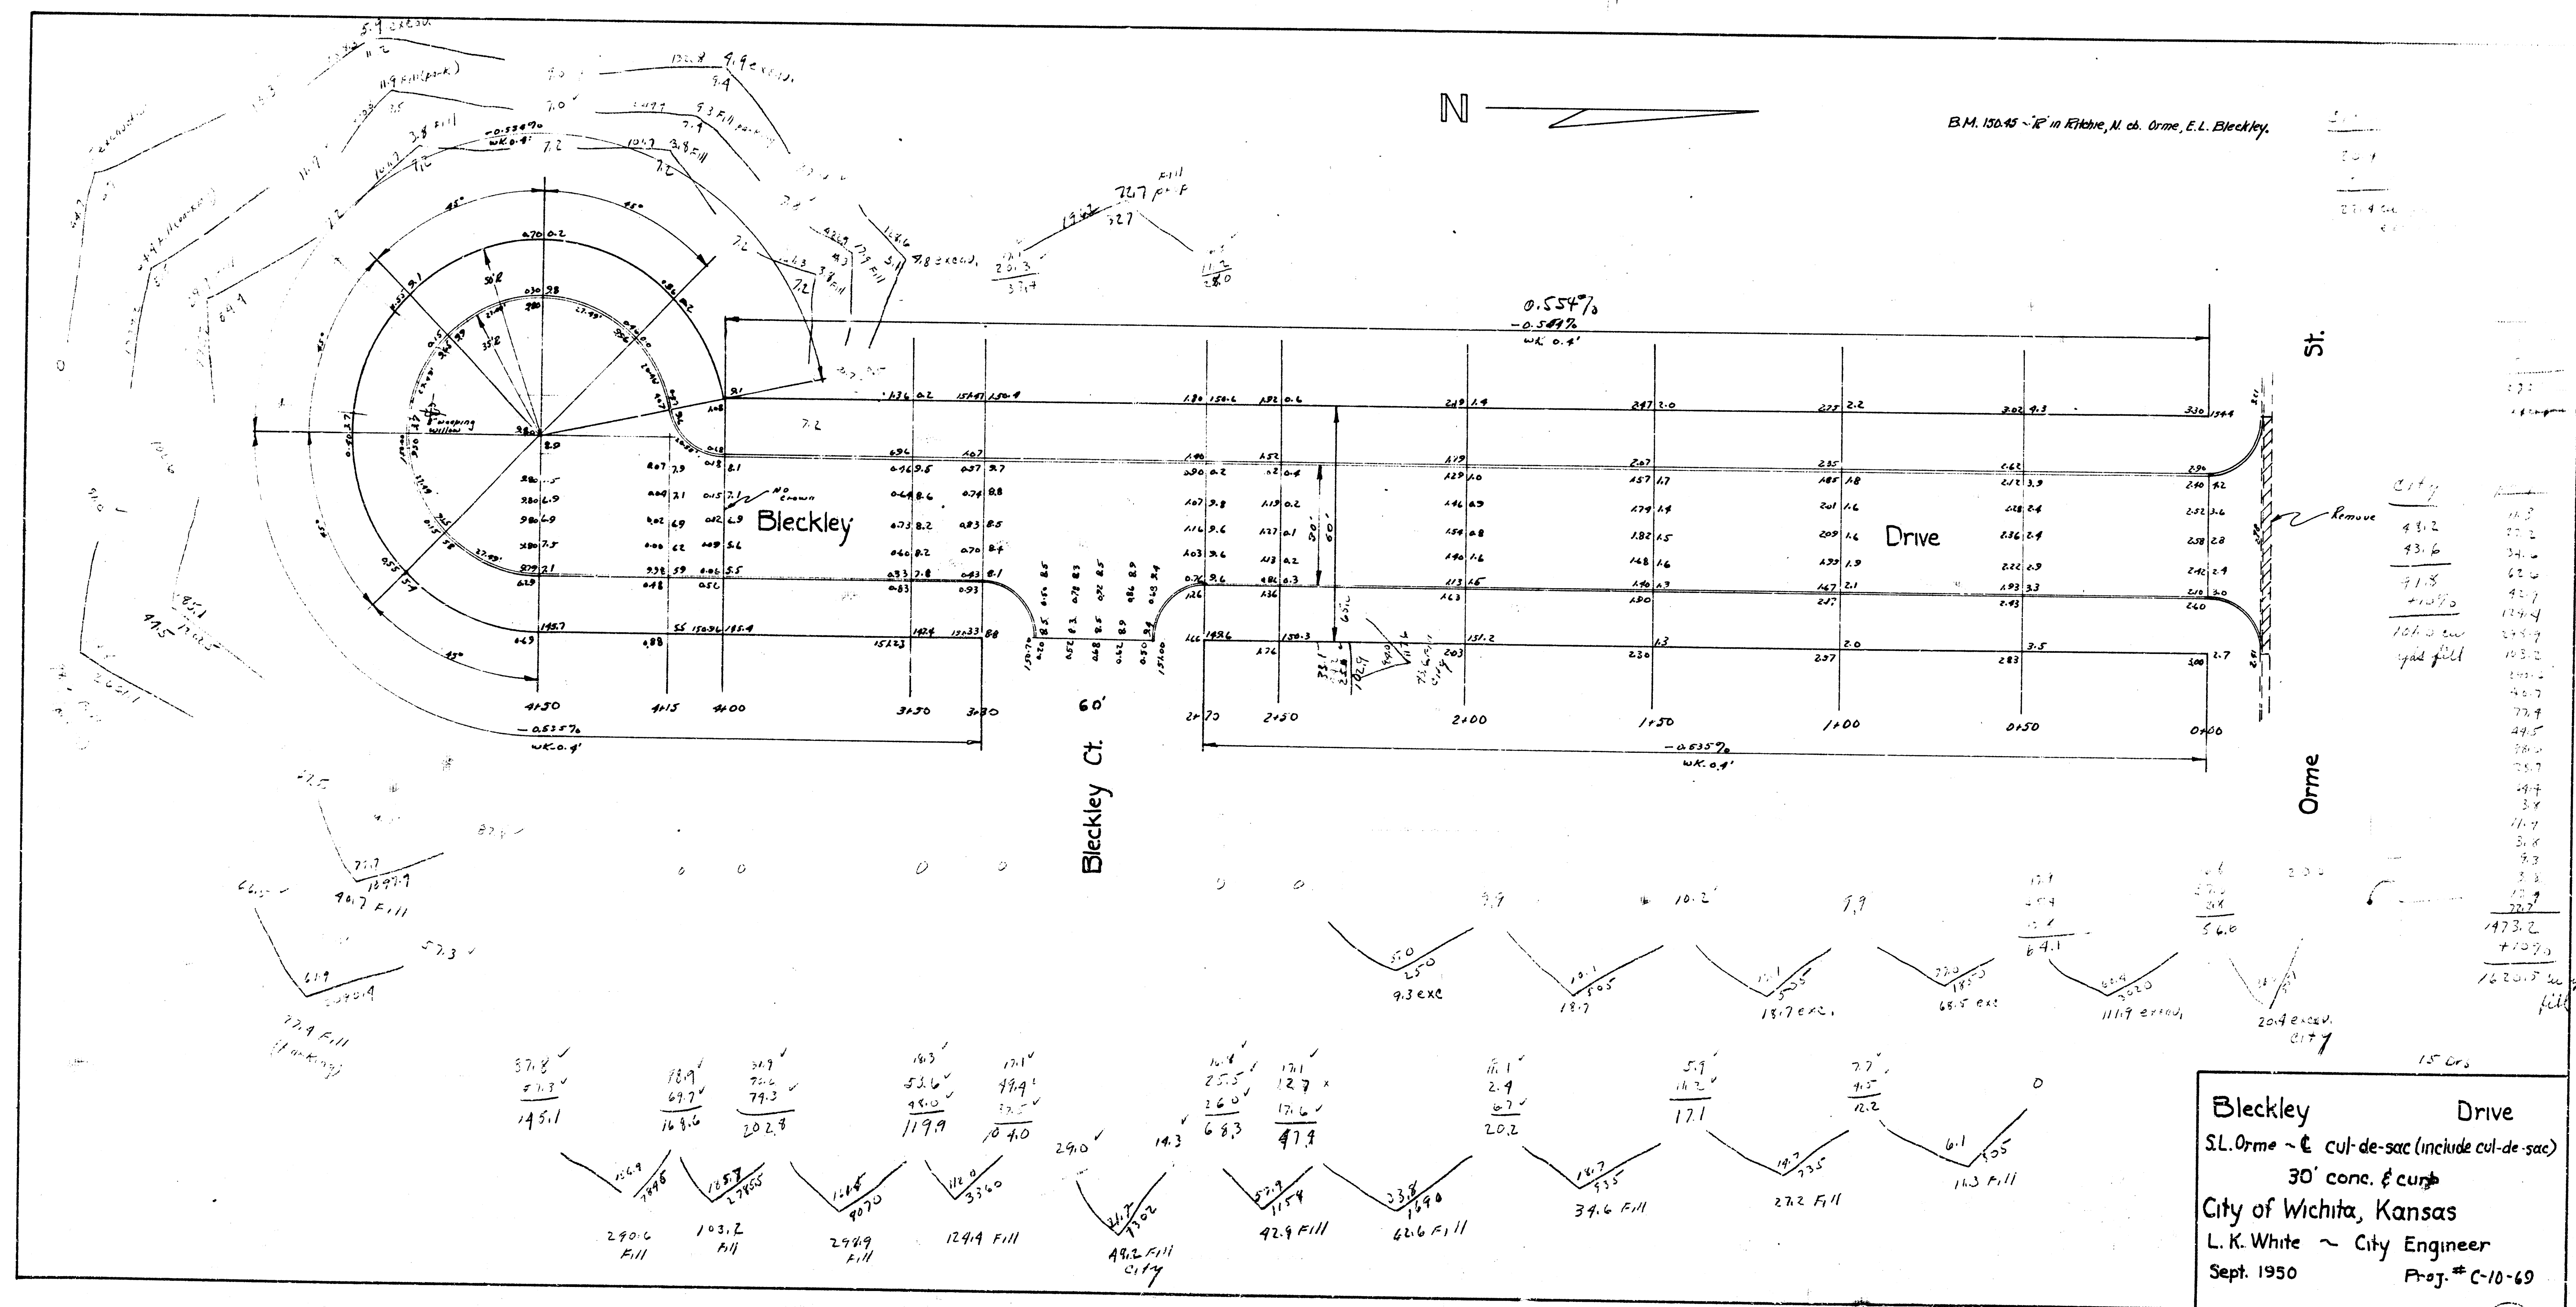

Bleckley Drive
 SL Orme - E cut-de-sac (include cut-de-sac)
 30' conc. & curb
 City of Wichita, Kansas
 L.K. White - City Engineer
 Sept. 1950
 Proj. # C-10-69

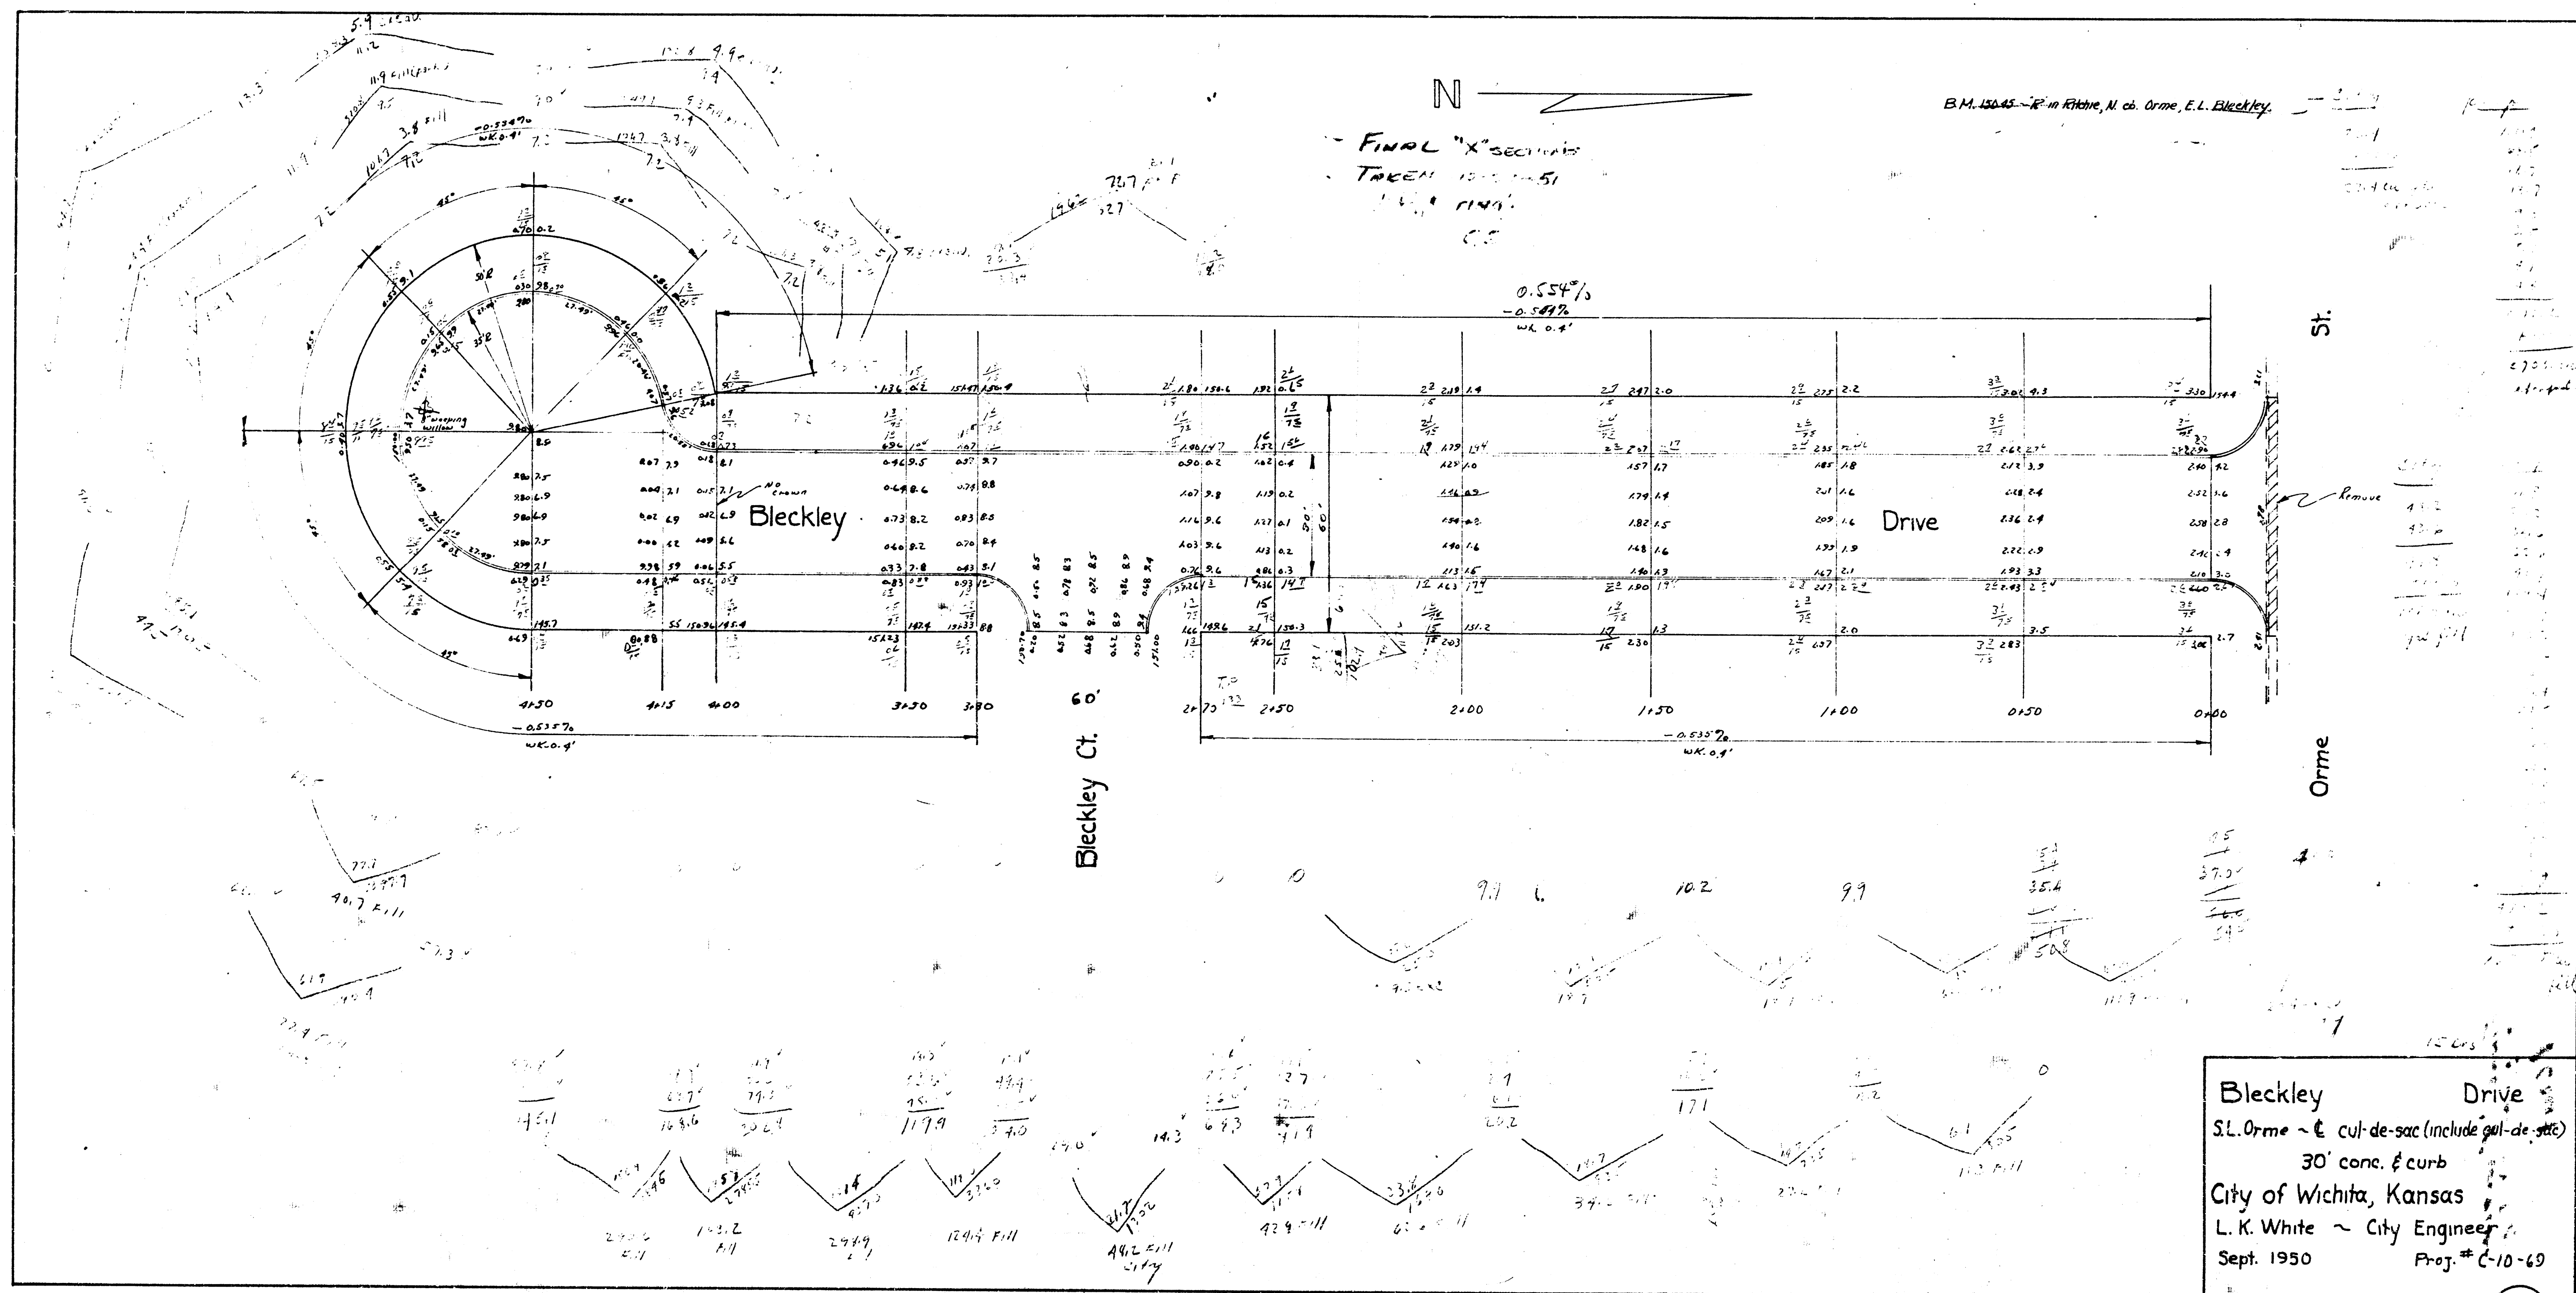

Bleckley Drive
 S.L. Orme - E. cul-de-sac (include cul-de-sac)
 30' conc. & curb
 City of Wichita, Kansas
 L. K. White - City Engineer
 Sept. 1950 Proj. # C-10-69