




STATION 11.12

Surveyed by B. E. Smith
 Plan 42
 Loc. 42
 Checked C. H. E.

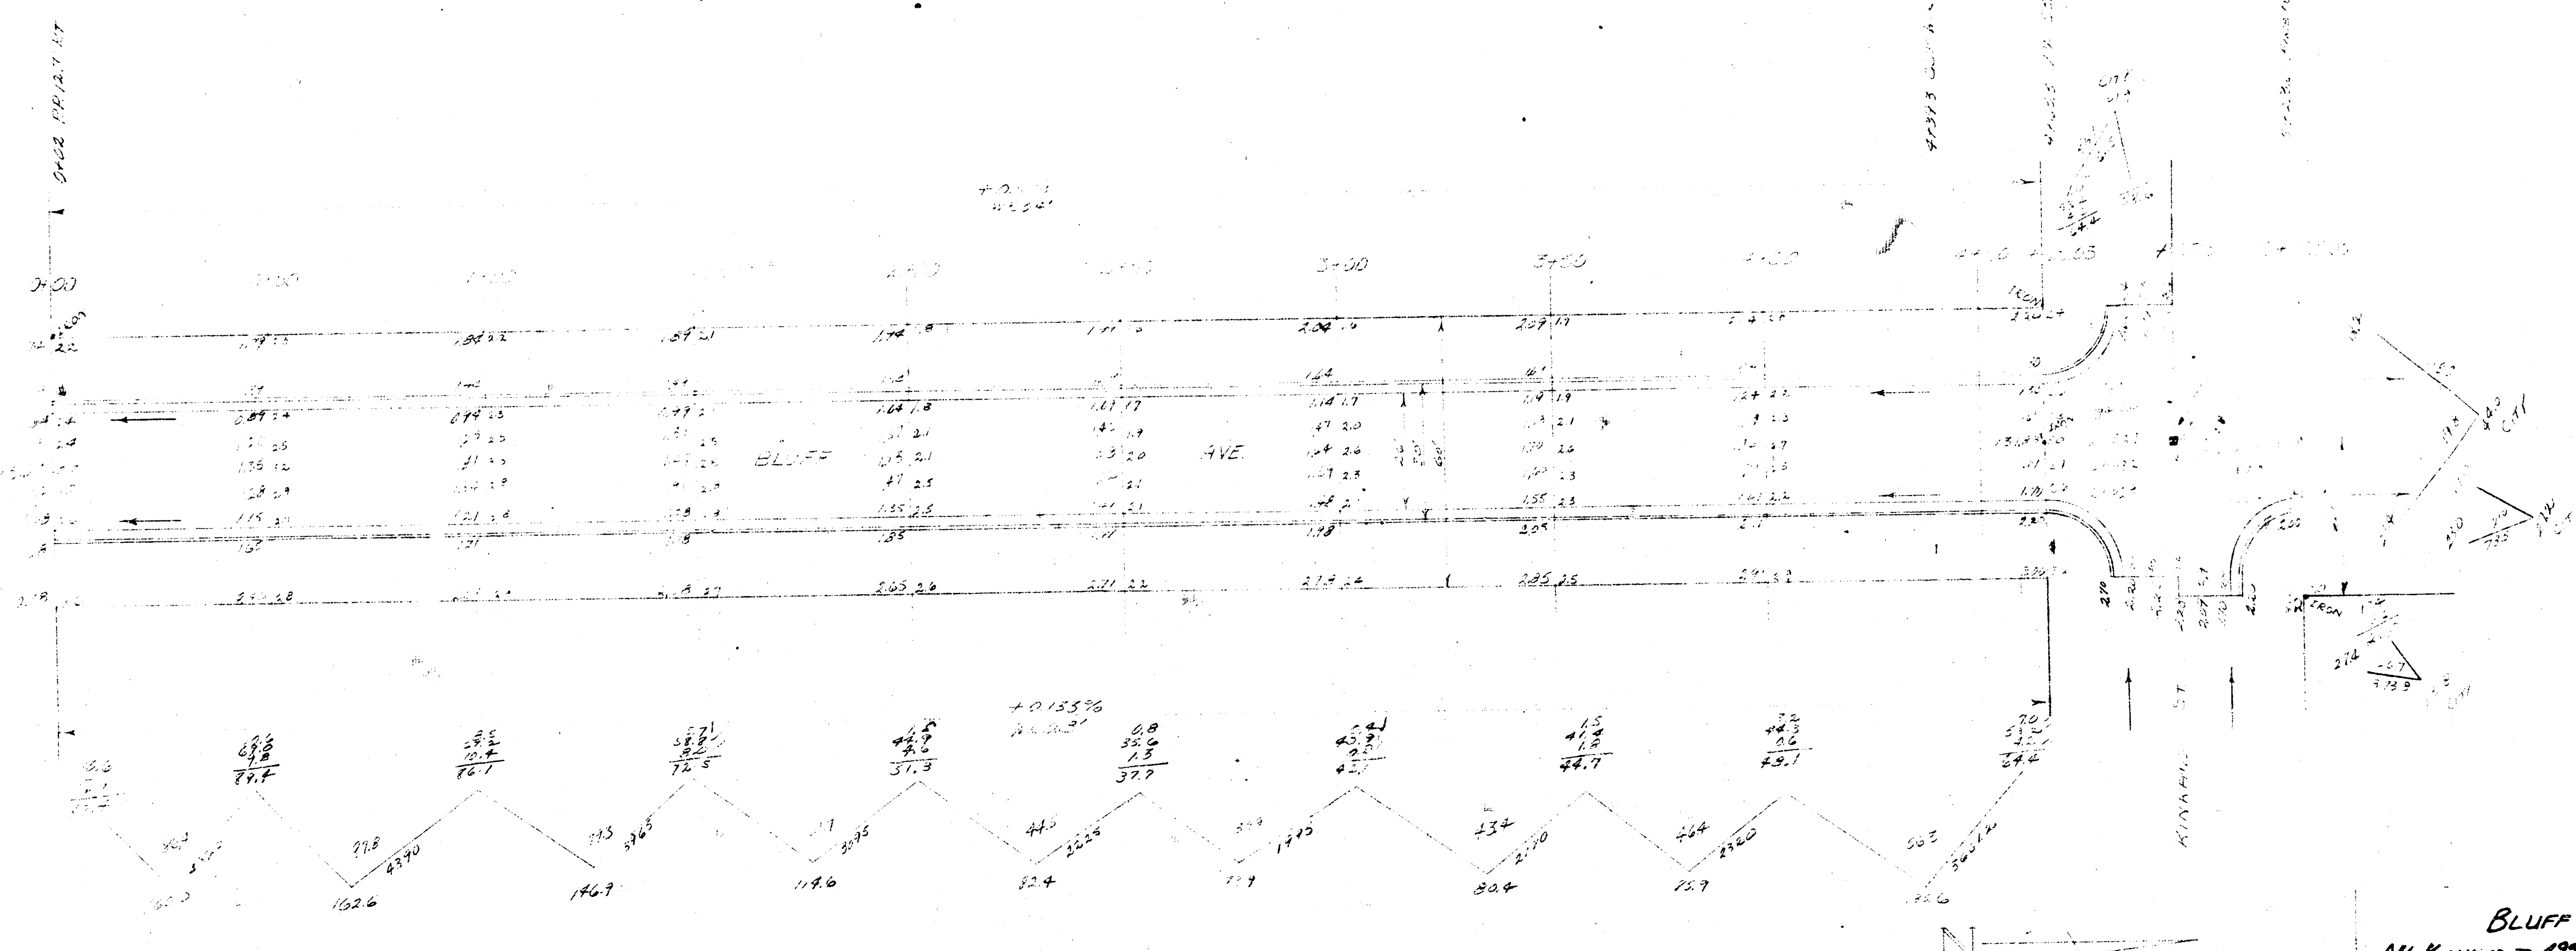

TIES TO IRON & BLUFF ST. MARKED.
 18' 11" SE TO SW COR. CONC. STEP ON CHURCH
 157' 11" E TO NE COR. IRON
 300' W. TO SW COR. IRON


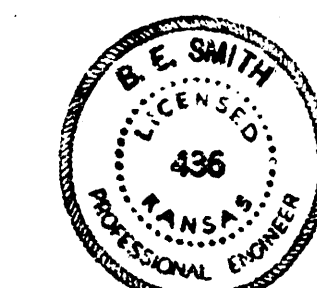

BLUFF AVE
 NW 1/4 SEC. 10 T. 14 N. R. 10 W.
 26-2-30 AC
 CITY OF WICHITA, KANSAS
 B. E. SMITH CITY ENGINEER
 MARCH 24, 1933 PROJ. NO. C-13-1