
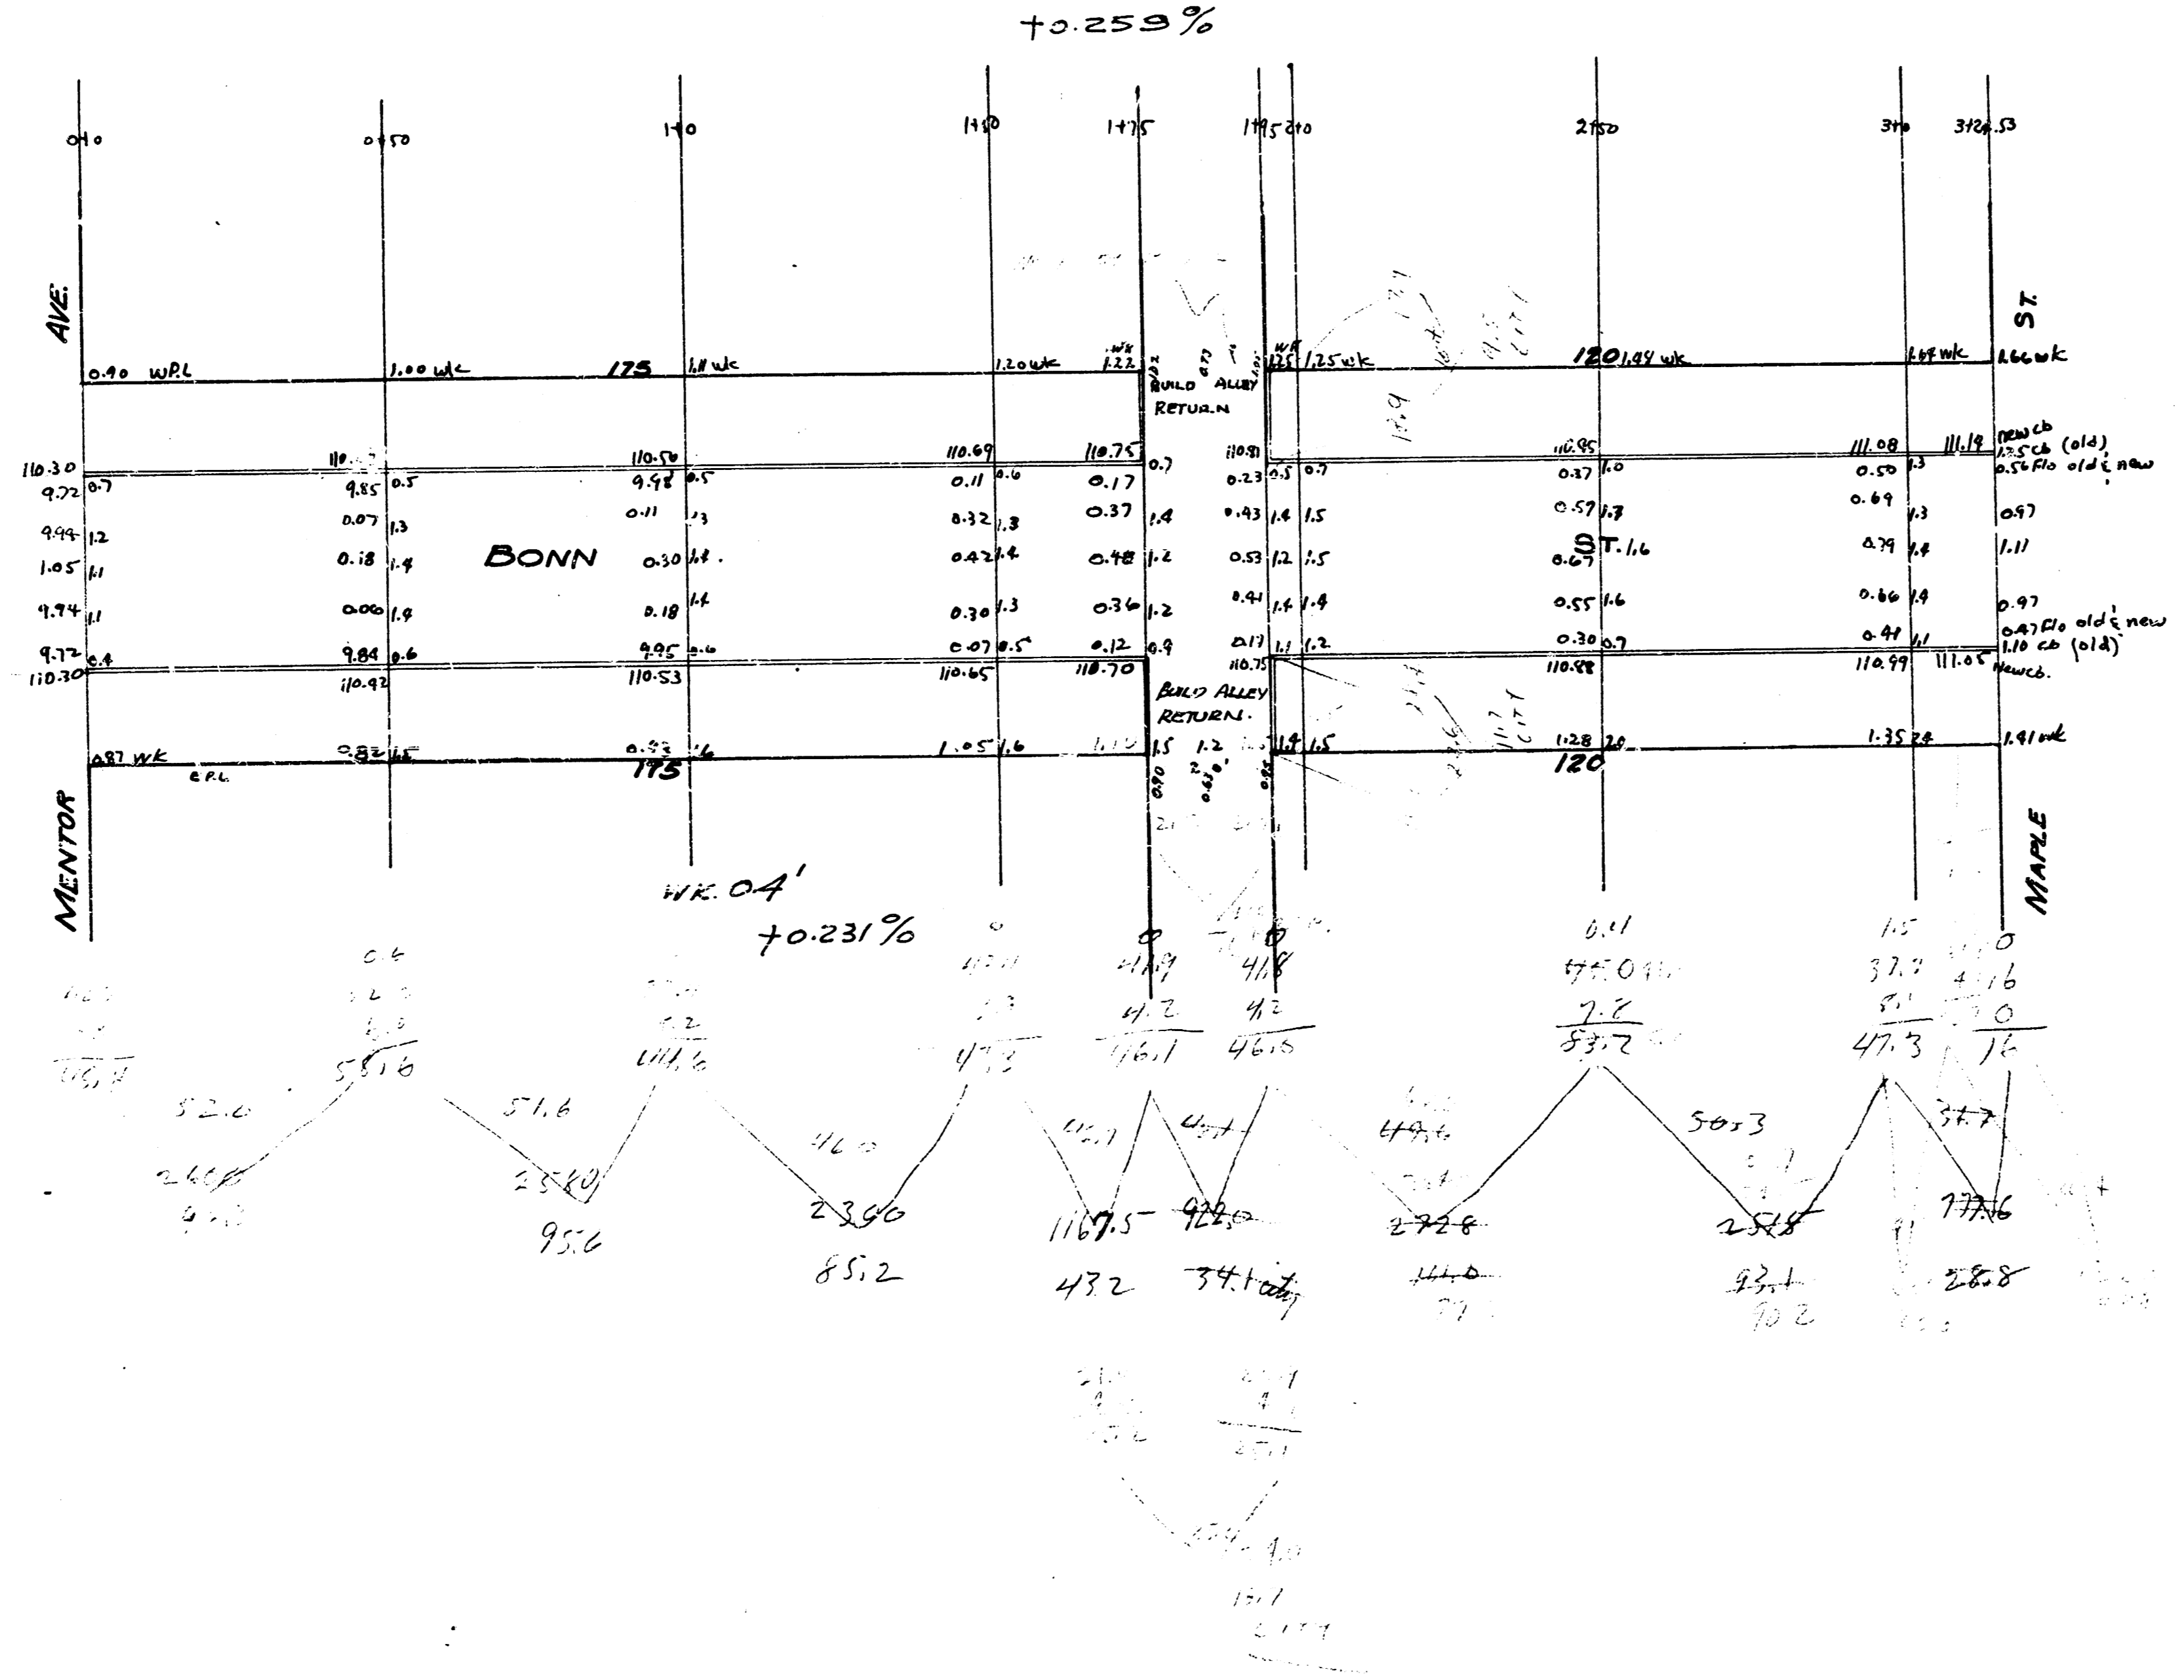


Final #16

B.M. 113.99 "T" in tray, N.W. Cor. Bonn & Mentor.

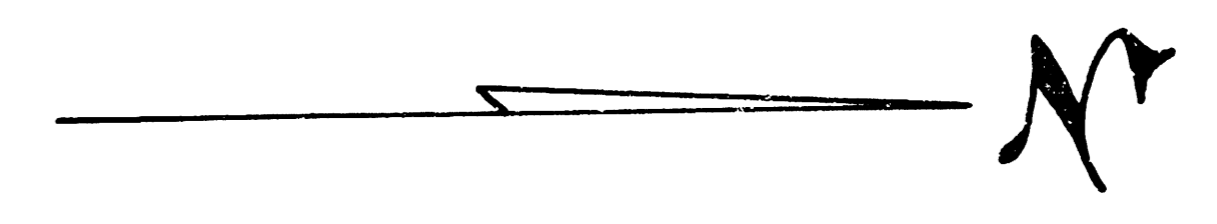

CITY	PROPERTY
37.1	96.3
11.7	95.6
4.5	85.2
55.3	93.2
	101.2
	93.1
	28.8
	543.2
	+1.5% 54.3
	597.5

BONN ST.
 S.L. MAPLE TO N.W. MENTOR
 30' CONCRETE & CURB
 CITY OF WICHITA, KANS.
 ENGINEERING DEPT.
 L.K. WHITE CITY ENGINEER
 JULY 1947