


B.M. 188.49 R.R. Spike S.S. HLP N.S. Cresthill
 150' W. of W.L. Brookfield
 B.M. 178.04 Standard, S.W. Cor. 9th & Armour
 Chaining N. on W. 12

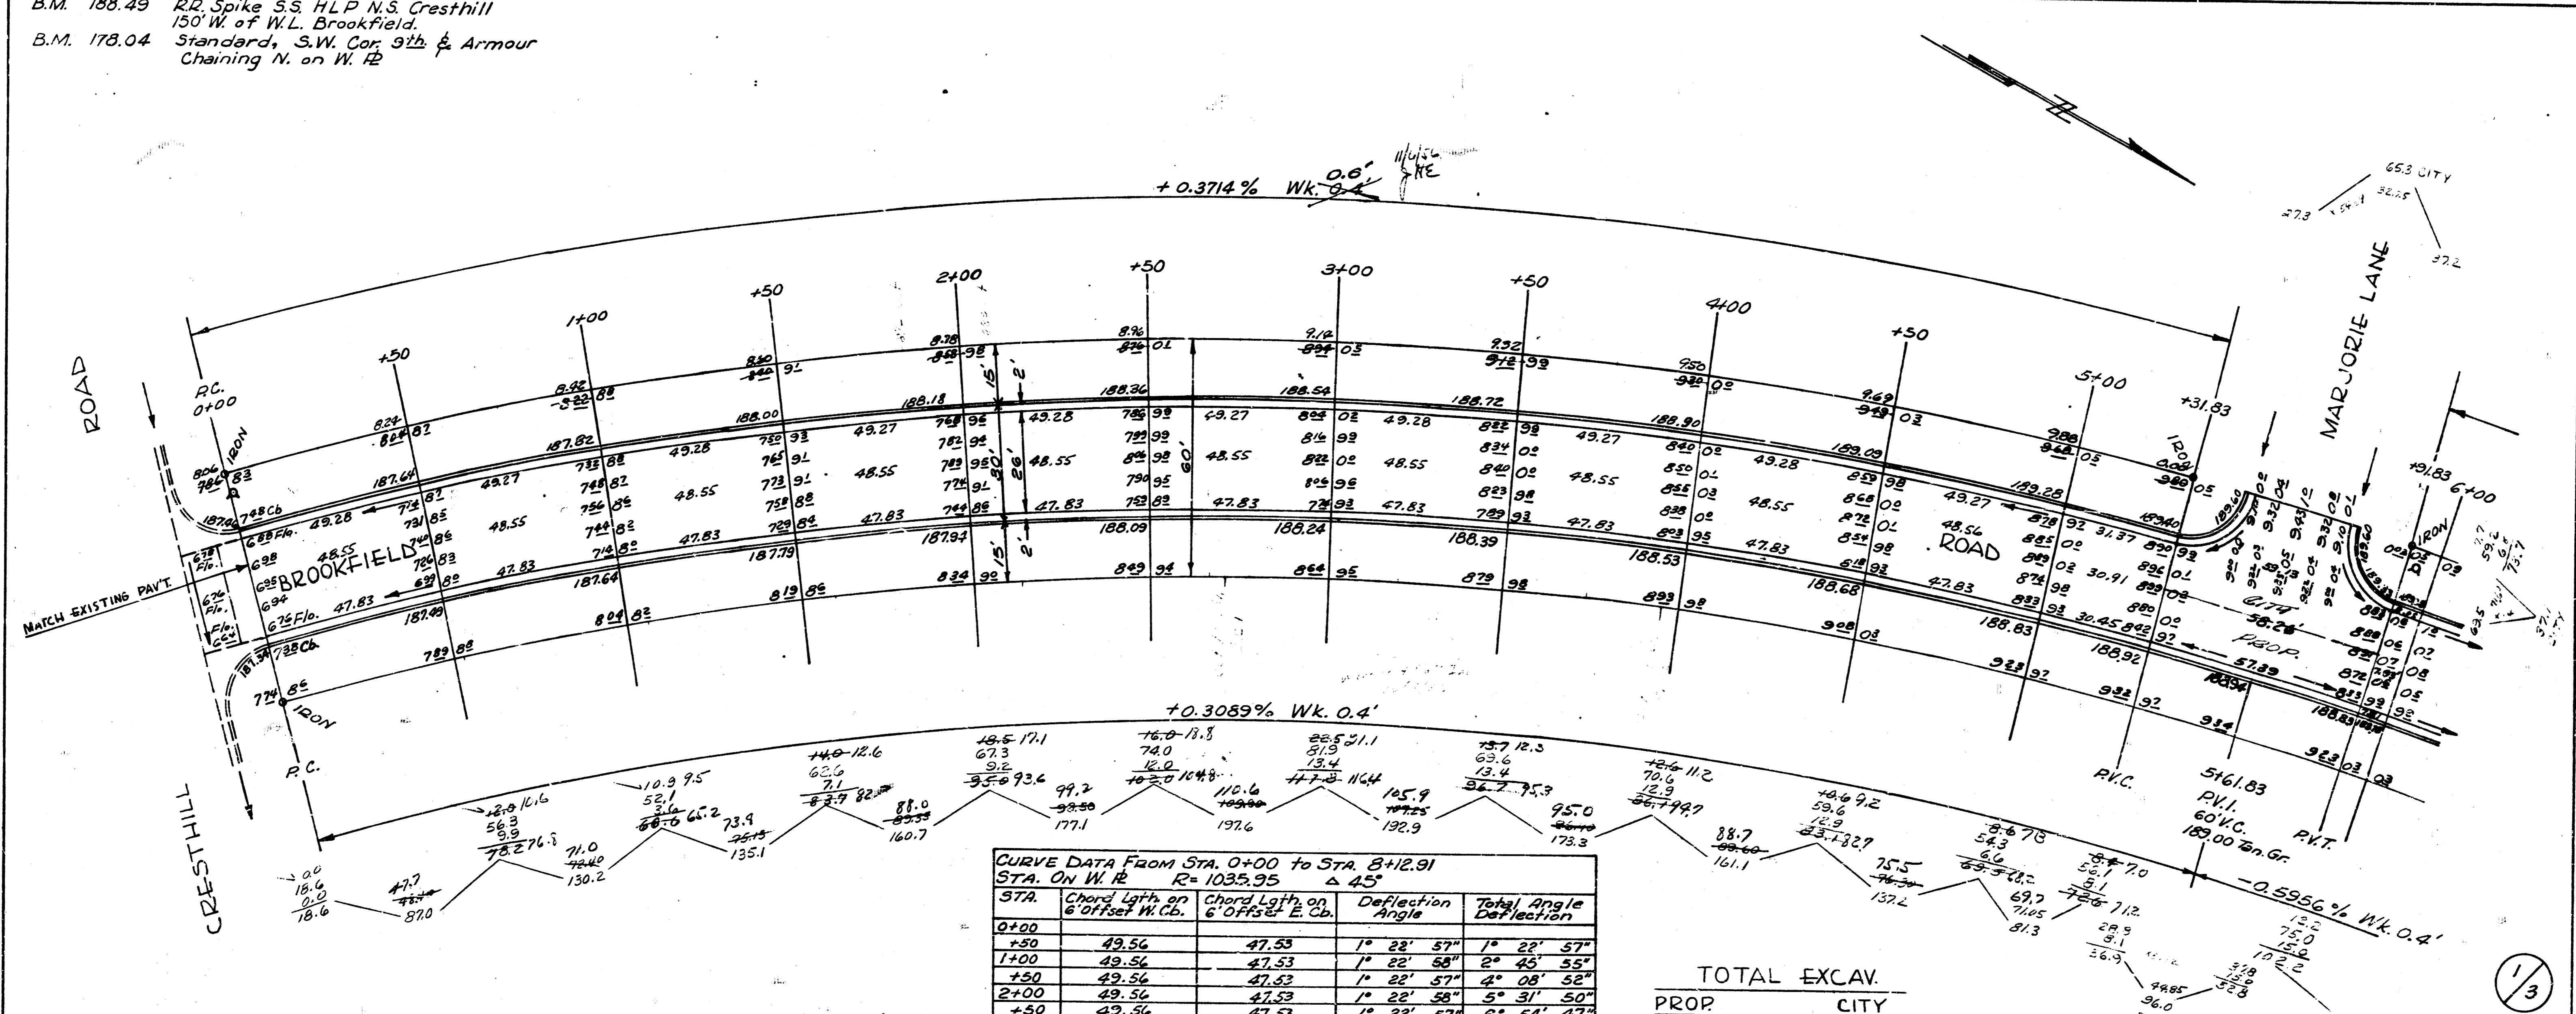


V.M. 136
 D.W.H.
 1/3


CURVE DATA FROM STA. 0+00 TO STA. 8+12.91
 STA. ON W. R. R=1035.95 Δ 45°

STA.	Chord Lgth on 6' Offset W. Co.	Chord Lgth on 6' Offset E. Co.	Deflection Angle	Total Angle Deflection

TOTAL EXCAV.
 PROP 3602.2
 CITY 102.4
 3704.6 Cu. Yd.

BROOKFIELD ROAD
 N. CRESTHILL ROAD-S. L. NINTH ST.
 26'-2'-30' A.C.
 CITY OF WICHITA, KANS.
 B.E. SMITH CITY ENGINEER
 NOV. 1954 PROJ. NO. C14-309

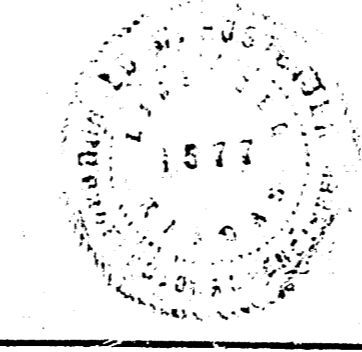

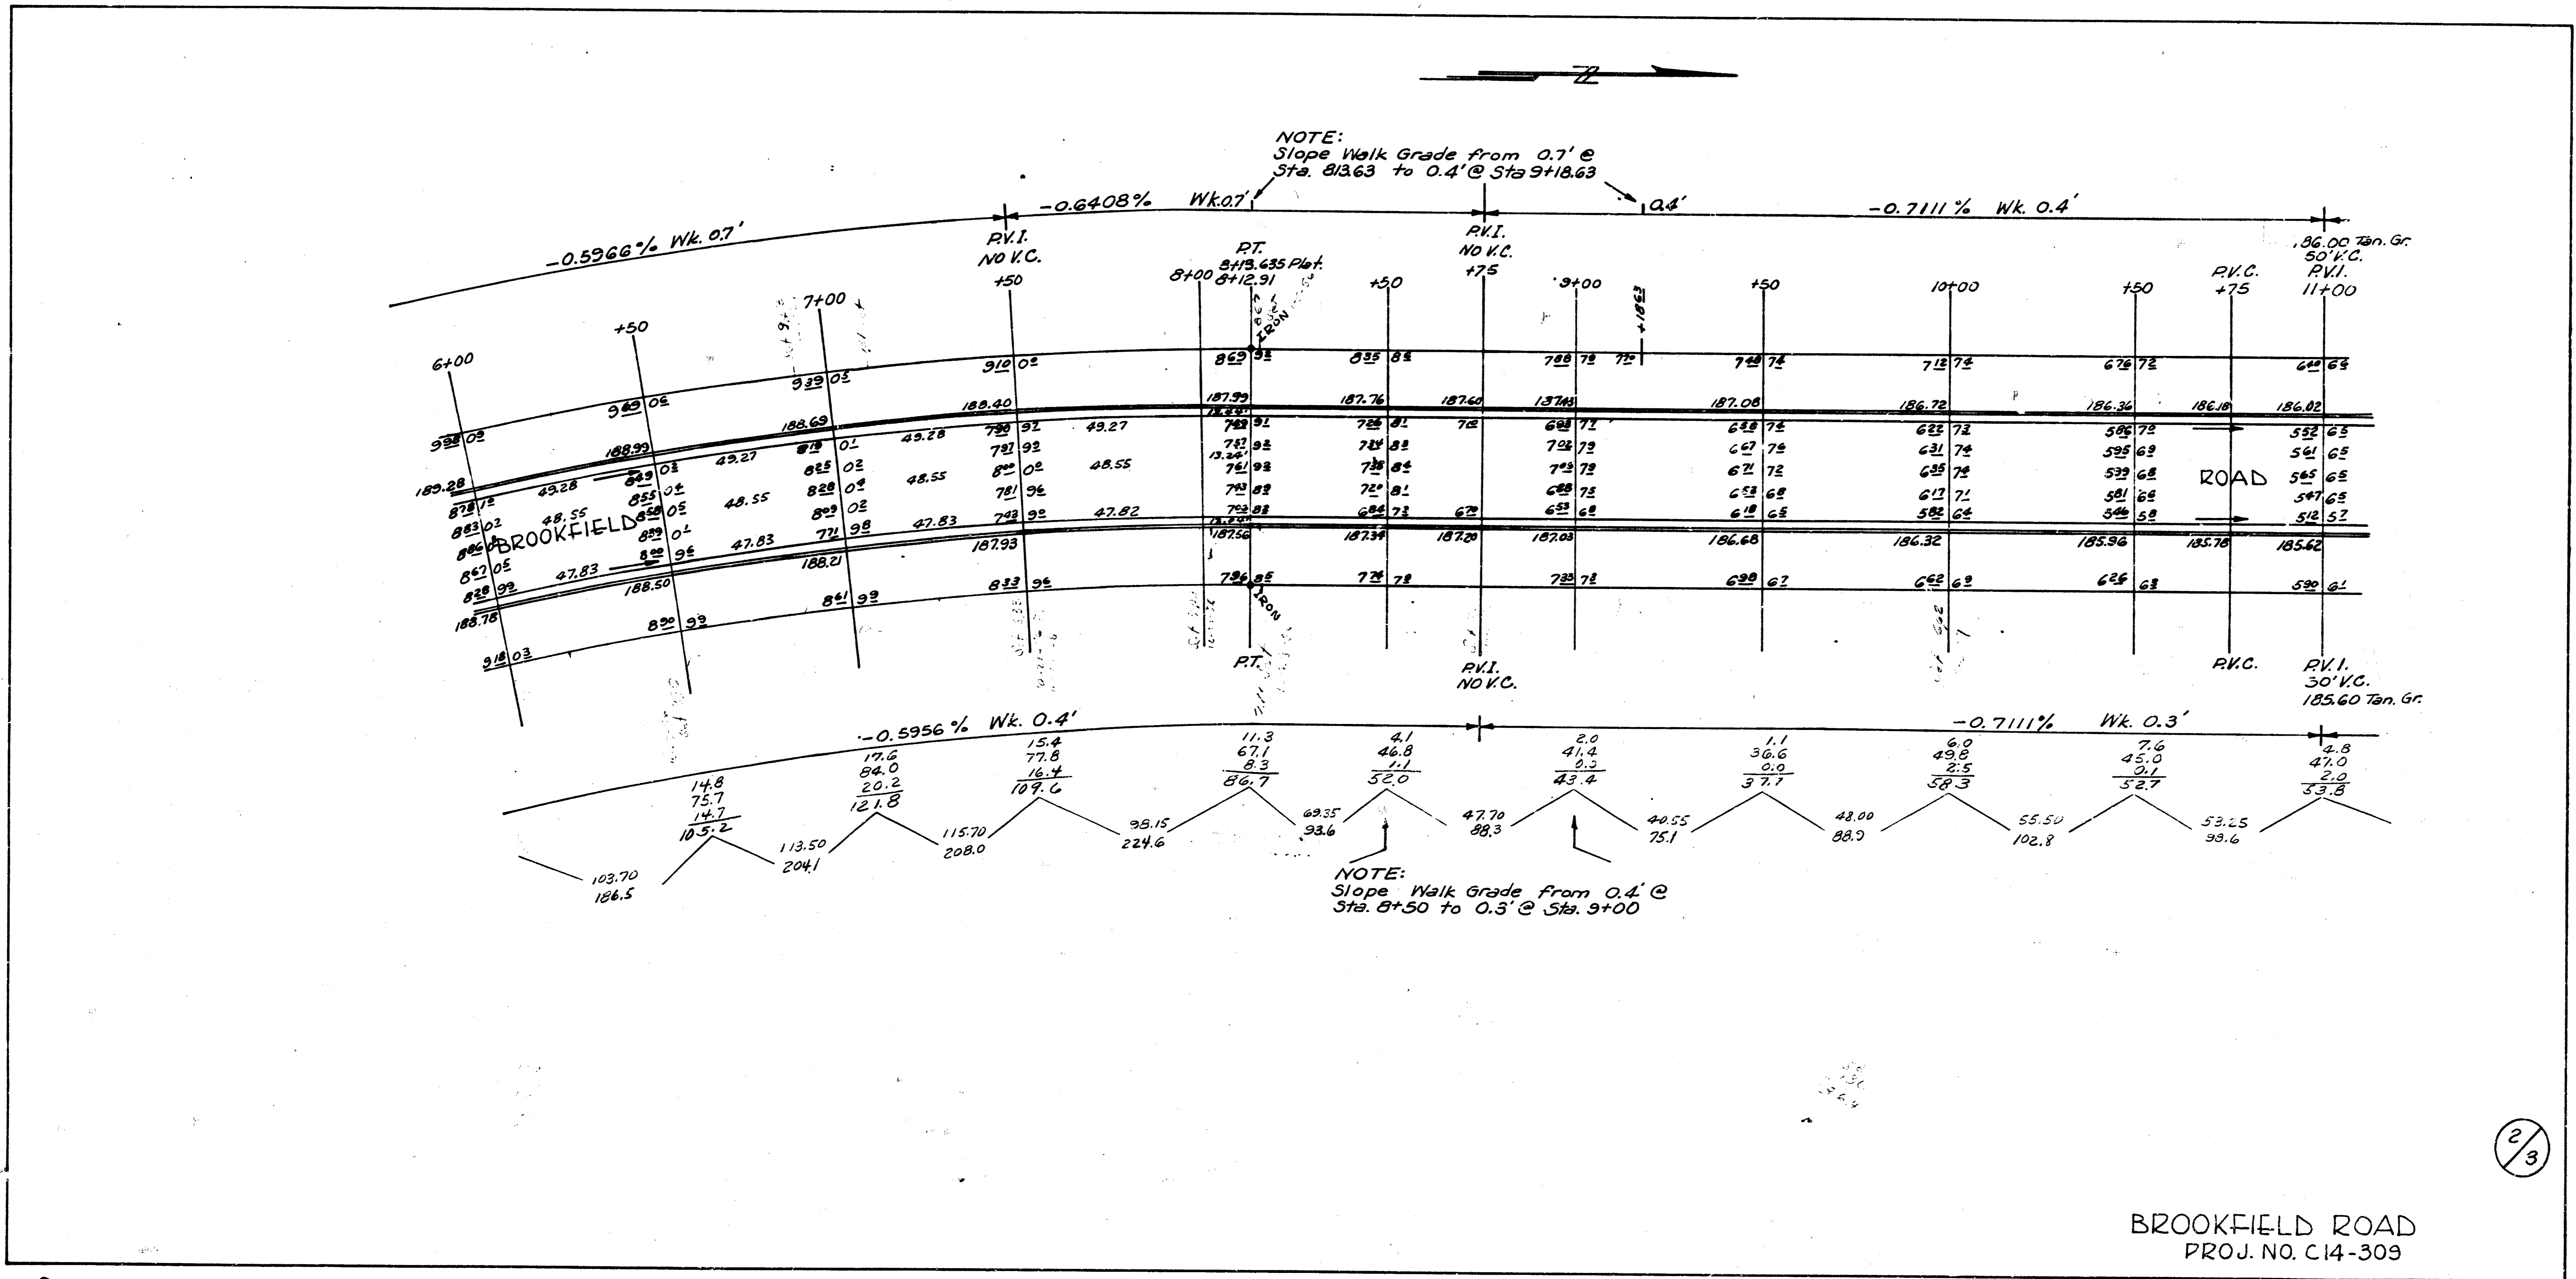

BROOKFIELD ROAD
 PROJ. NO. C14-309

