



BENCH MARKS:
 111.35 @ Martinson & Burton
 110.83 @ Exposition & Burton

Prop.	City
29.6	116.4
36.6	16.5
28.2	8.2
8.5	30.3
44.0	3.0
38.3	33.3 cu yd.
7.3	
186.5	
+107.0	
71.7	
205.2 cu yd.	

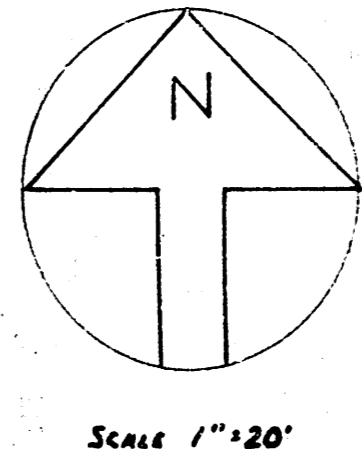

BURTON
 EL MARTINSON TO WL EXPOSITION
 26-2-30 A.C.
 CITY OF WICHITA KANSAS
 L.K. WHITE CITY ENGINEER
 JAN 1952 Proj No CII-262

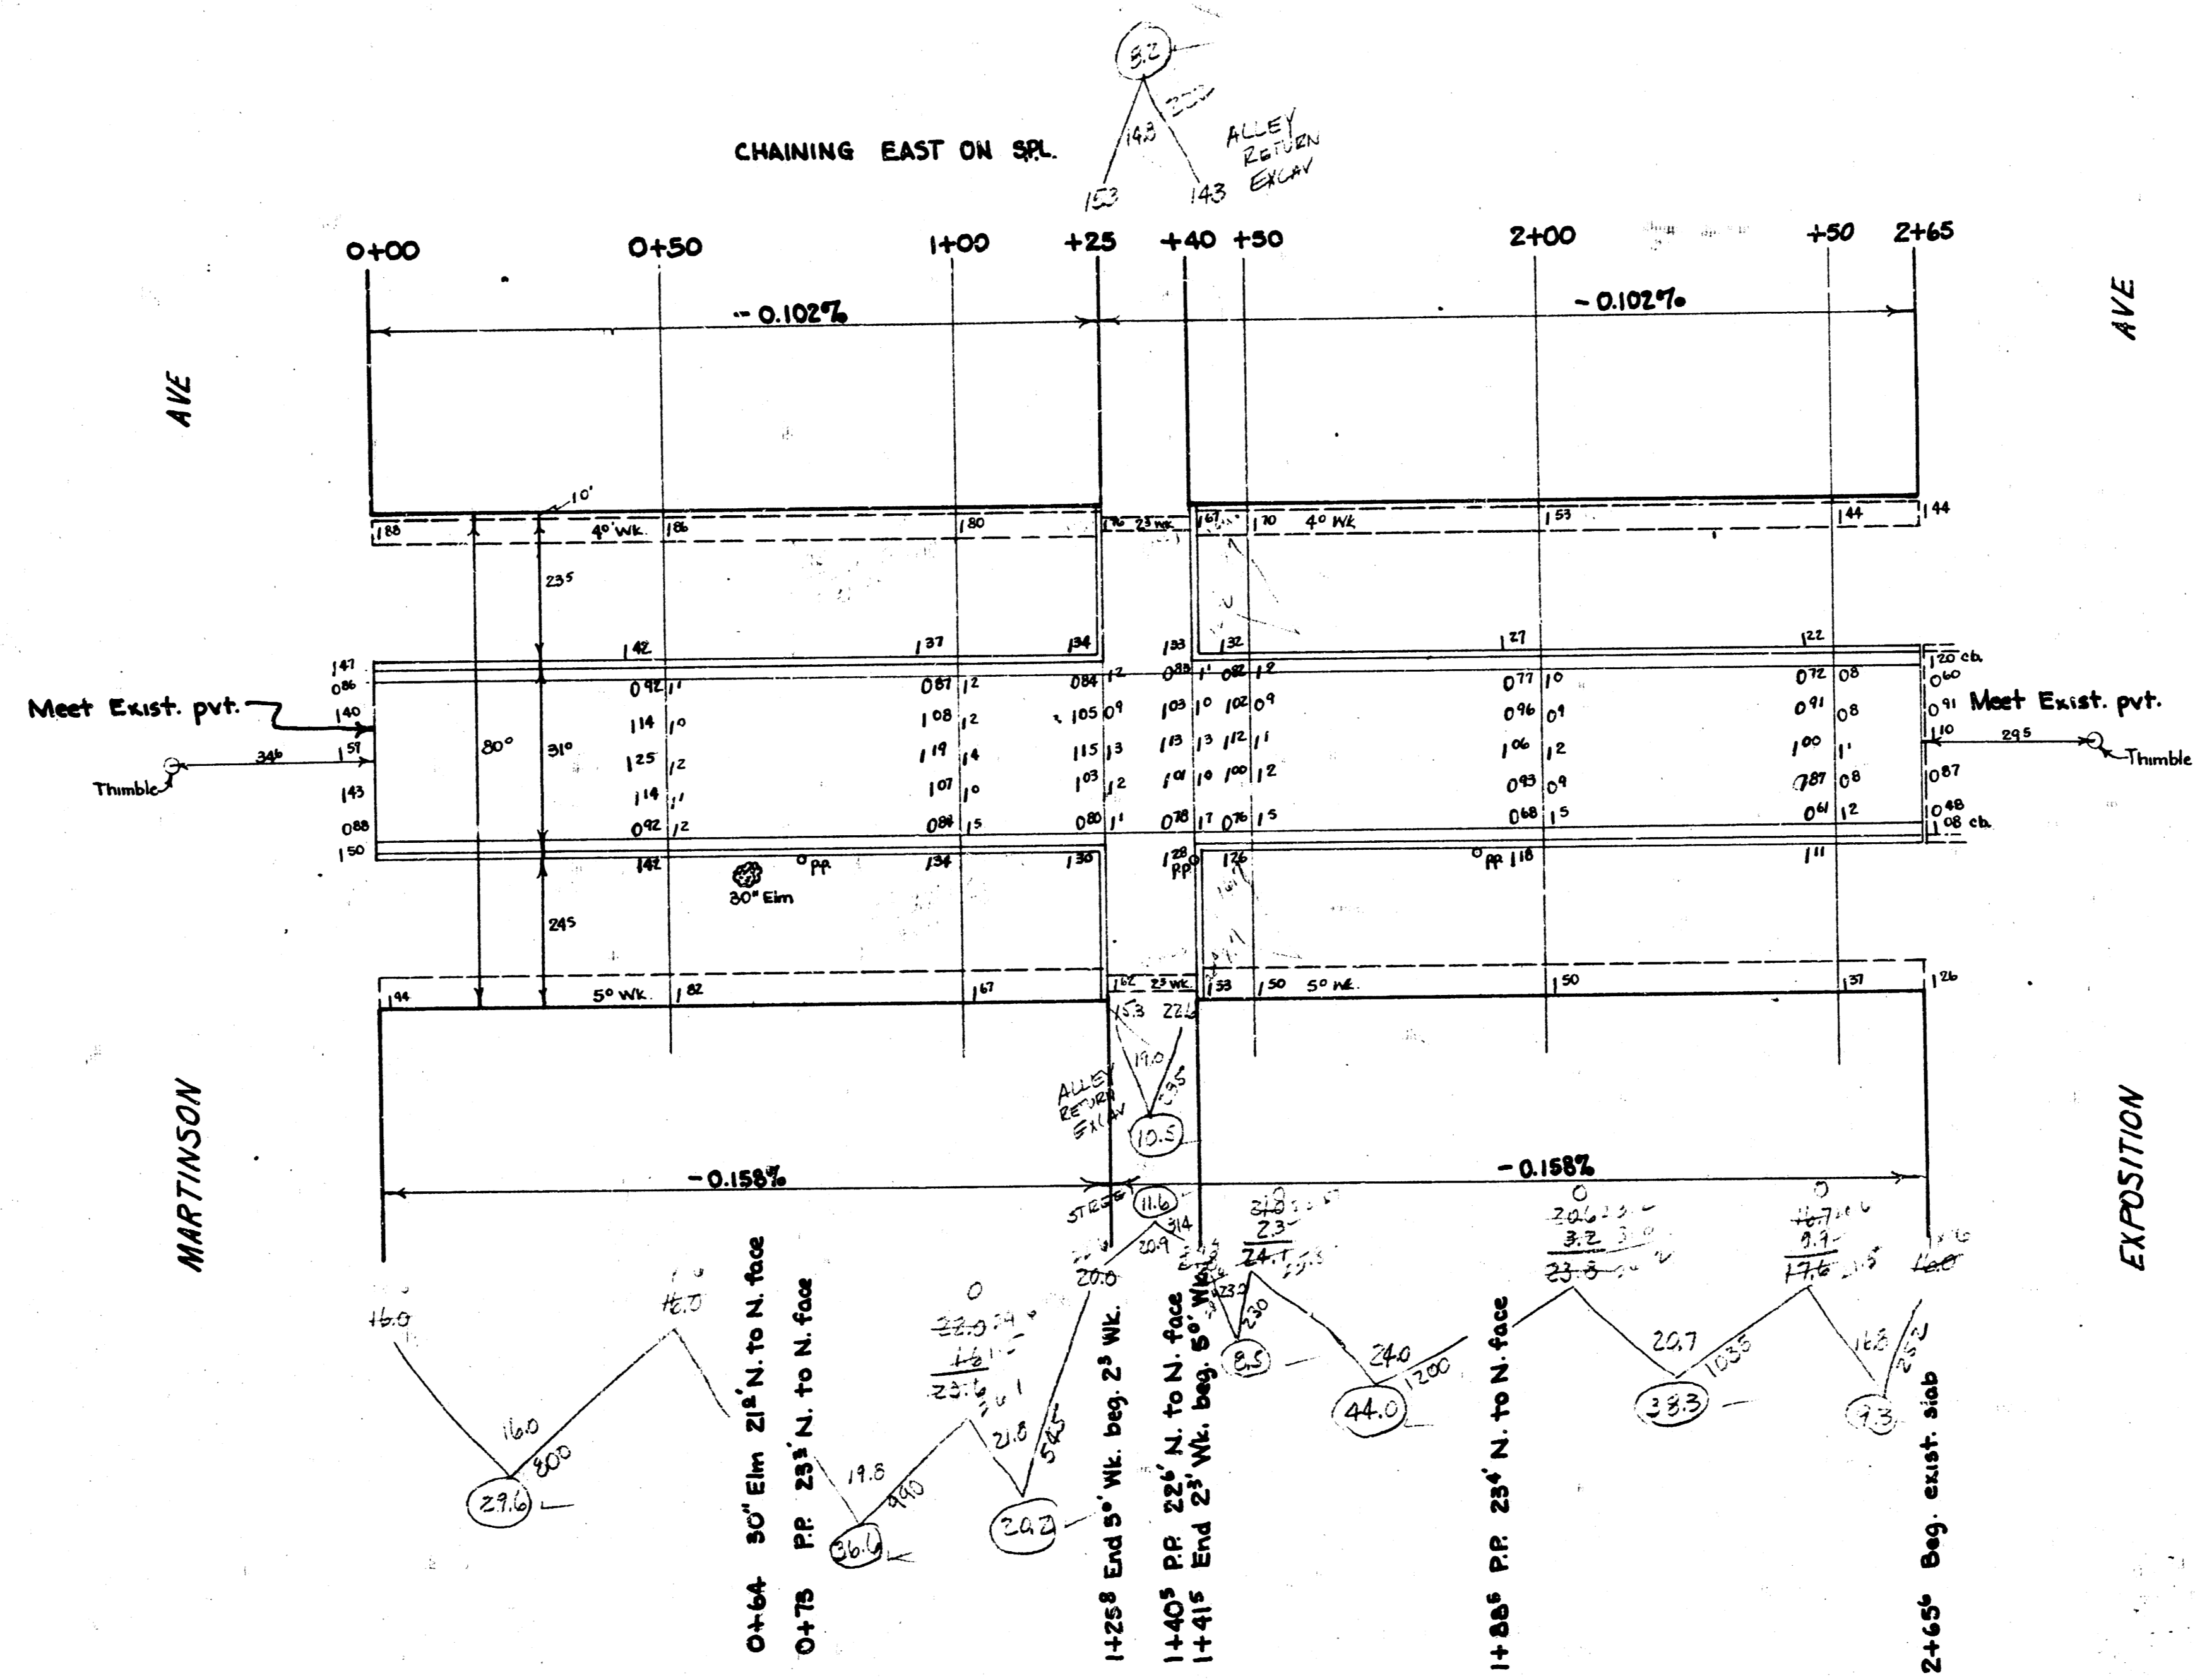