


BM 155.50 SE Cor. Cone Parcel 118 * 1838 Castle
 BM 150.55 NW Cor. Cone Parcel 118 * 1460 Waverly

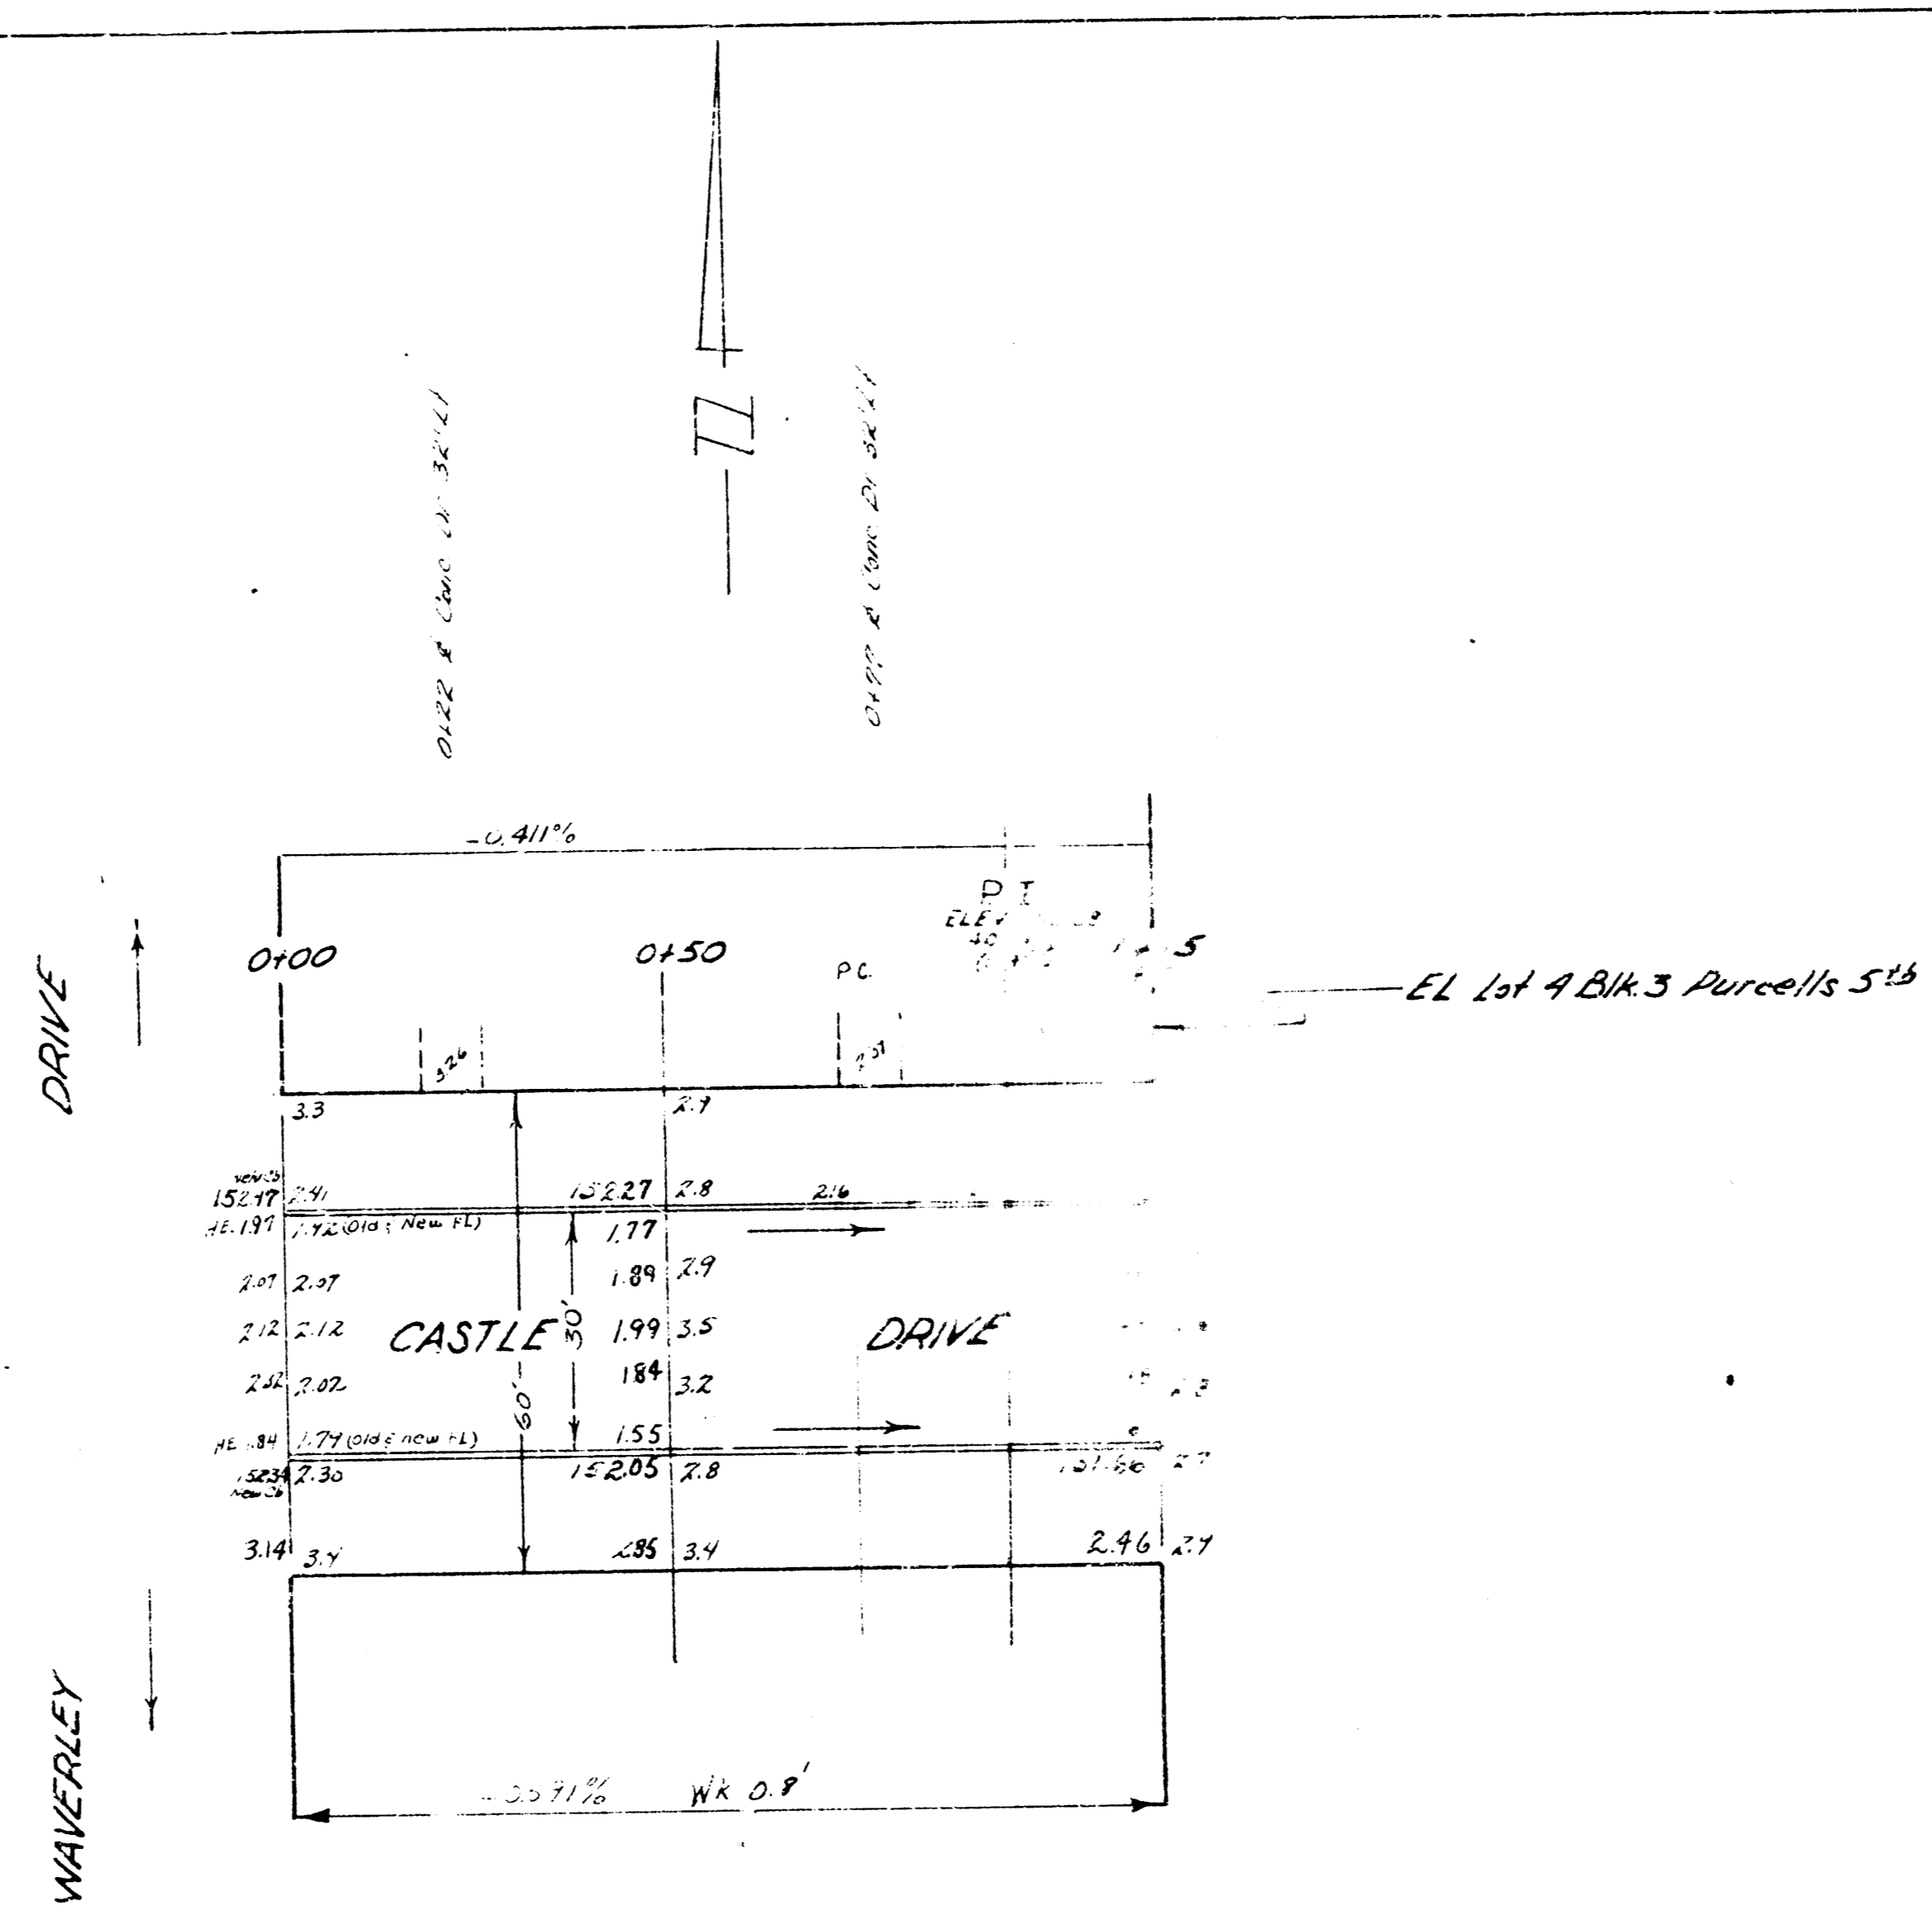

REVISED 3-29-52
 REVISED 3-17-52

CASTLE DRIVE
 EL WAVERLY - EL 11.4 Blk 3 Parcel 118 5th
 30' Conc. & Cb.
 City of Wichita Kansas
 L.K. White City Engineer
 April, 1951 Proj. No. C11-48