
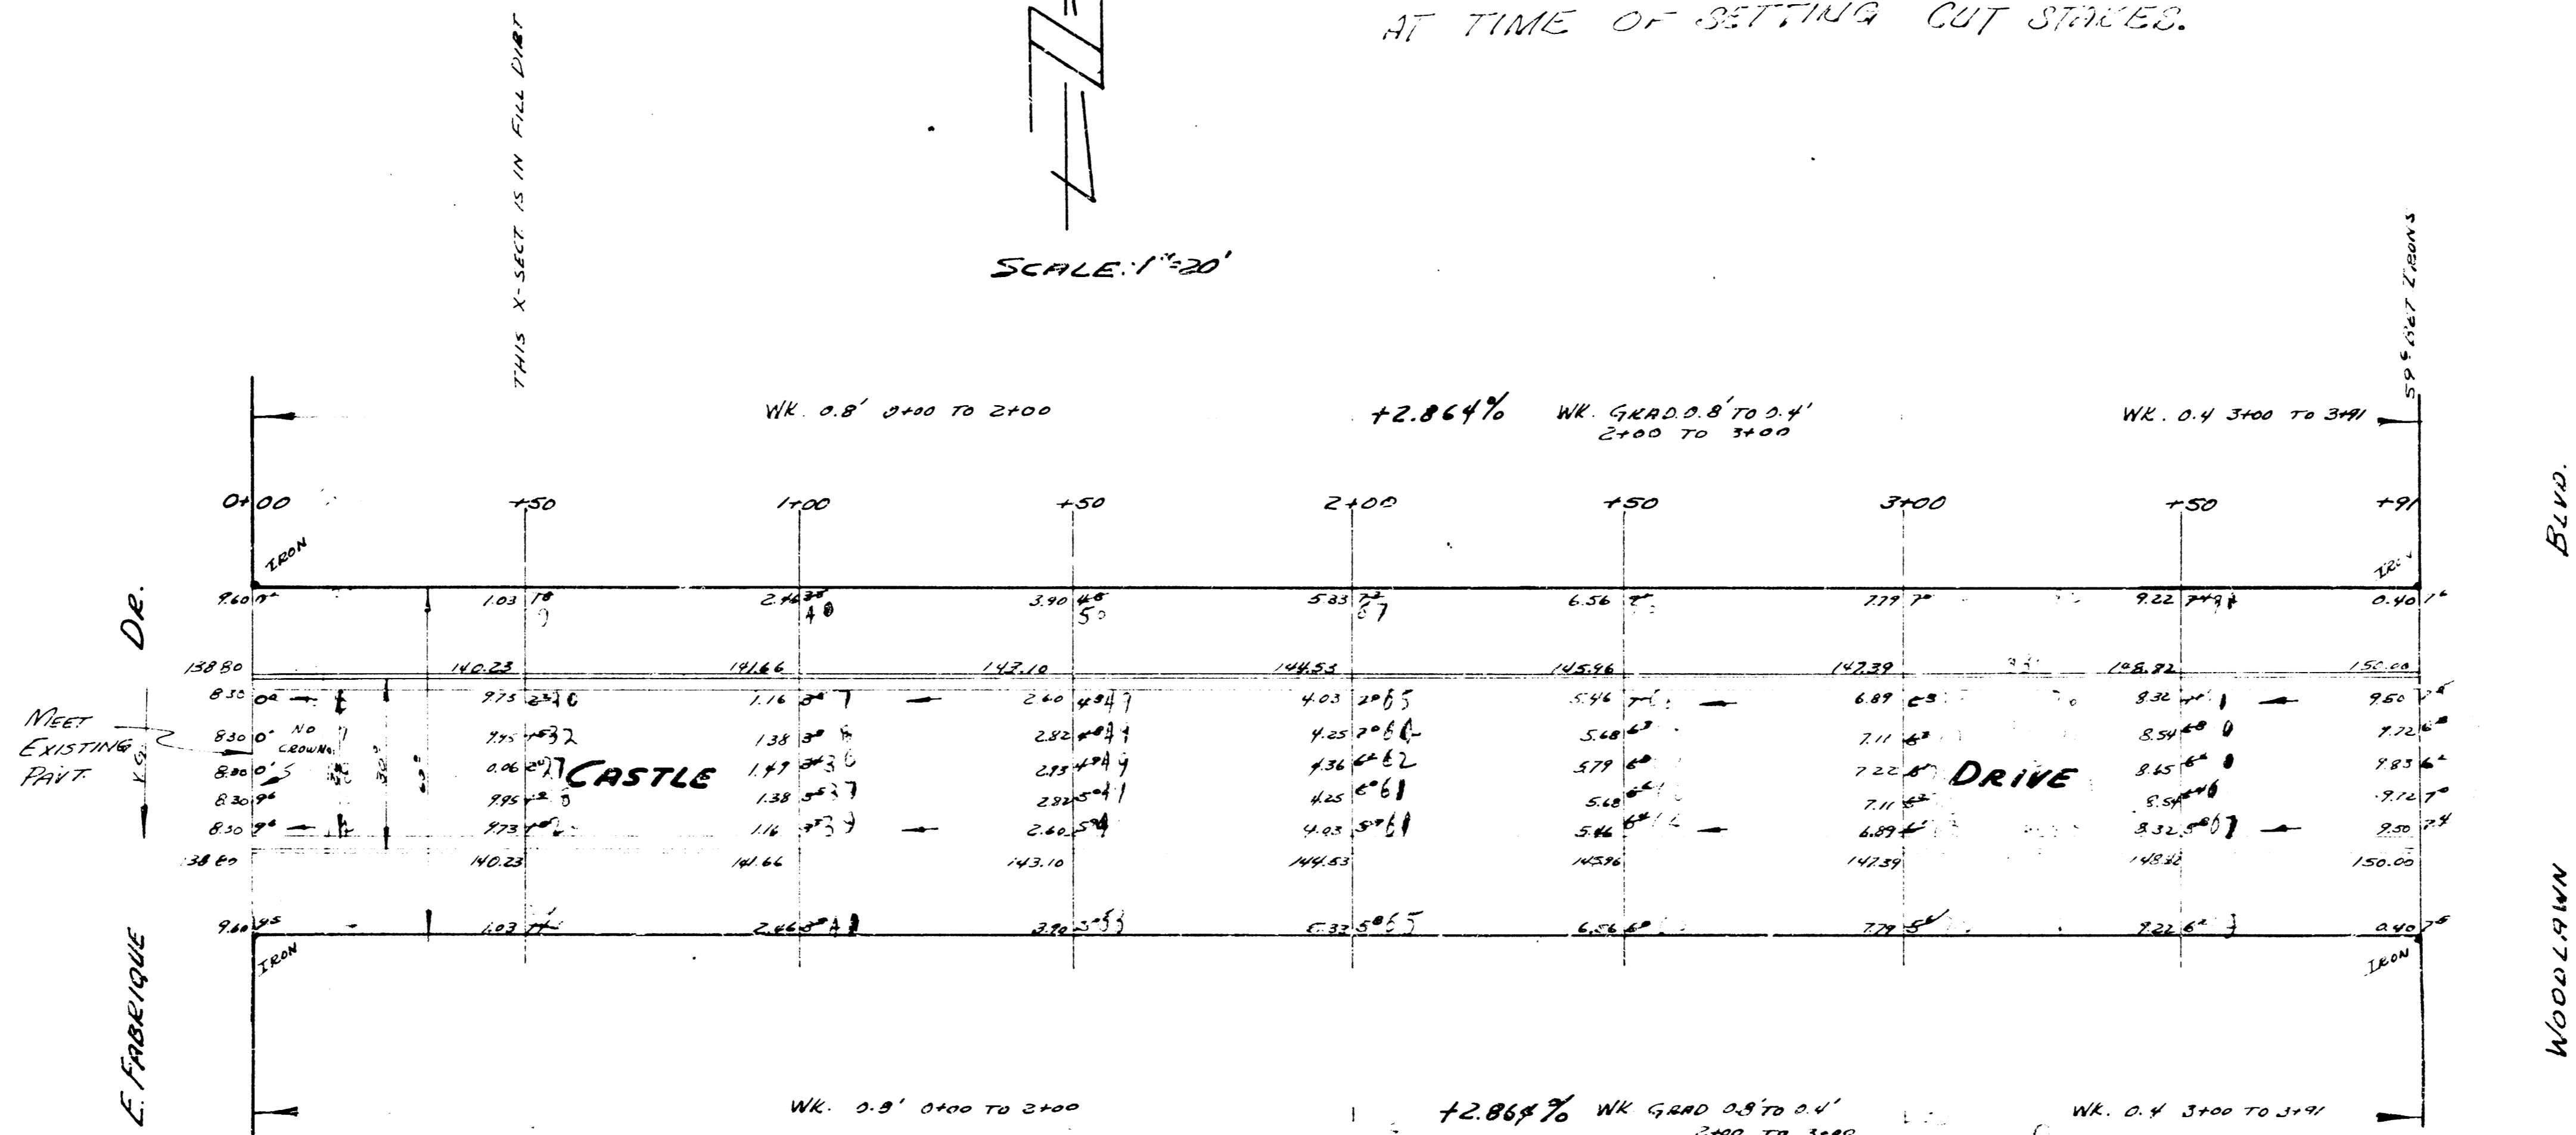


S-2

R.M. X IN W. HUGGARD (1-CULVERT) W. S. WOODLAWN W. L. CASTLE DR. 15150  
S.M. STD. N.W. COR. WOODLAWN & LINCOLN - 15342

NOTE TO FIELD ENGINEER,  
RE-CROSSSECTION THIS PROJECT  
AT TIME OF SETTING CUT STAKES.

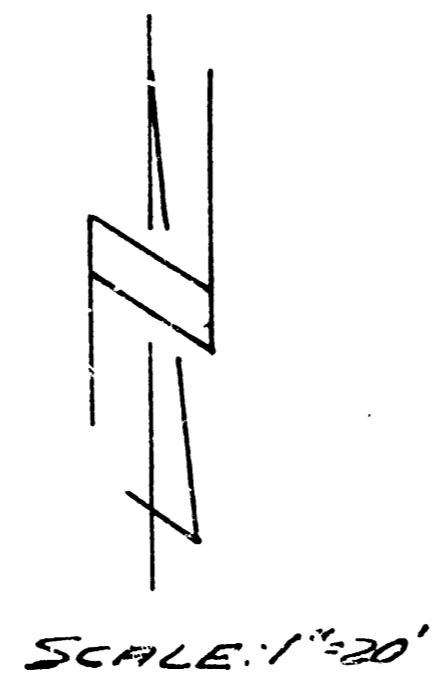

CASTLE DR  
EL E. FABRIQUE TO W. WOODLAWN  
26-2-30AC  
CITY OF WICHITA, KANS.  
L.K. WHITE CITY ENGINEER  
JAN. 28, 1952 Proj. No. C11-324