


B.M. 10805 Iron EL. Chautauqua - N.L. Funston

B.M. 10621 Iron EL. Chautauqua - S.L. Osie

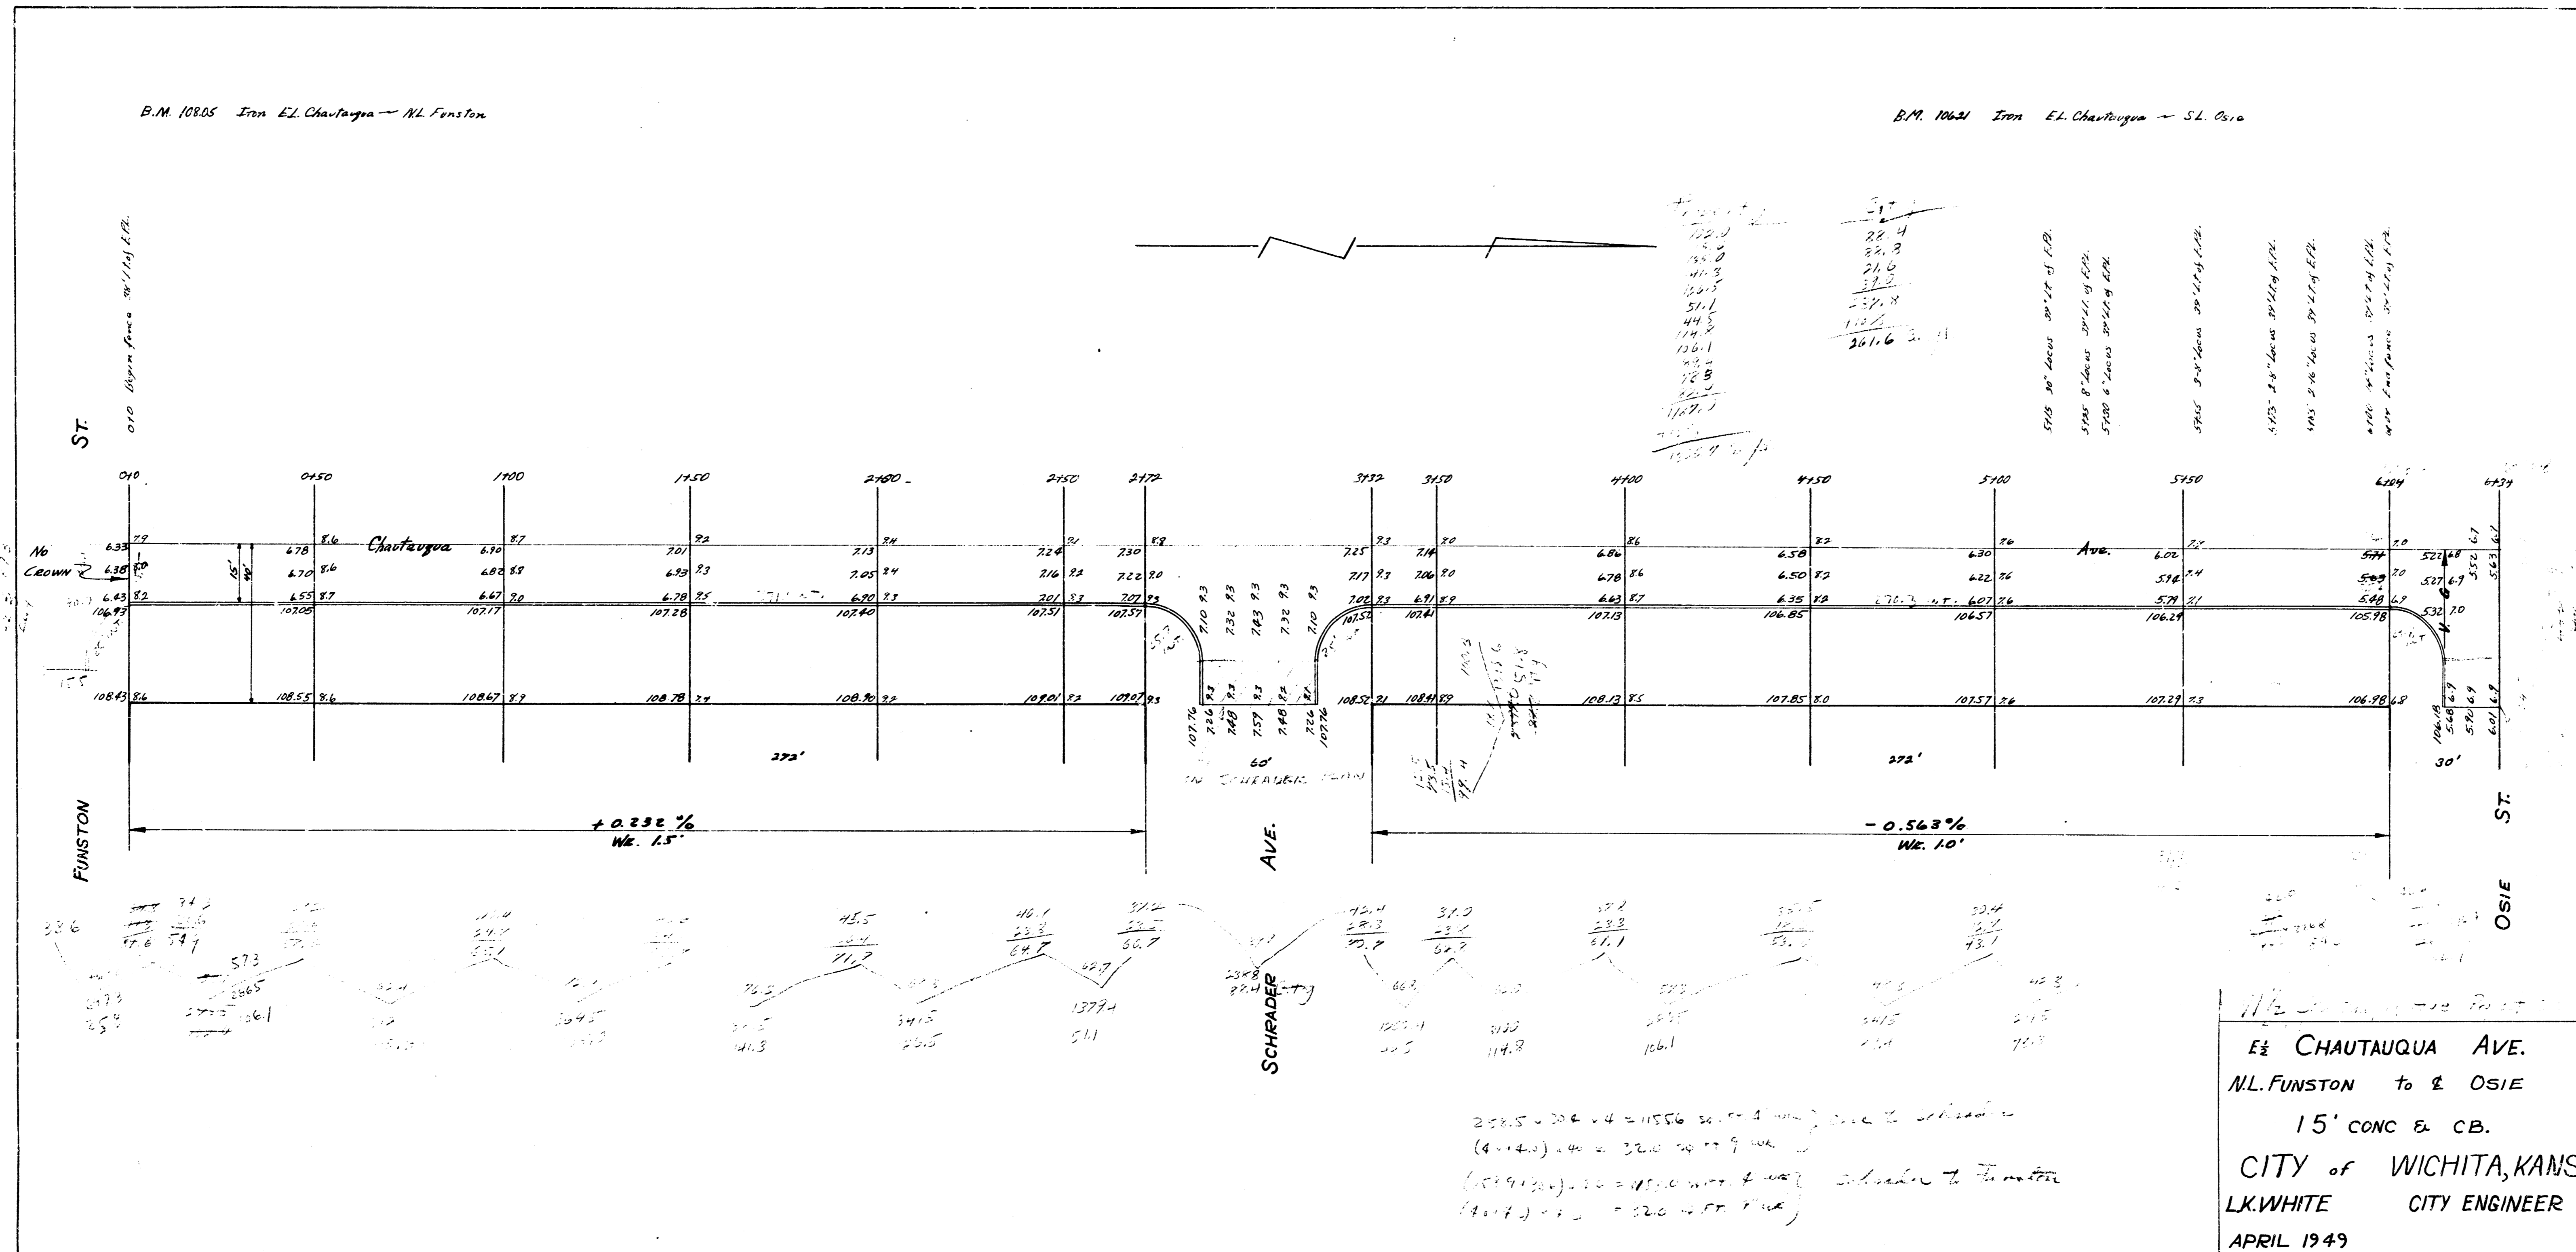

E & CHAUTAUQUA AVE.
 N.L. FUNSTON to & OSIE
 15' CONC & CB.
 CITY of WICHITA, KANS.
 LKWHITE CITY ENGINEER
 APRIL 1949


