


B.M. 13892 S.W. COR CONC. PORCH 2912 MOSSMAN
 B.M. 14212 N.E. COR CONC. PORCH NO. 153 N. CHAUTAUQUA
 B.M. 13656 N.W. COR MOSSMAN S.W. 1/4 CHAUTAUQUA
 B.M. 13688 S. C. B.

103.1
 52.2
 3.3
 2.1
 13.5
 91.5
 134.3
 278.0
 +10.0%
 457.8 cu yds

47.1
 22.8
 18.9
 14.2
 3.1
 61.9
 22.2
 27.2
 +10.0%
 326.9 cu yds

22.8 cu yds
 61.6
 1300
 53.0
 3.5
 84.4
 27.9
 16.0
 18.9 cu yds
 307.6
 10.5
 26.2
 36.7
 36.2

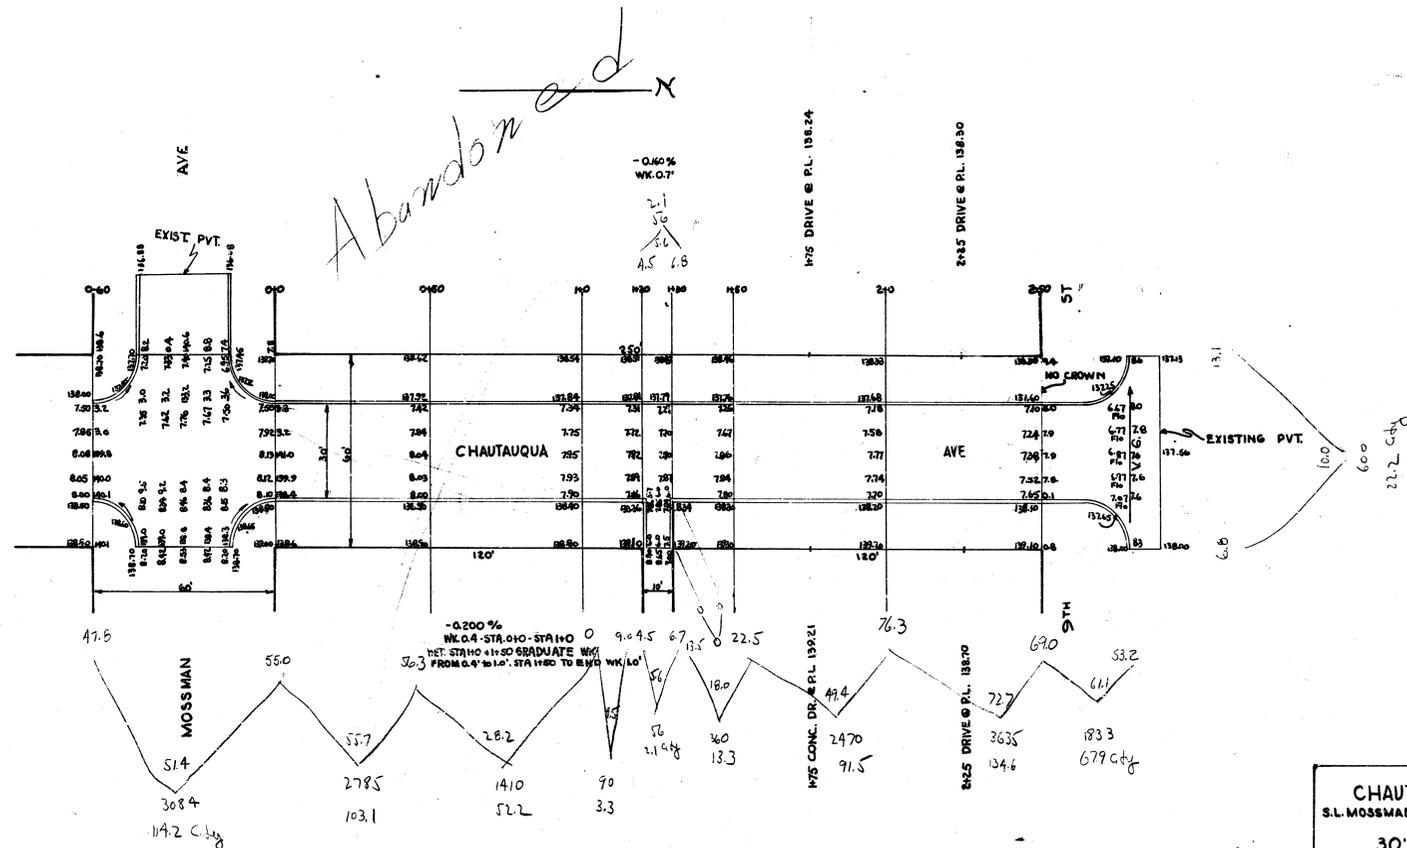

CHAUTAUQUA AVE
 S.L. MOSSMAN TO S.L. 5TH
 30' CONC. & C.B.
 CITY OF WICHITA, KANSAS
 L.K. WHITE CITY ENGINEER
 MARCH 1947

4 14 4 3