


BK-CHM 65

BM. 154.50 "6" in Globe Ecb. Erie, SL. 21st
BM. 146.45 "9" in 1942 Ecb. Chautauque, NL Shadybrook.
BM. 151.72 NE cor. conc. porch Ho. # 2127 N. Chautauque.

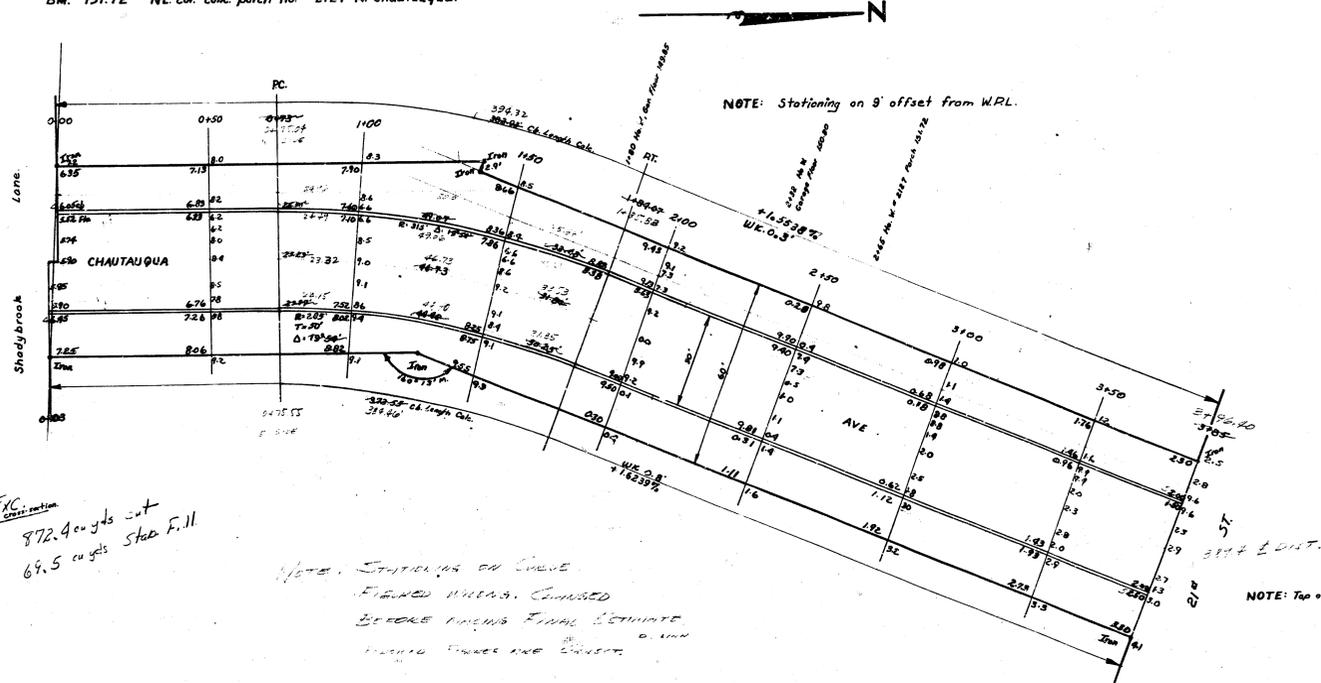

Total Exc. ^{excavation}
Property - 872.4 cu yds cut
69.5 cu yds State Fill

City - 0

NOTE: STATIONING ON CURVE.
FIELD MEAS. CHECKED
BEFORE MAKING FINAL ESTIMATE

146

Chautauque Ave.
NL Shadybrook Lane to SL. 21st St
30' Conc. & Ck
City of Wichita, Kansas
L. K. White City Engineer
October 1950 Proj. No. C10-113