

BM. 163.95 "X" in W. rim of M.H. 6' E. 1' 45" SE of Vet. Hosp. fence cor.

Exc.

PROP



75.7
78.5
70.4
71.4
47.6
87.8
89.0
74.4
79.3

Notes: 250' West from W.L. Christine to edge of paving
on Orme, E.L. Casaloma

South: 2.83 cu. yds.
North: 3.43 cu. yds.

CITY

711
232
162
155
146
146.6 C.Y.
761.2

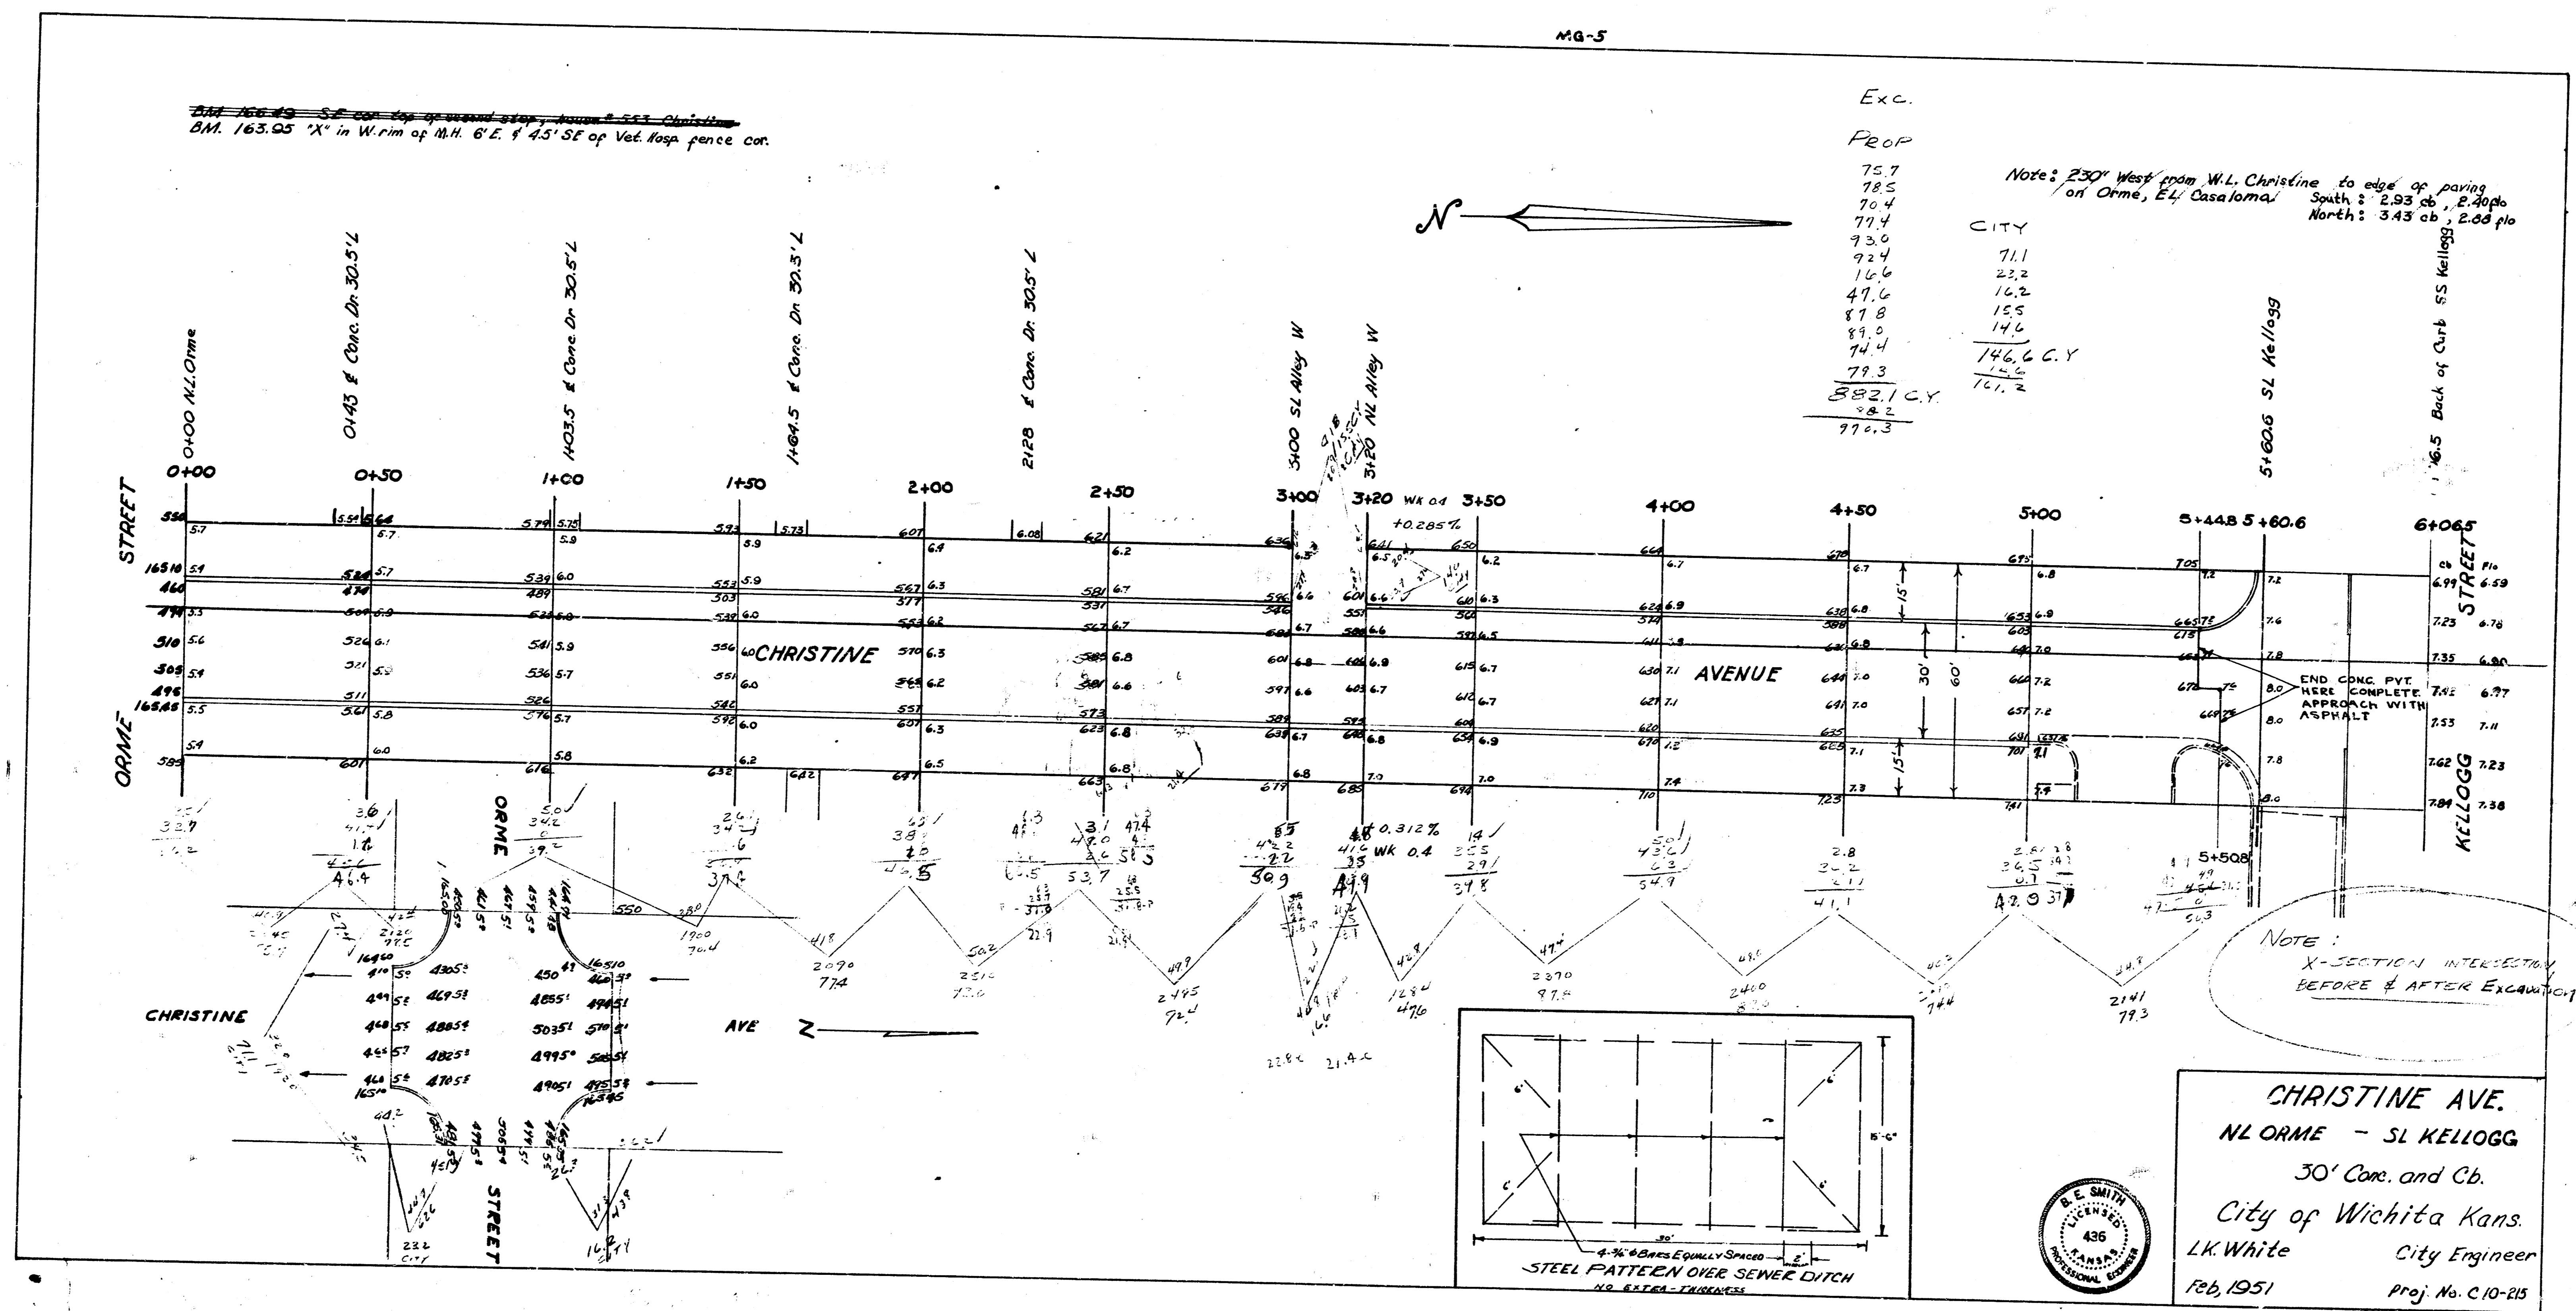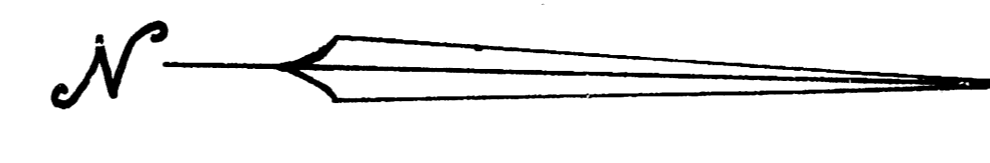

NOTE:
X-SECTION INTERSECTION
BEFORE & AFTER EXCAVATION

CHRISTINE AVE.
NL ORME - SL KELLOGG
30' Cor. and Cb.
City of Wichita Kans.
L.K. White City Engineer
Feb, 1951 Proj. No. C-10-215

