BM. 99.54 "X" Top Rad. 0.5' N. CB NW Cor. Clark & Market.

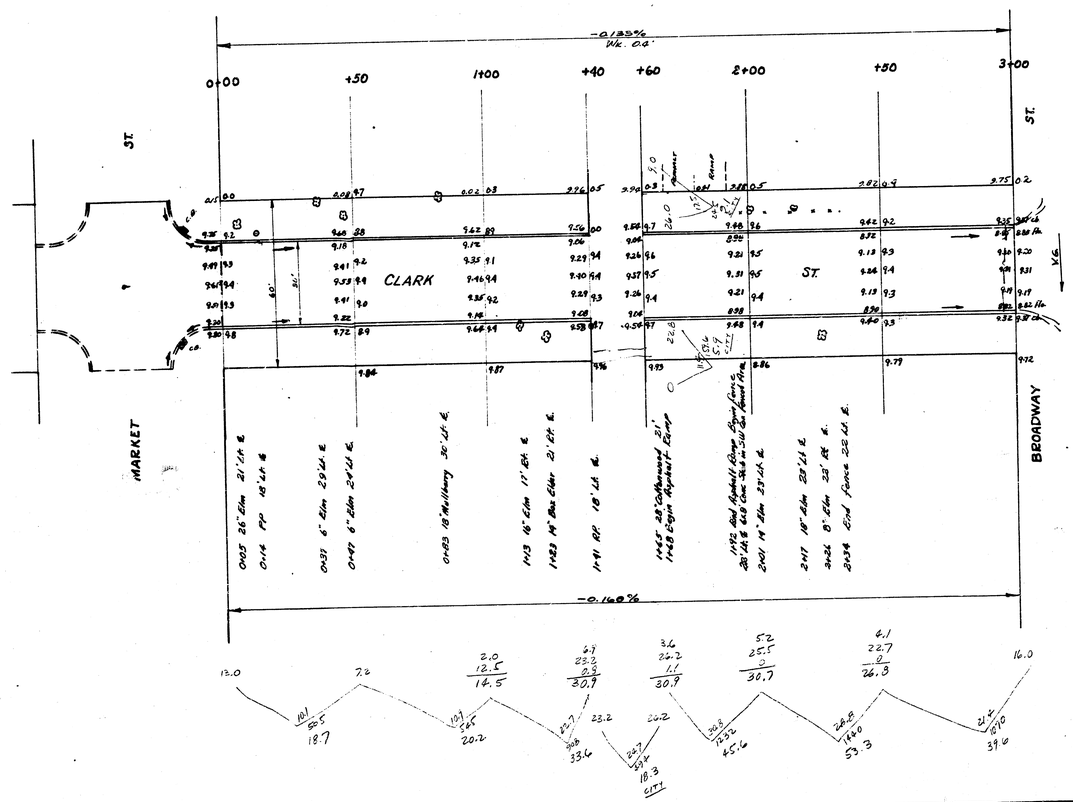

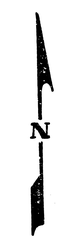

CLARK ST.

WL Market St. — WL Broadway St.

30' Conc. & Ch.

City of Wichita, Kansas

L. K. White — City Engineer

Aug. 1950 — Proj. No. C10-108