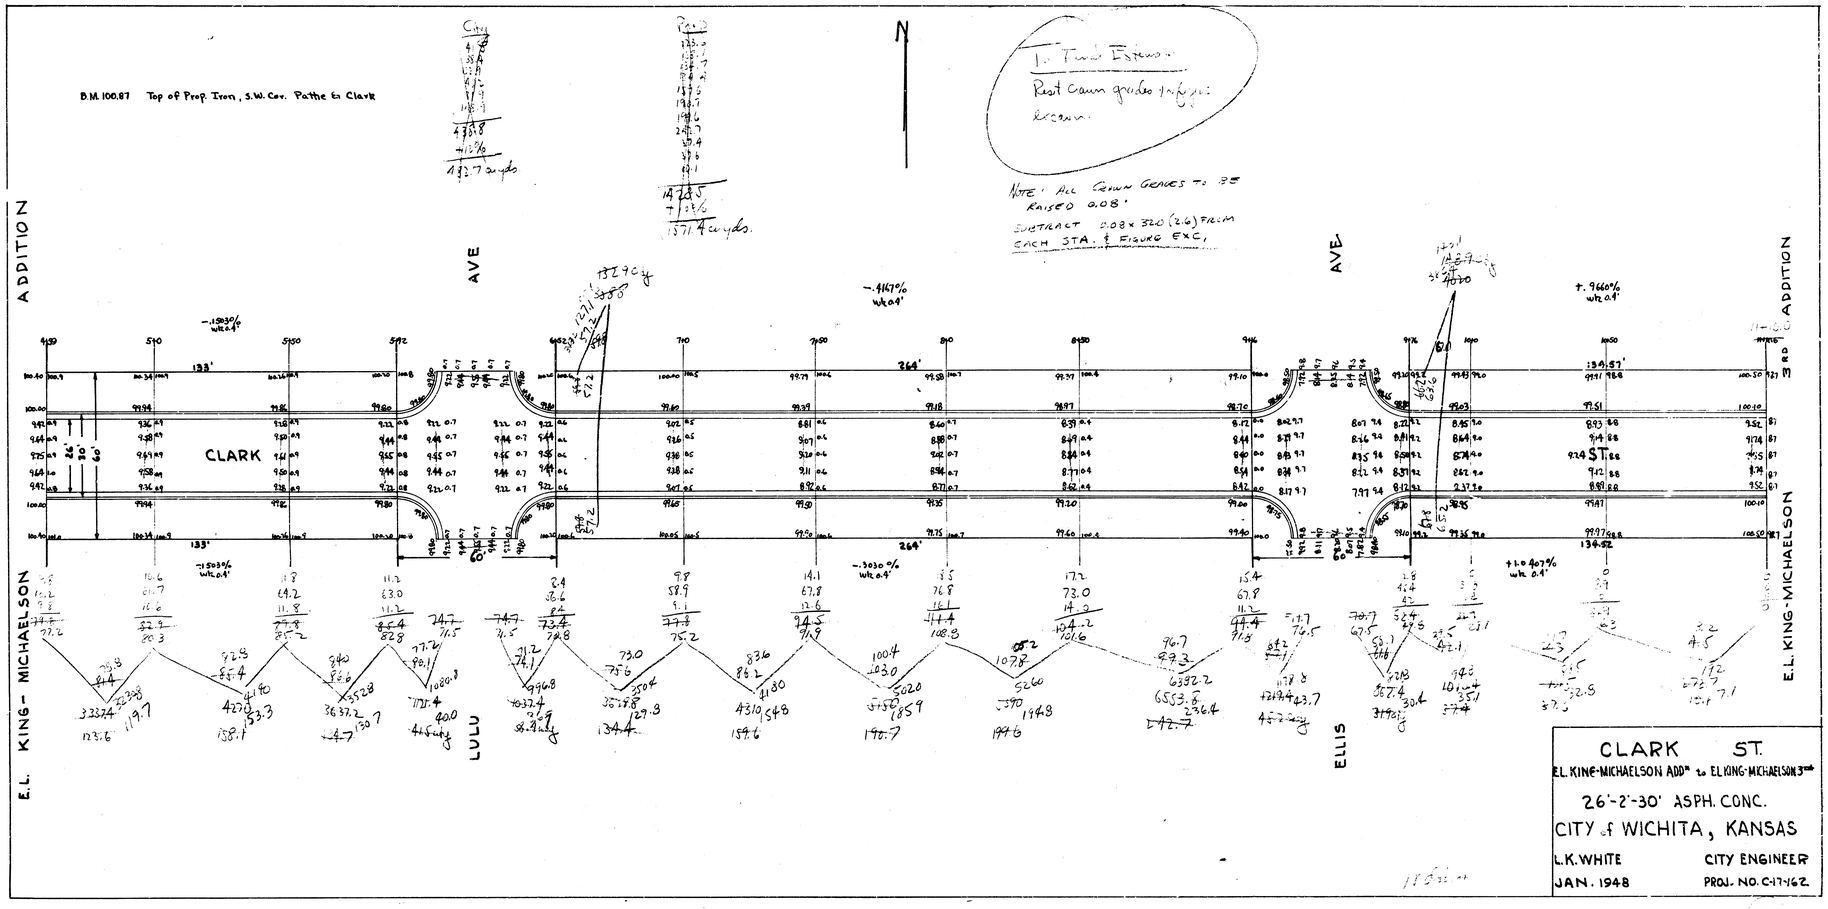
B.M. 100.87 Top of Prop. Iron, S.W. Cor. Pattie & Clark
N
Note: All Crown Grades to be Raised 0.08'
Subtract 0.08 x 32.0 (2.6) from each Sta. & Figure Exc.
ADDITION
AVE
CLARK
ST.
LULU
ELLIS
E.L. KING-MICHAELSON
-.1539% wk 0.4'
-.4167% wk 0.4'
+.9660% wk 0.4'
-.1503% wk 0.4'
-.3030% wk 0.4'
+1.0407% wk 0.4'
133'
264'
134.52'
60'
CLARK ST.
EL. KING-MICHAELSON ADDn to EL. KING-MICHAELSON 3rd
26'-2'-30' ASPH. CONC.
CITY of WICHITA, KANSAS
L.K. WHITE CITY ENGINEER
JAN. 1948 PROJ. NO. C-17-162.