


B.M. 143.49 N.E. COR. BOTTOM CONC. STEP No. 827 W. ARMOUR DR.
 B.M. 144.97 N.E. COR. BOTTOM CONC. STEP No. 745 W. ARMOUR DR.
 B.M. 156.20 1/2" S.W. S.S. H.P. 23" N. OF N.W. CLAY 129° E. OF W.L. ROCK ROAD.
 B.M. 150.69 3/4" S.W. S.S. H.P. 100" N. OF N.W. WATSON 128° E. OF W.L. ROCK ROAD.

Sta On 98 Offset From S.E.




CURVE DATA
 R=44872 6° E. S. Ch. 448° 56' 30"

Sta	Chord	Chord	Dist.	Tot. Opp.
0+00	PC			
0+25	25.00	22.65	1°35'46"	1°25'46"
0+50	25.00	22.65	1°35'46"	3°11'32"
0+75	25.00	22.65	1°35'46"	4°47'18"
1+00	25.00	22.65	1°35'46"	6°23'04"
1+25	25.00	22.65	1°35'46"	8°08'50"
1+32.88	7.88	6.96	0°27'25"	8°28'15"

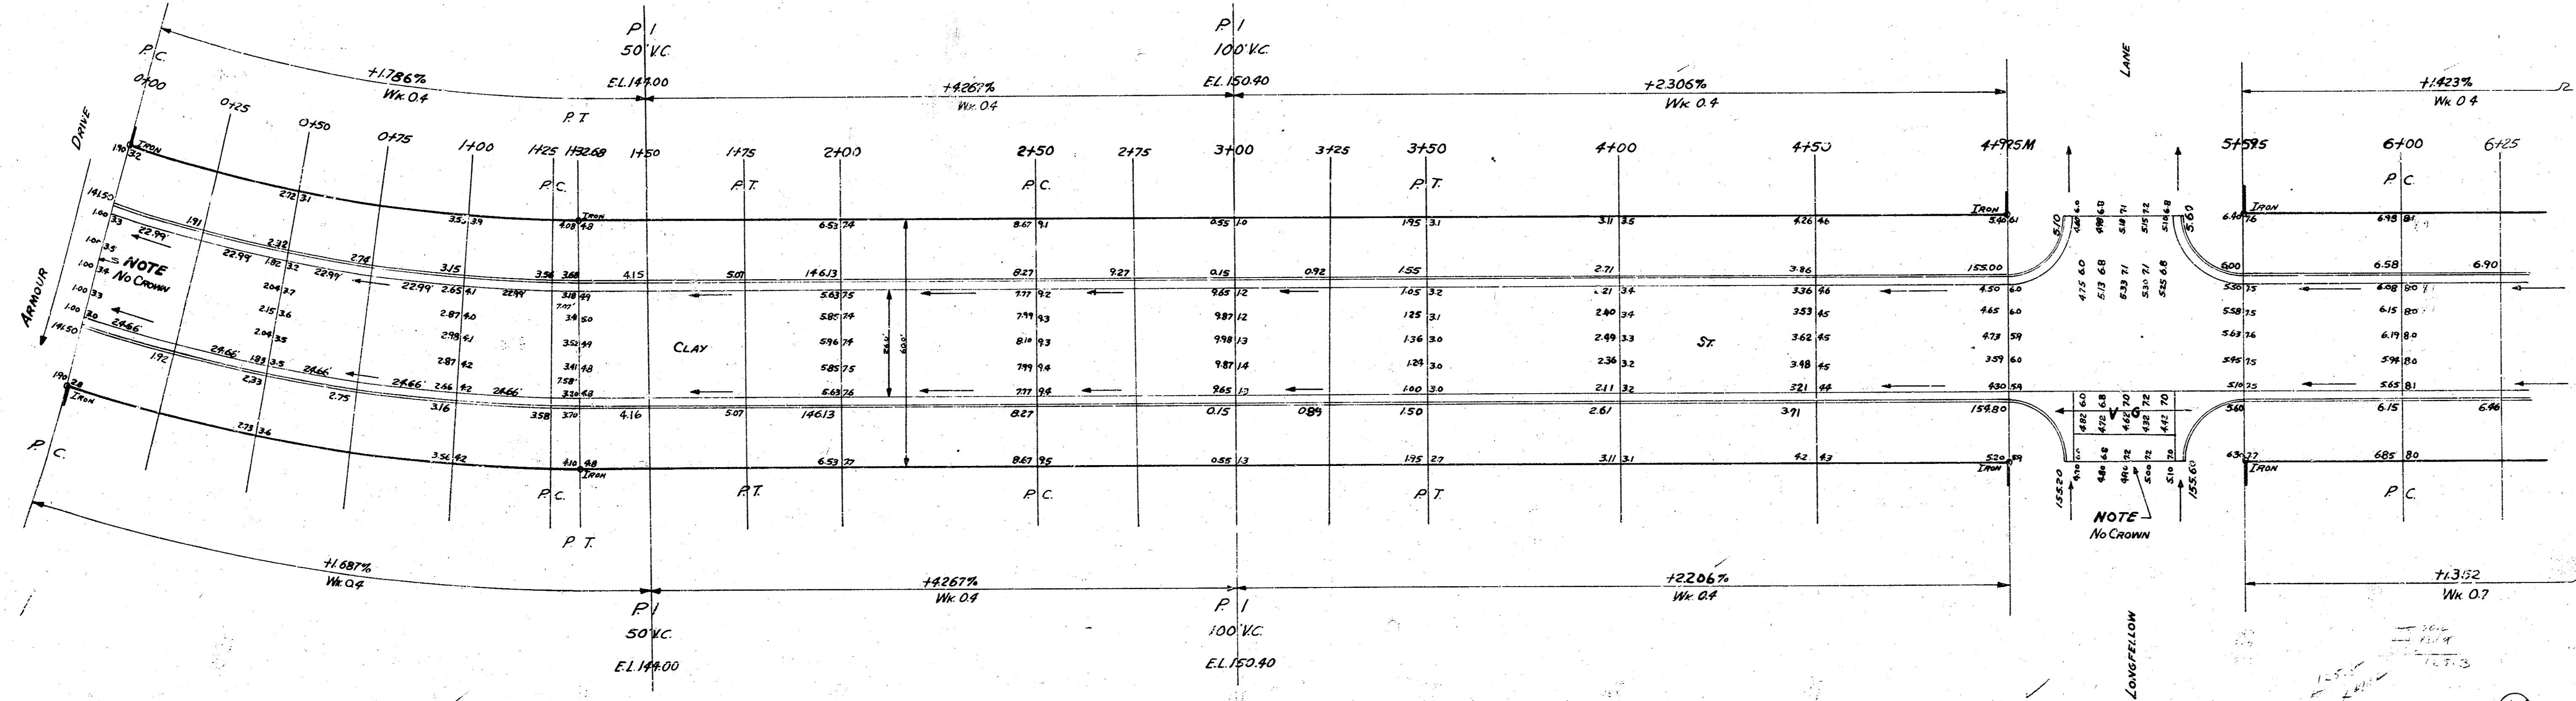

CLAY STREET
 EL. ARMOUR DR To W.L. ROCK ROAD
 26-2-30 A.C.
 CITY OF WICHITA, KANSAS
 B.E. SMITH CITY ENGINEER
 1953 Proj. No. C18-164



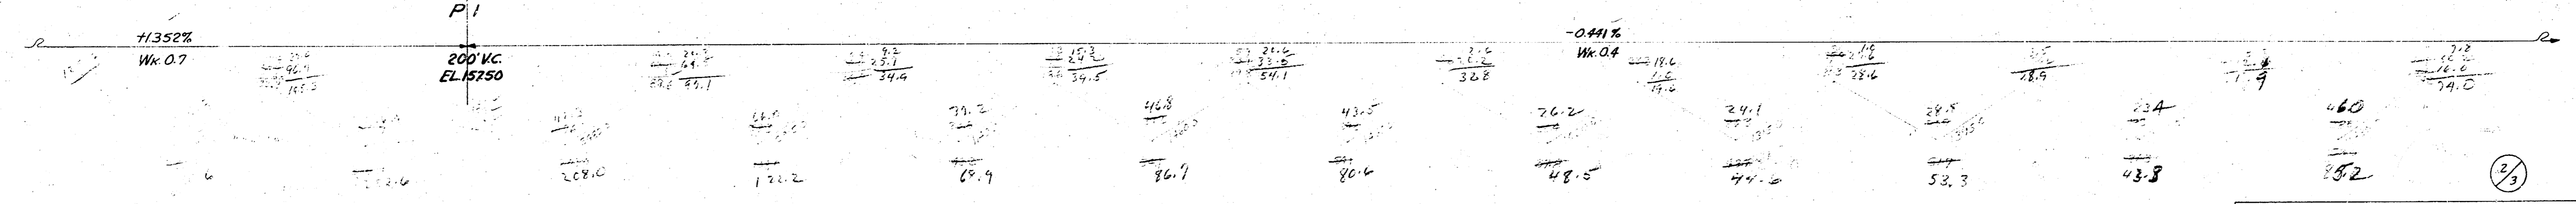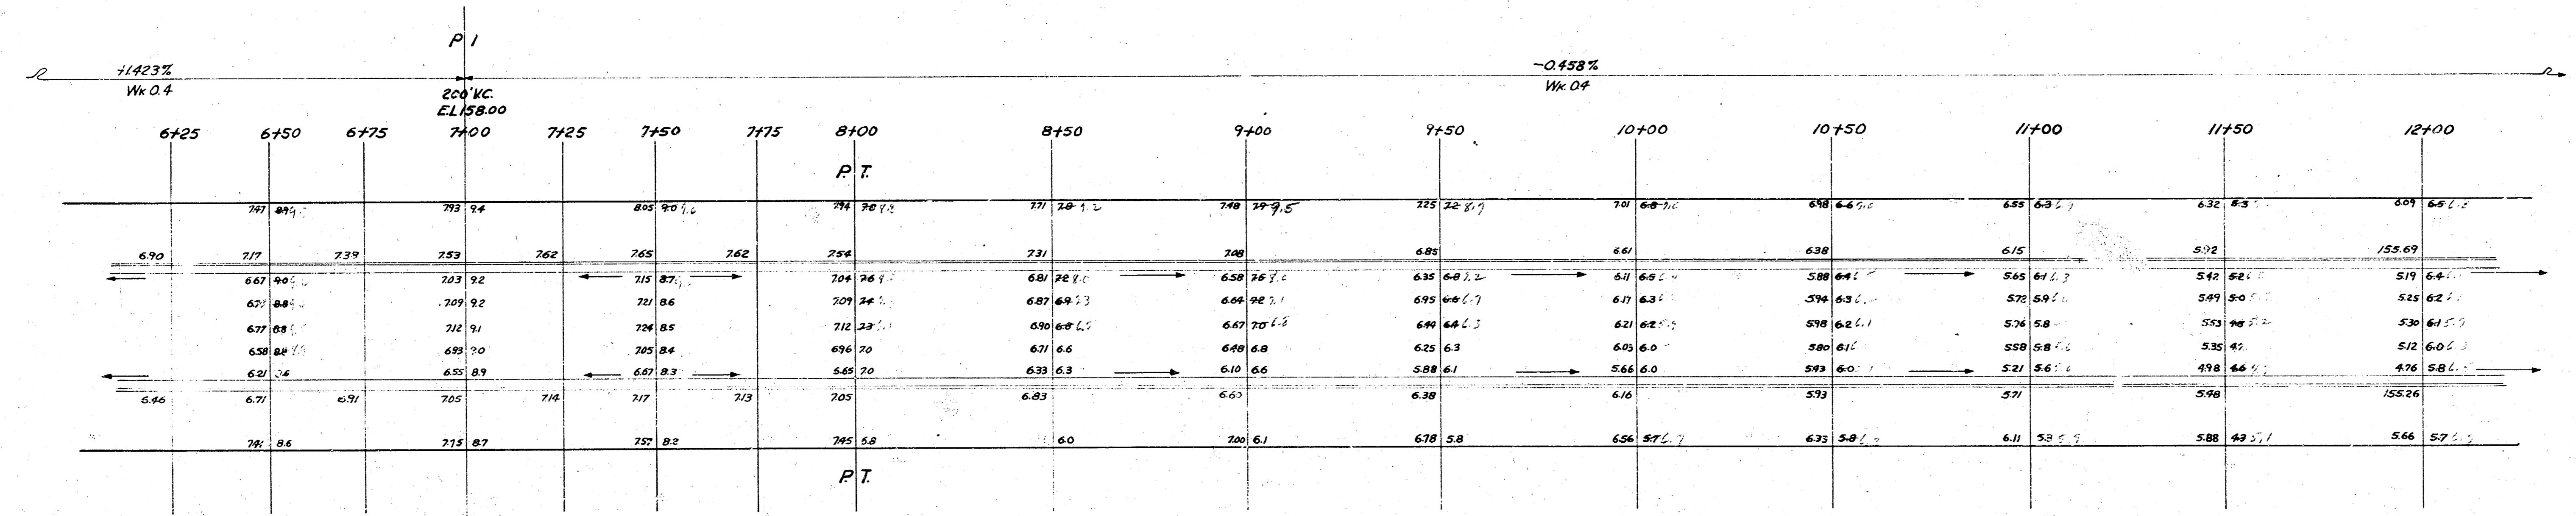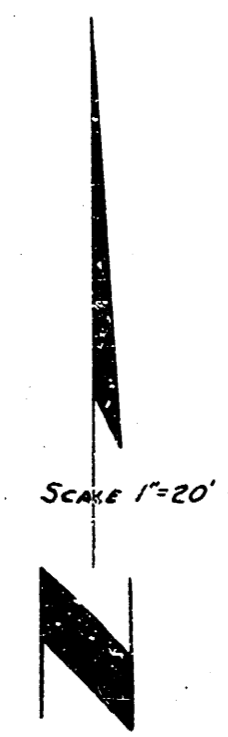

CLAY ST
 Proj. No. C14-164

BM 15620 3/4" Spw S.S.H.P. 23° N. of N.E. Clay 129° E. of W/E Rock Road.
 BM 15069 1/2" Spw S.S.H.P. 100° N. of N.E. Watson Lane, 128° E. of W/E Rock Road.
 Sta on 9' Offset from S/E

