



B.M. 126.35 60" Spike E.S. PP. W.S. Richmond & N.L. Bonaparte Hills 2nd Addn.  
 B.M. 123.00 NW cor. cane patch, Ho. N.E. cor. Halstead & 25th  
 Chained E. on N.E.

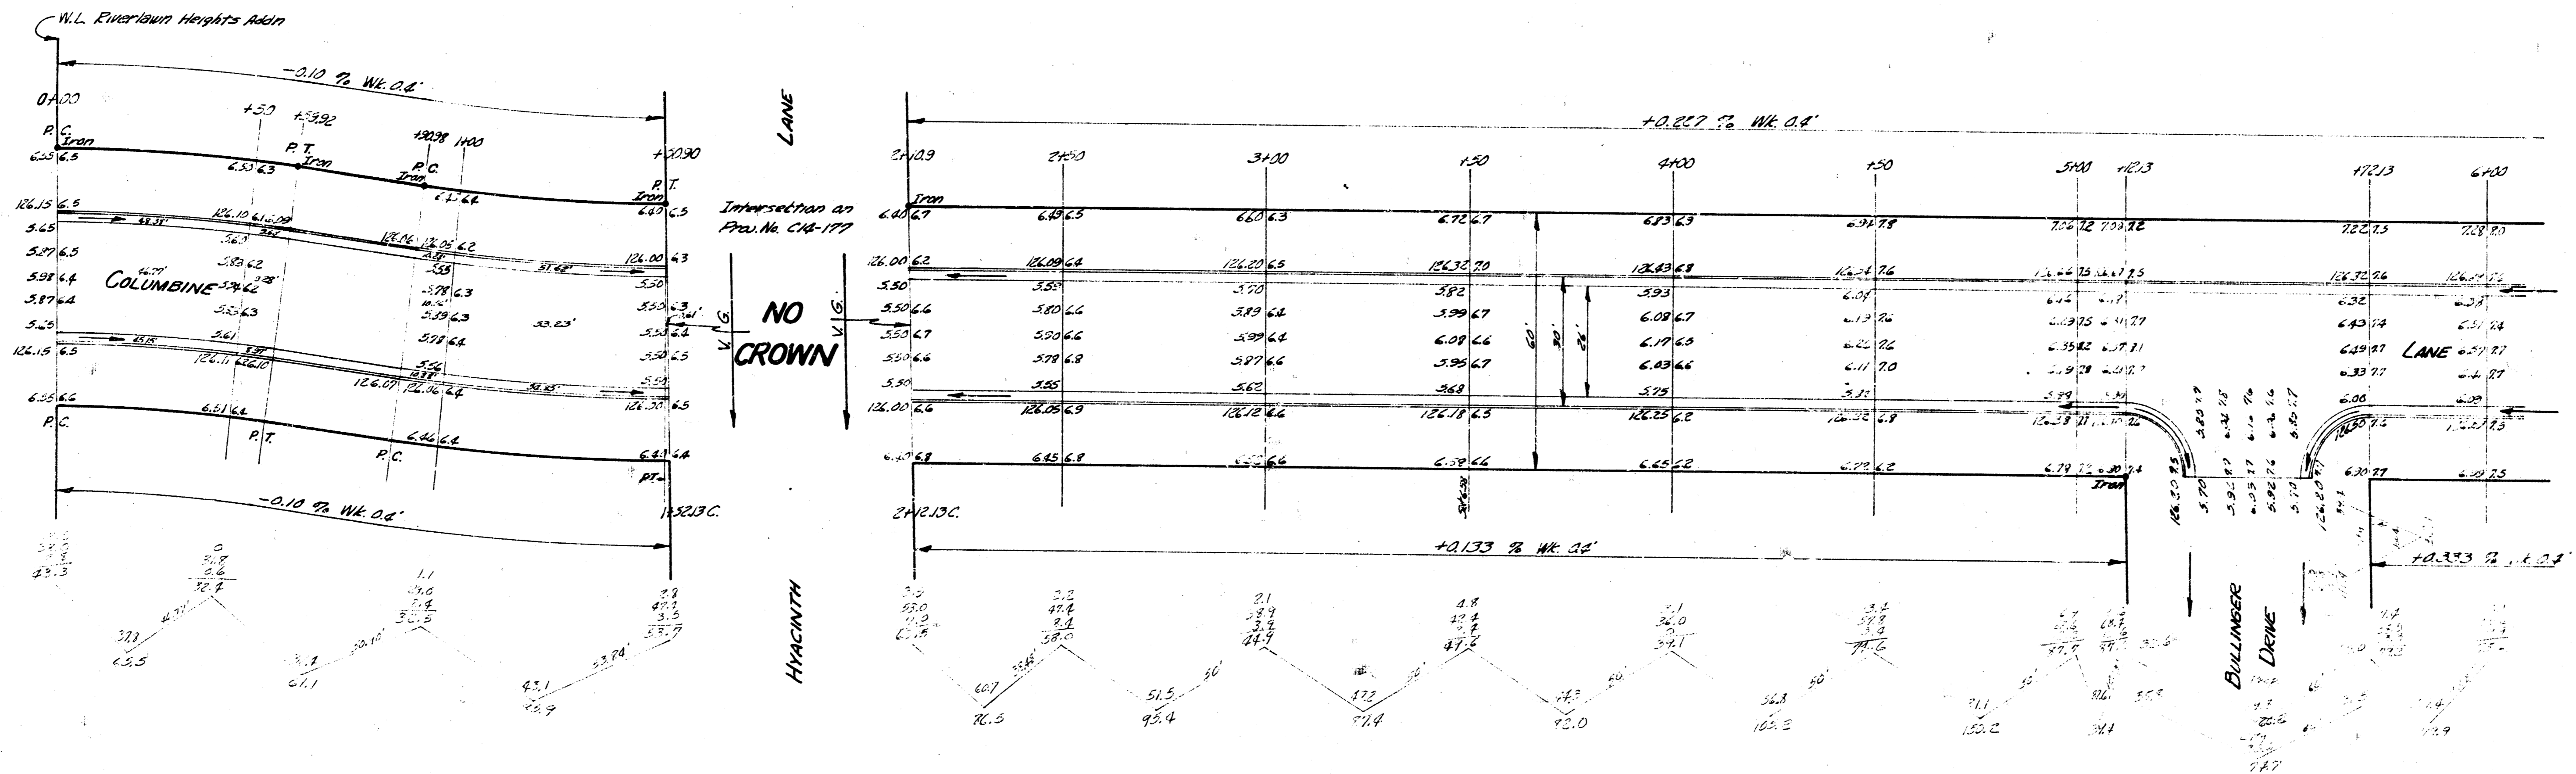





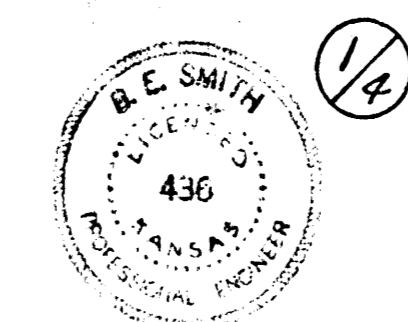

**COLUMBINE**  
 W.L. RIVERDAWN HEIGHTS ADDN. TO W.L. HALSTEAD  
 26-2-30 A.C.  
 CITY OF WICHITA KANSAS  
 B.E. SMITH CITY ENGINEER  
 SEPT. 1954 PROJ. NO. C14-173





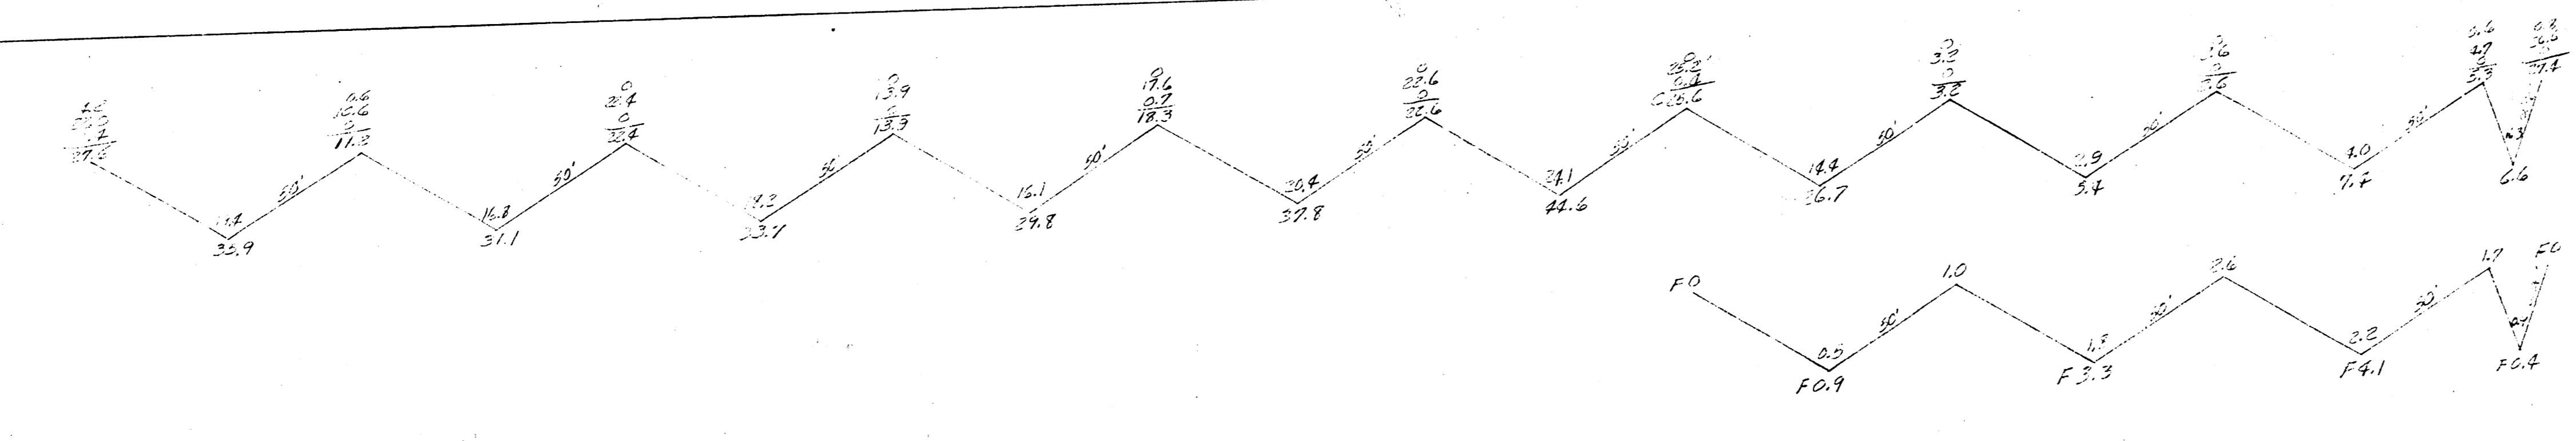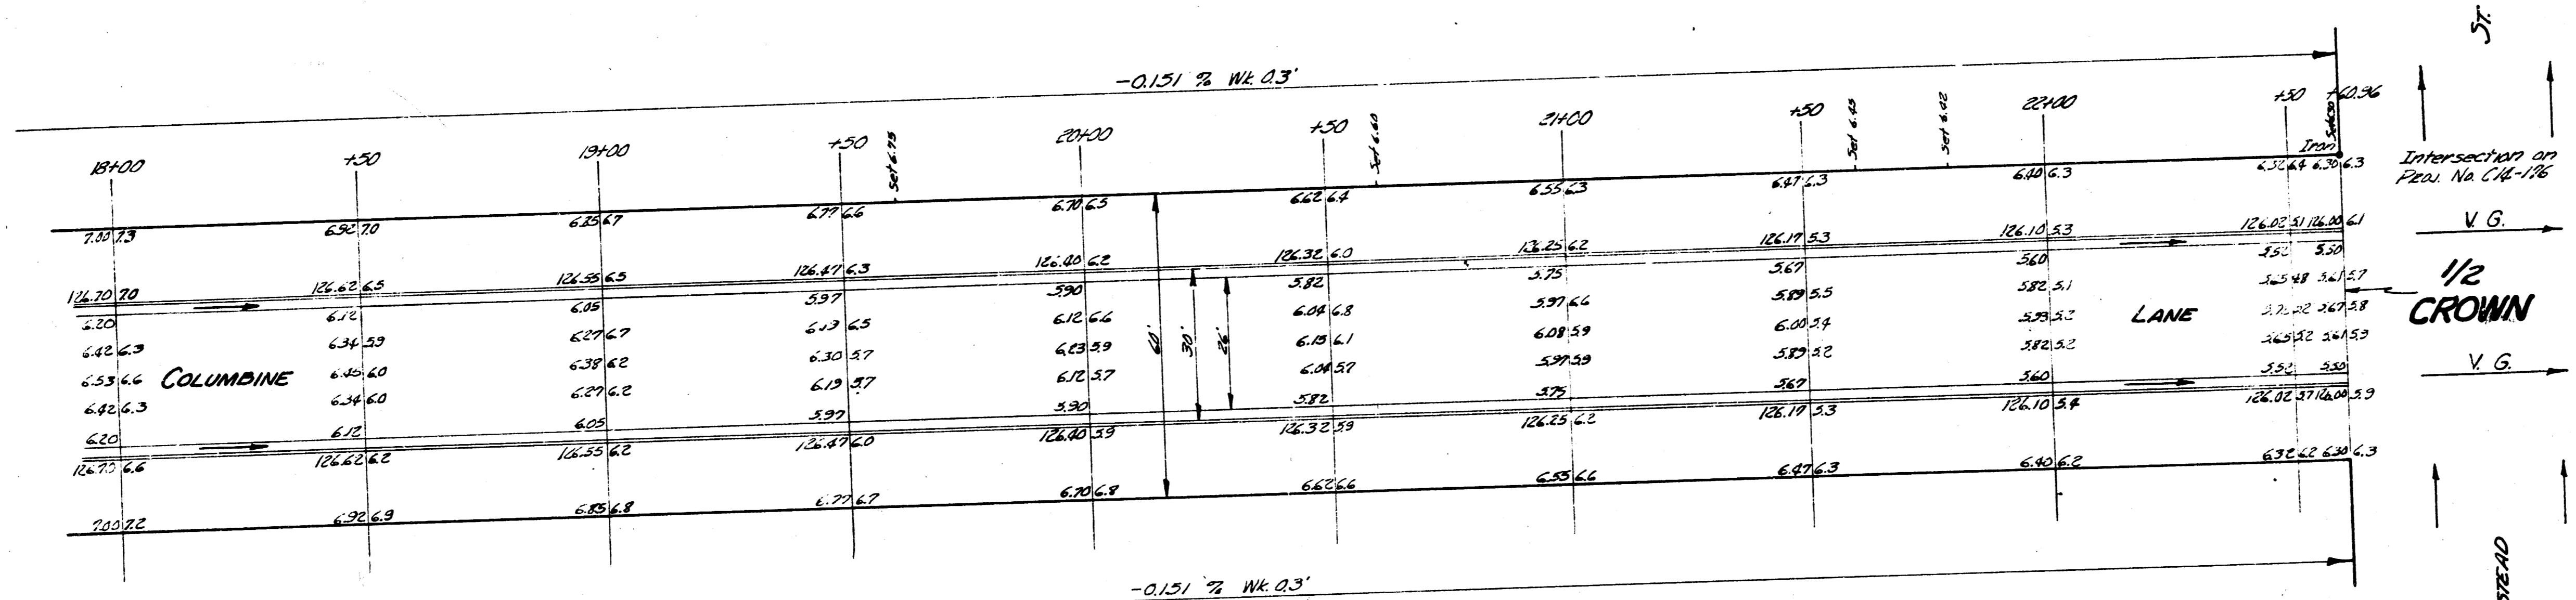

COLUMBINE  
Prop No CH-173  
9/4