1941

COOLIDGE AVE. — S.L. 16TH TO S.S. RIVERSIDE PLACE 2ND ADD^N
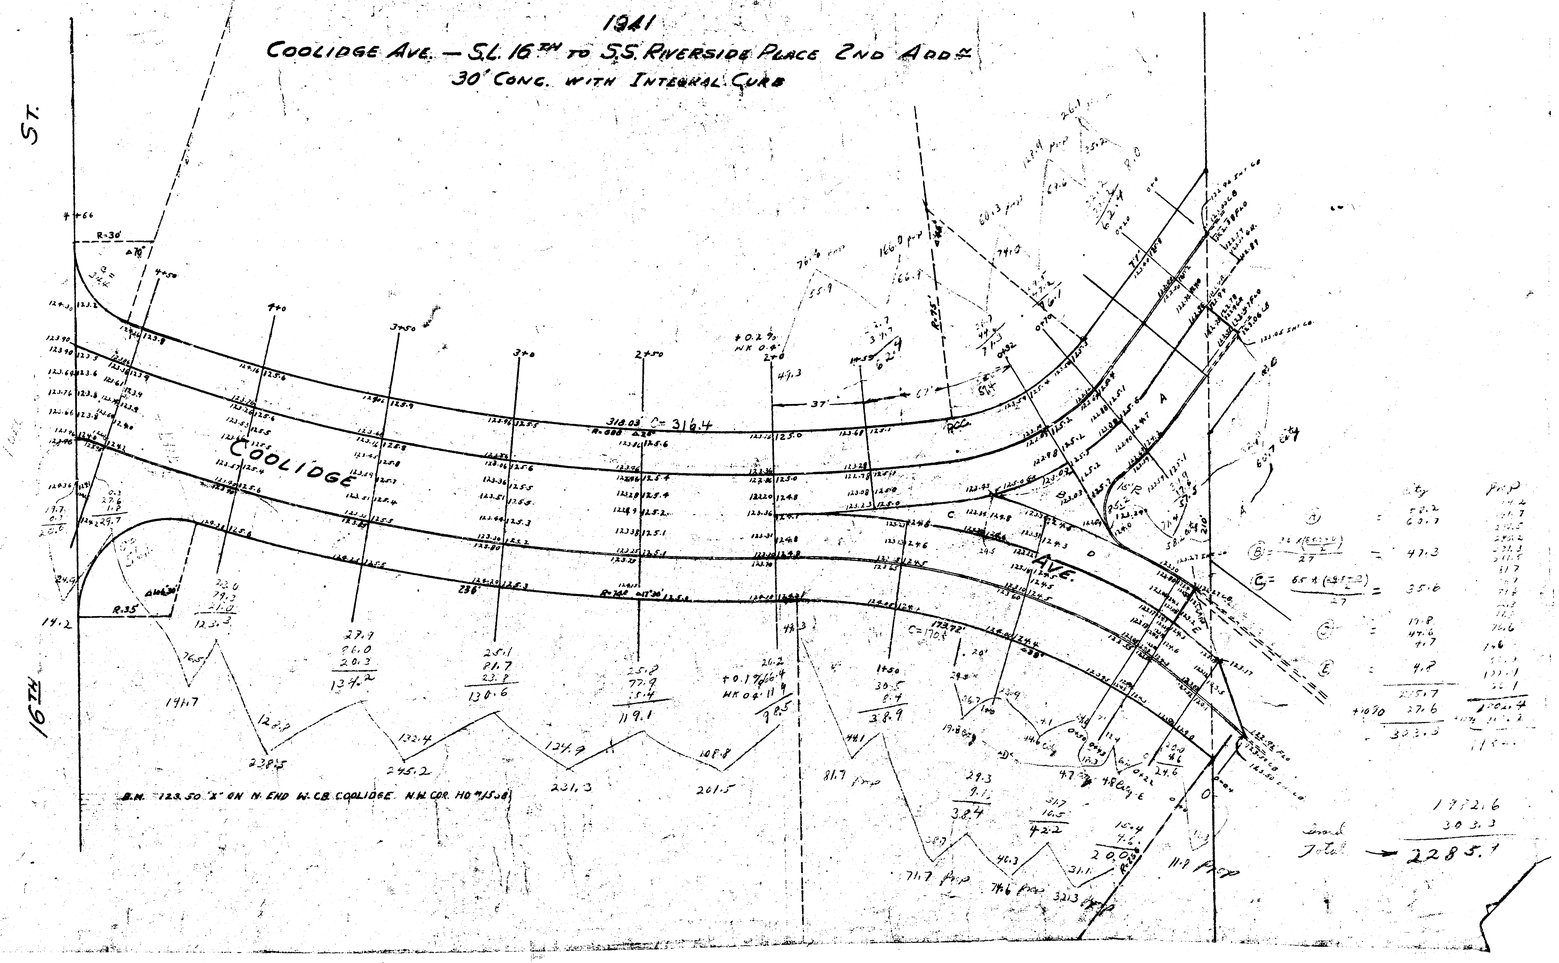
30" CONC. WITH INTEGRAL CURB