


 BASELINE IS ON E.

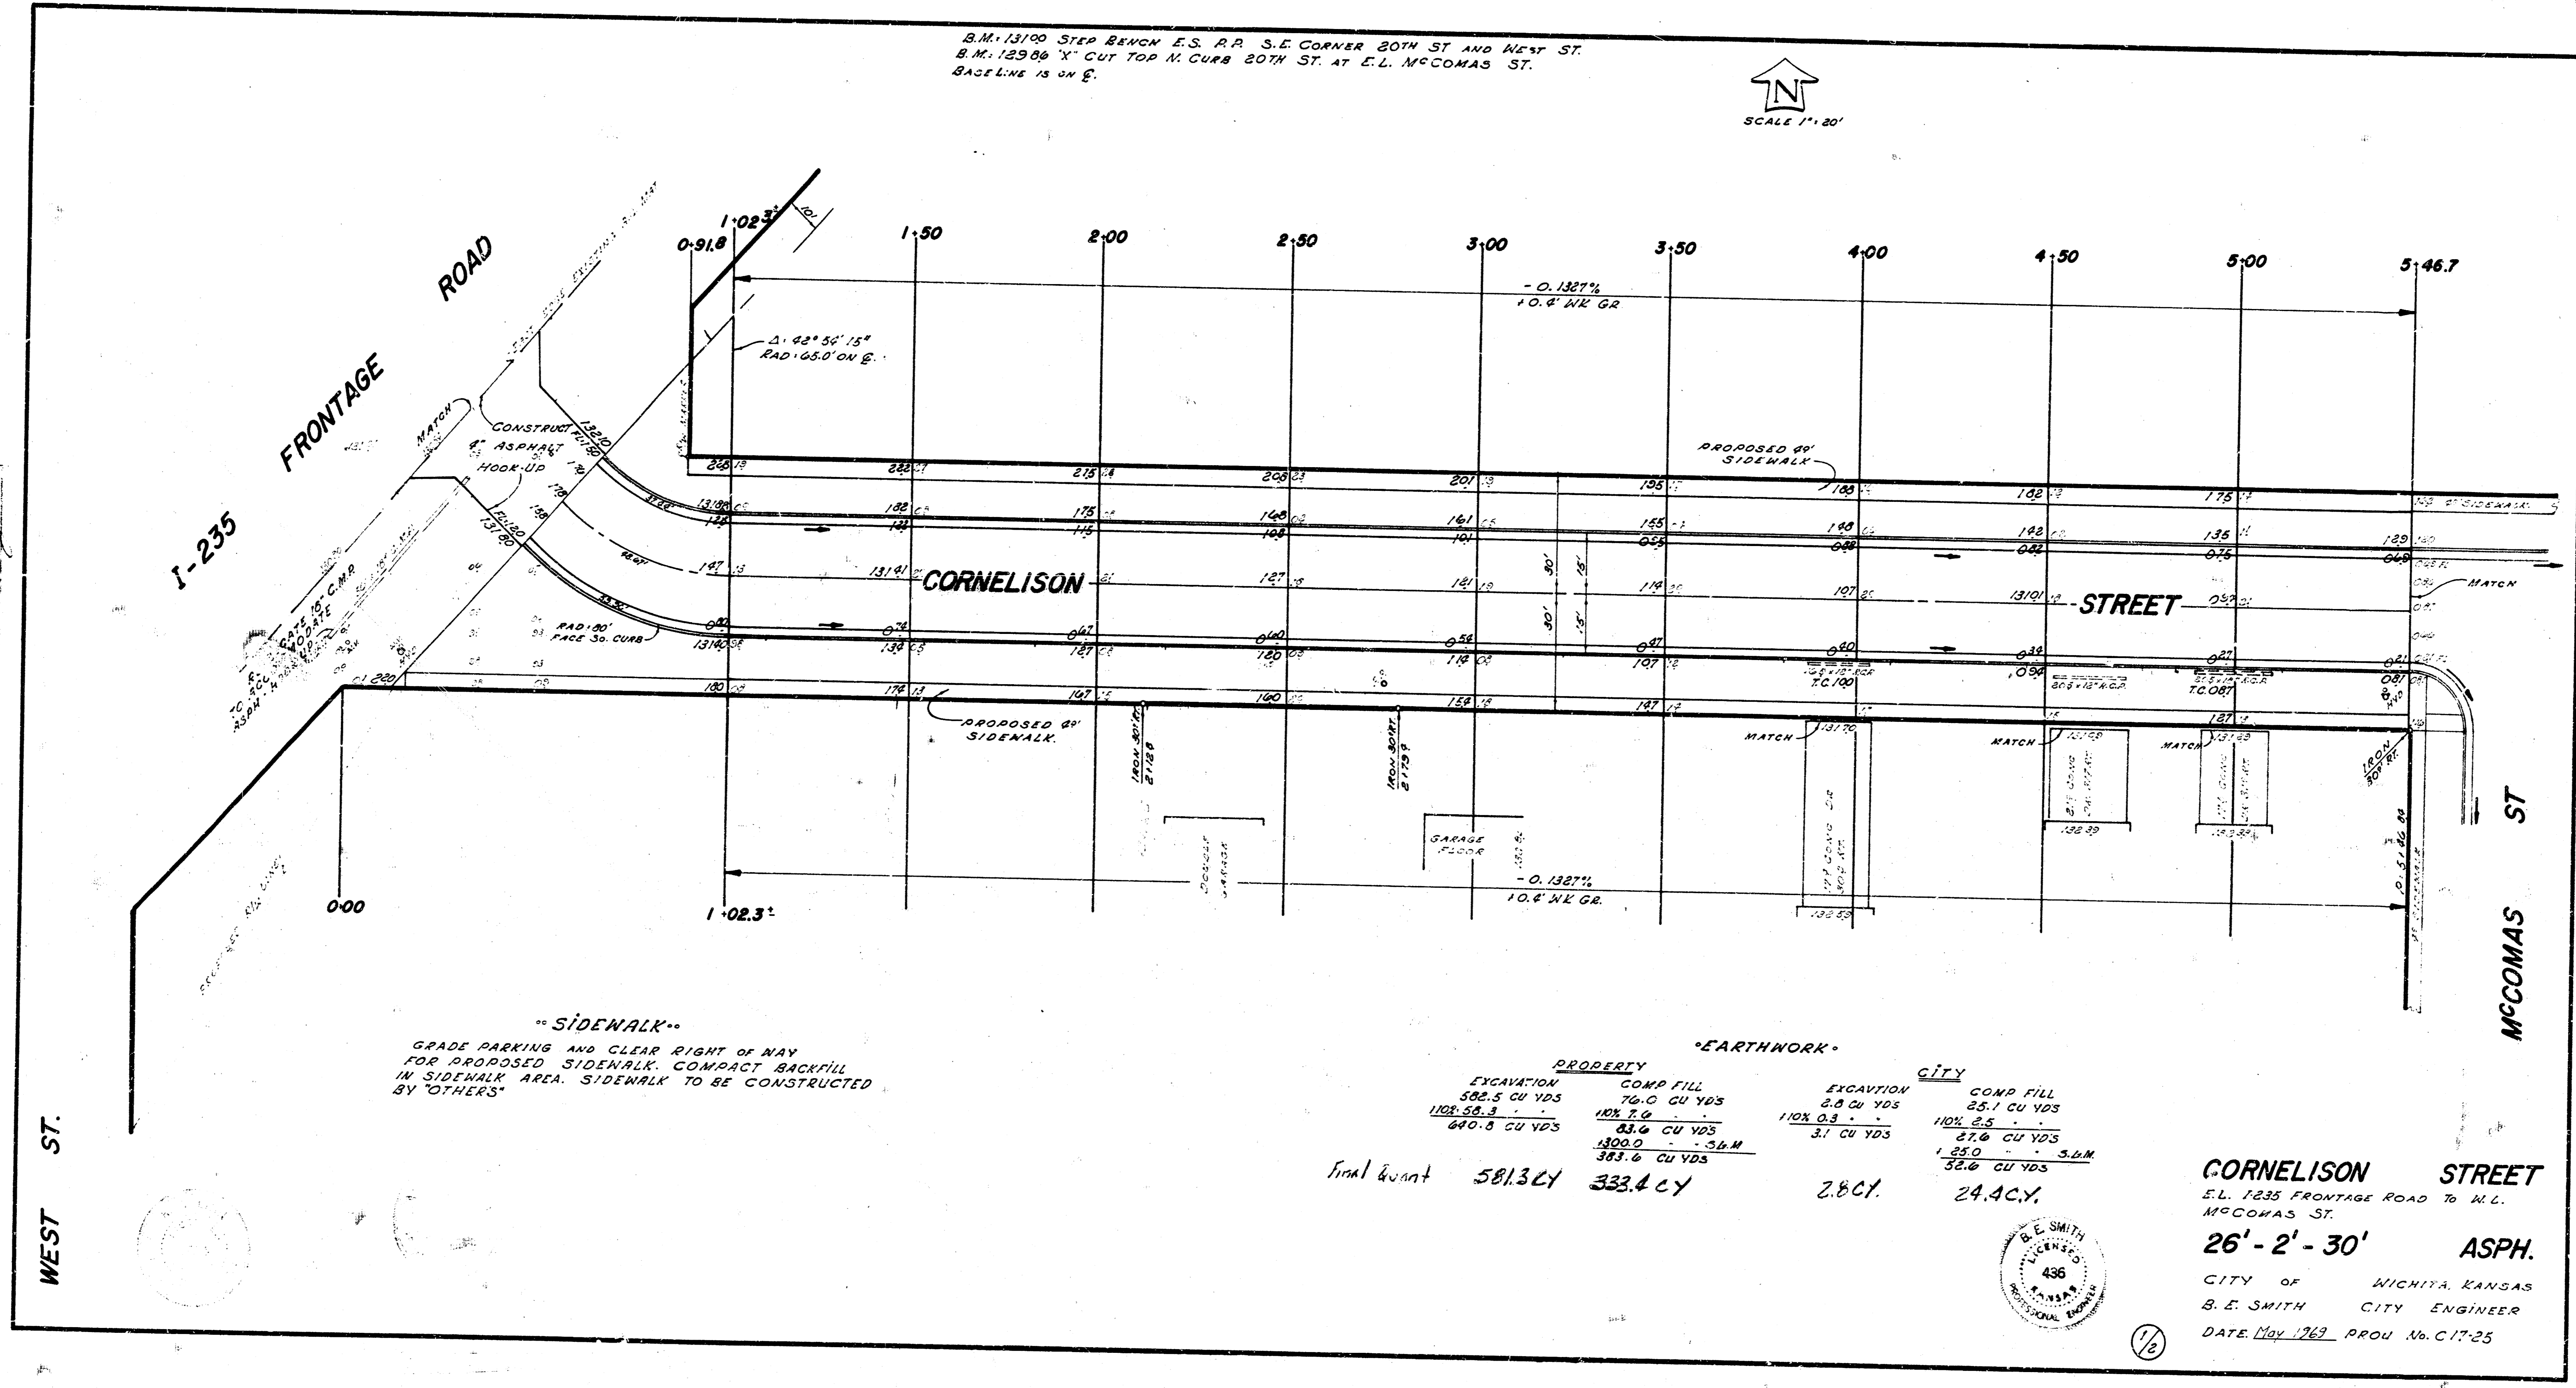

"SIDEWALK"
 GRADE PARKING AND CLEAR RIGHT OF WAY
 FOR PROPOSED SIDEWALK. COMPACT BACKFILL
 IN SIDEWALK AREA. SIDEWALK TO BE CONSTRUCTED
 BY OTHERS

PROPERTY		CITY	
EXCAVATION	COMP FILL	EXCAVATION	COMP FILL
			3.8M

Total Quant 5813.4 333.4 CY 2.8 CY 24.4 CY

CORNELISON STREET
 E.L. 1235 FRONTAGE ROAD TO N.L.
 MCCOMAS ST.
26' - 2' - 30' ASPH.
 CITY OF WICHITA, KANSAS
 B. E. SMITH CITY ENGINEER



