




CORNELISON ST.
E.L. LOT 3, BLK. I, RIVER PARK ADDITION TO E.L. BLK. I, RIVER PARK ADDITION
TYPICAL SECTIONS of 30' ASPHALTIC CONCRETE PAVEMENT

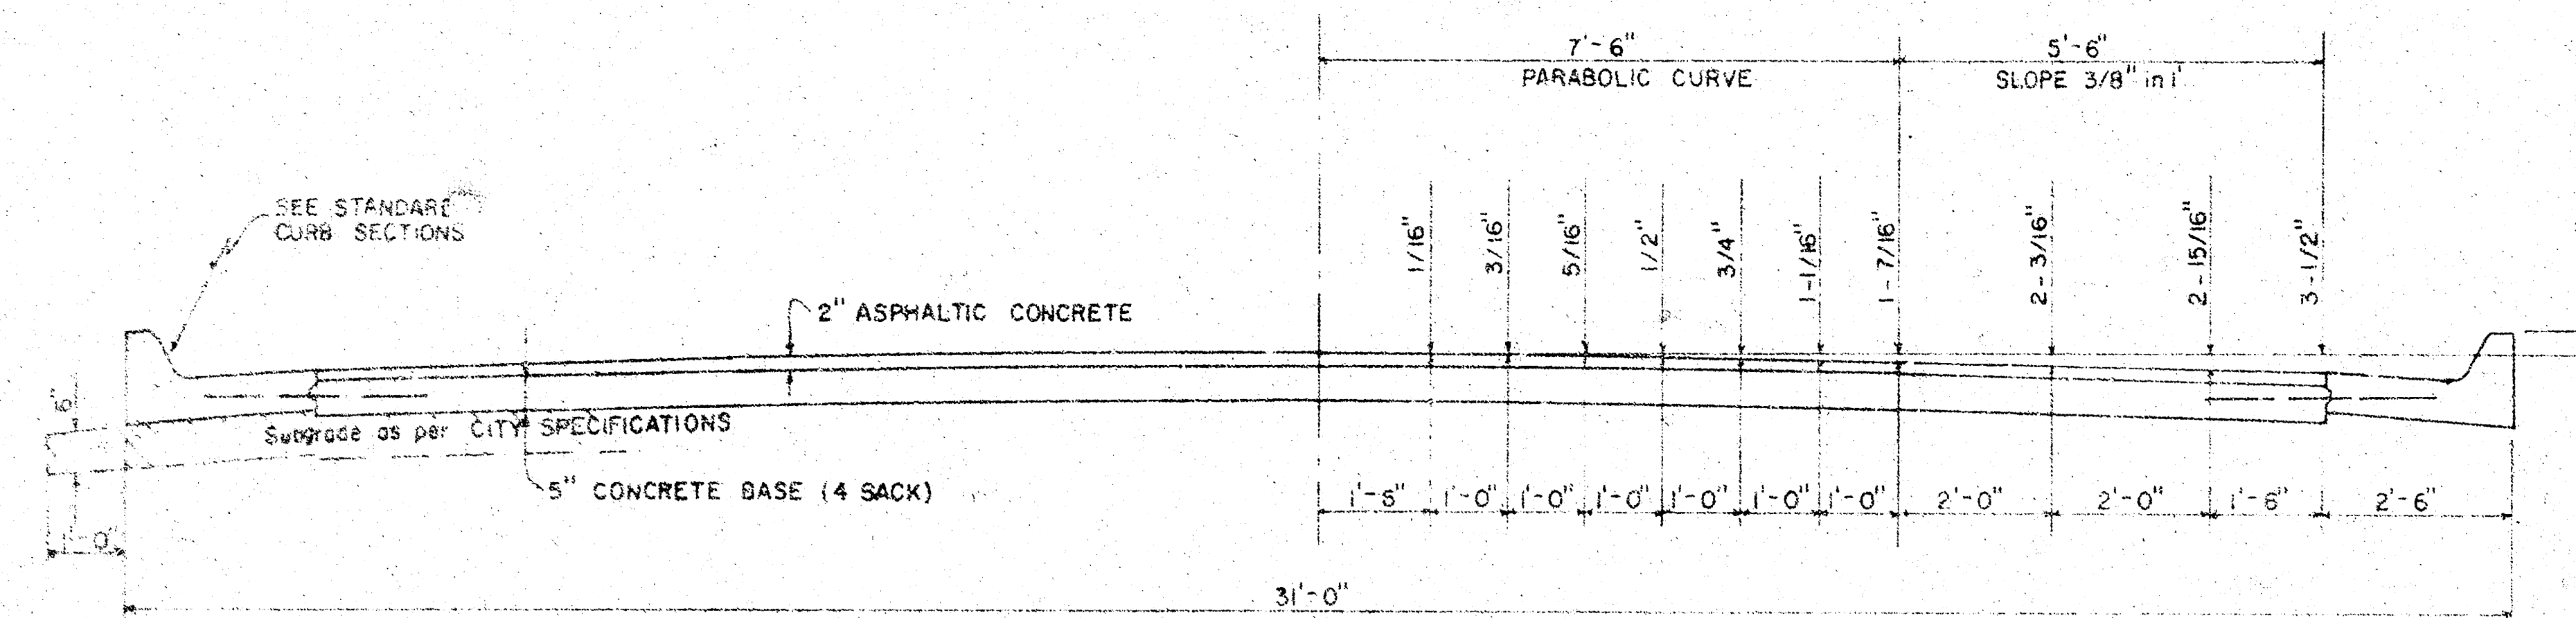


TYPICAL SECTION WITH STANDARD CROWN

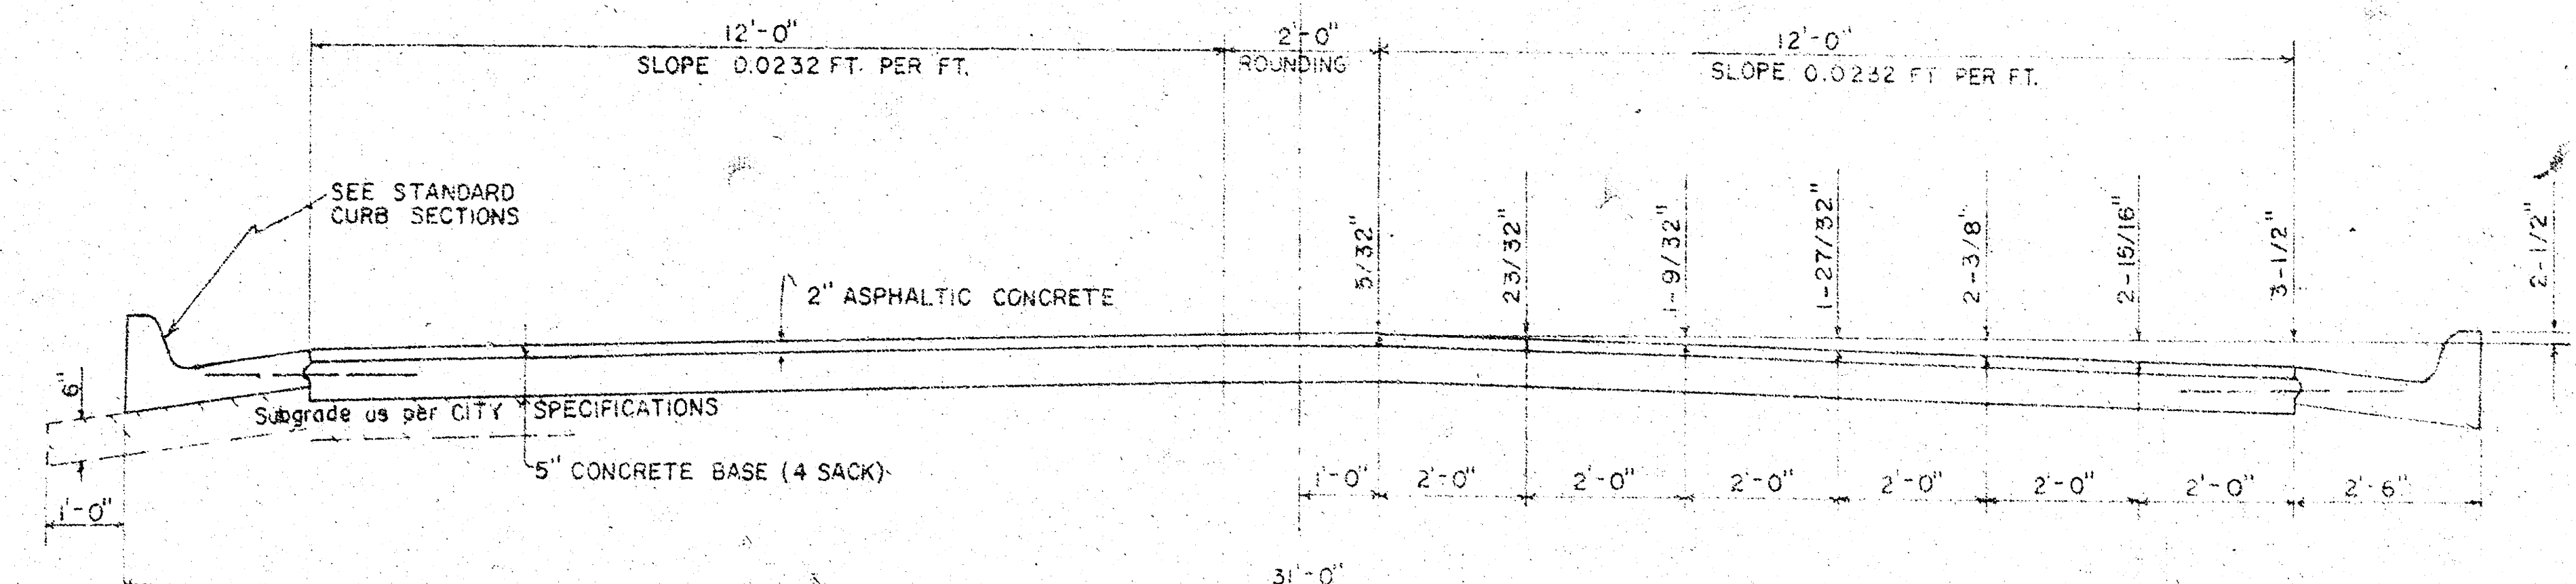


TYPICAL SECTION WITH ALTERNATE CROWN

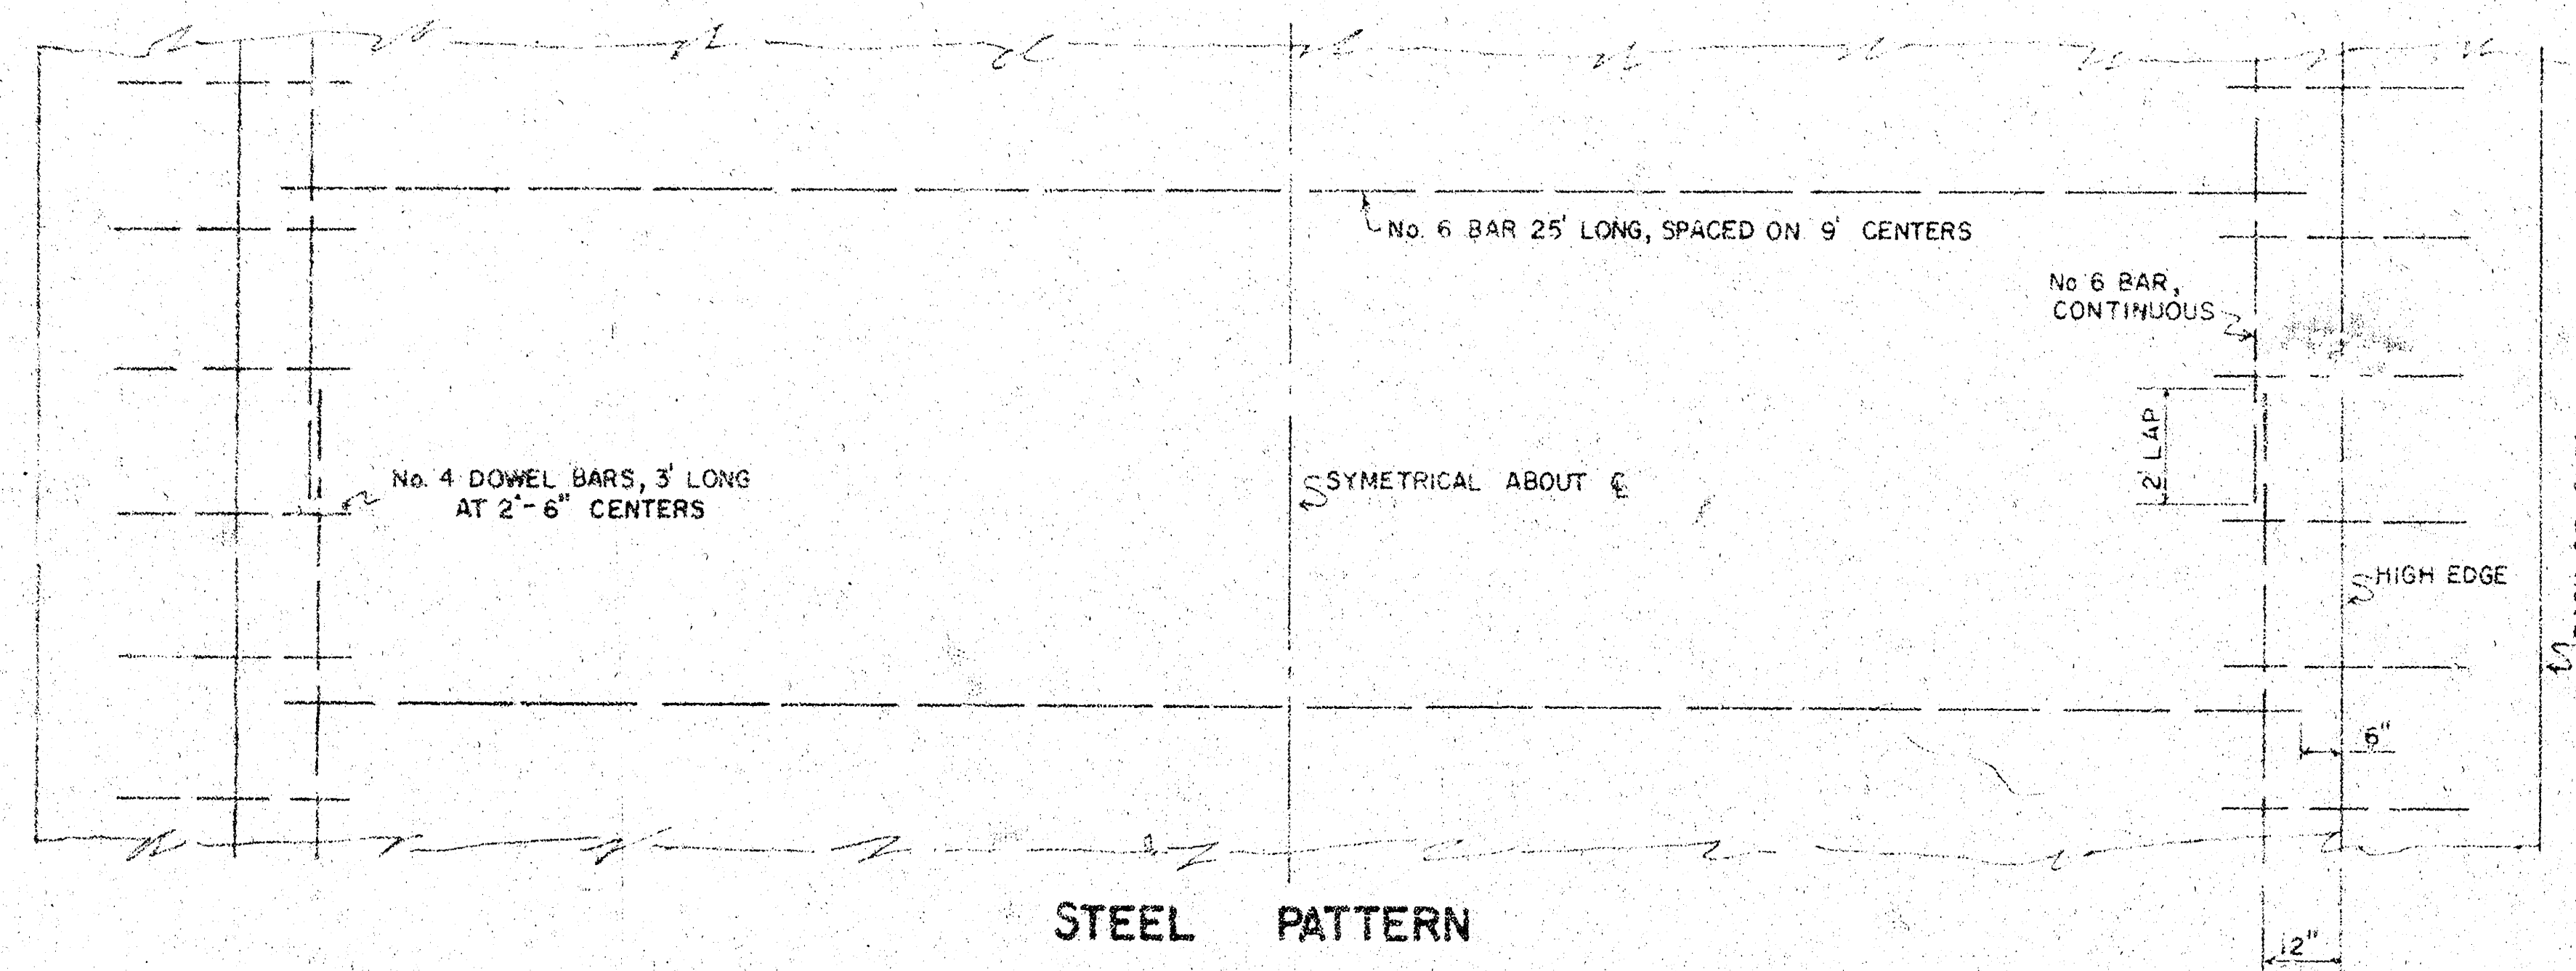


STEEL PATTERN

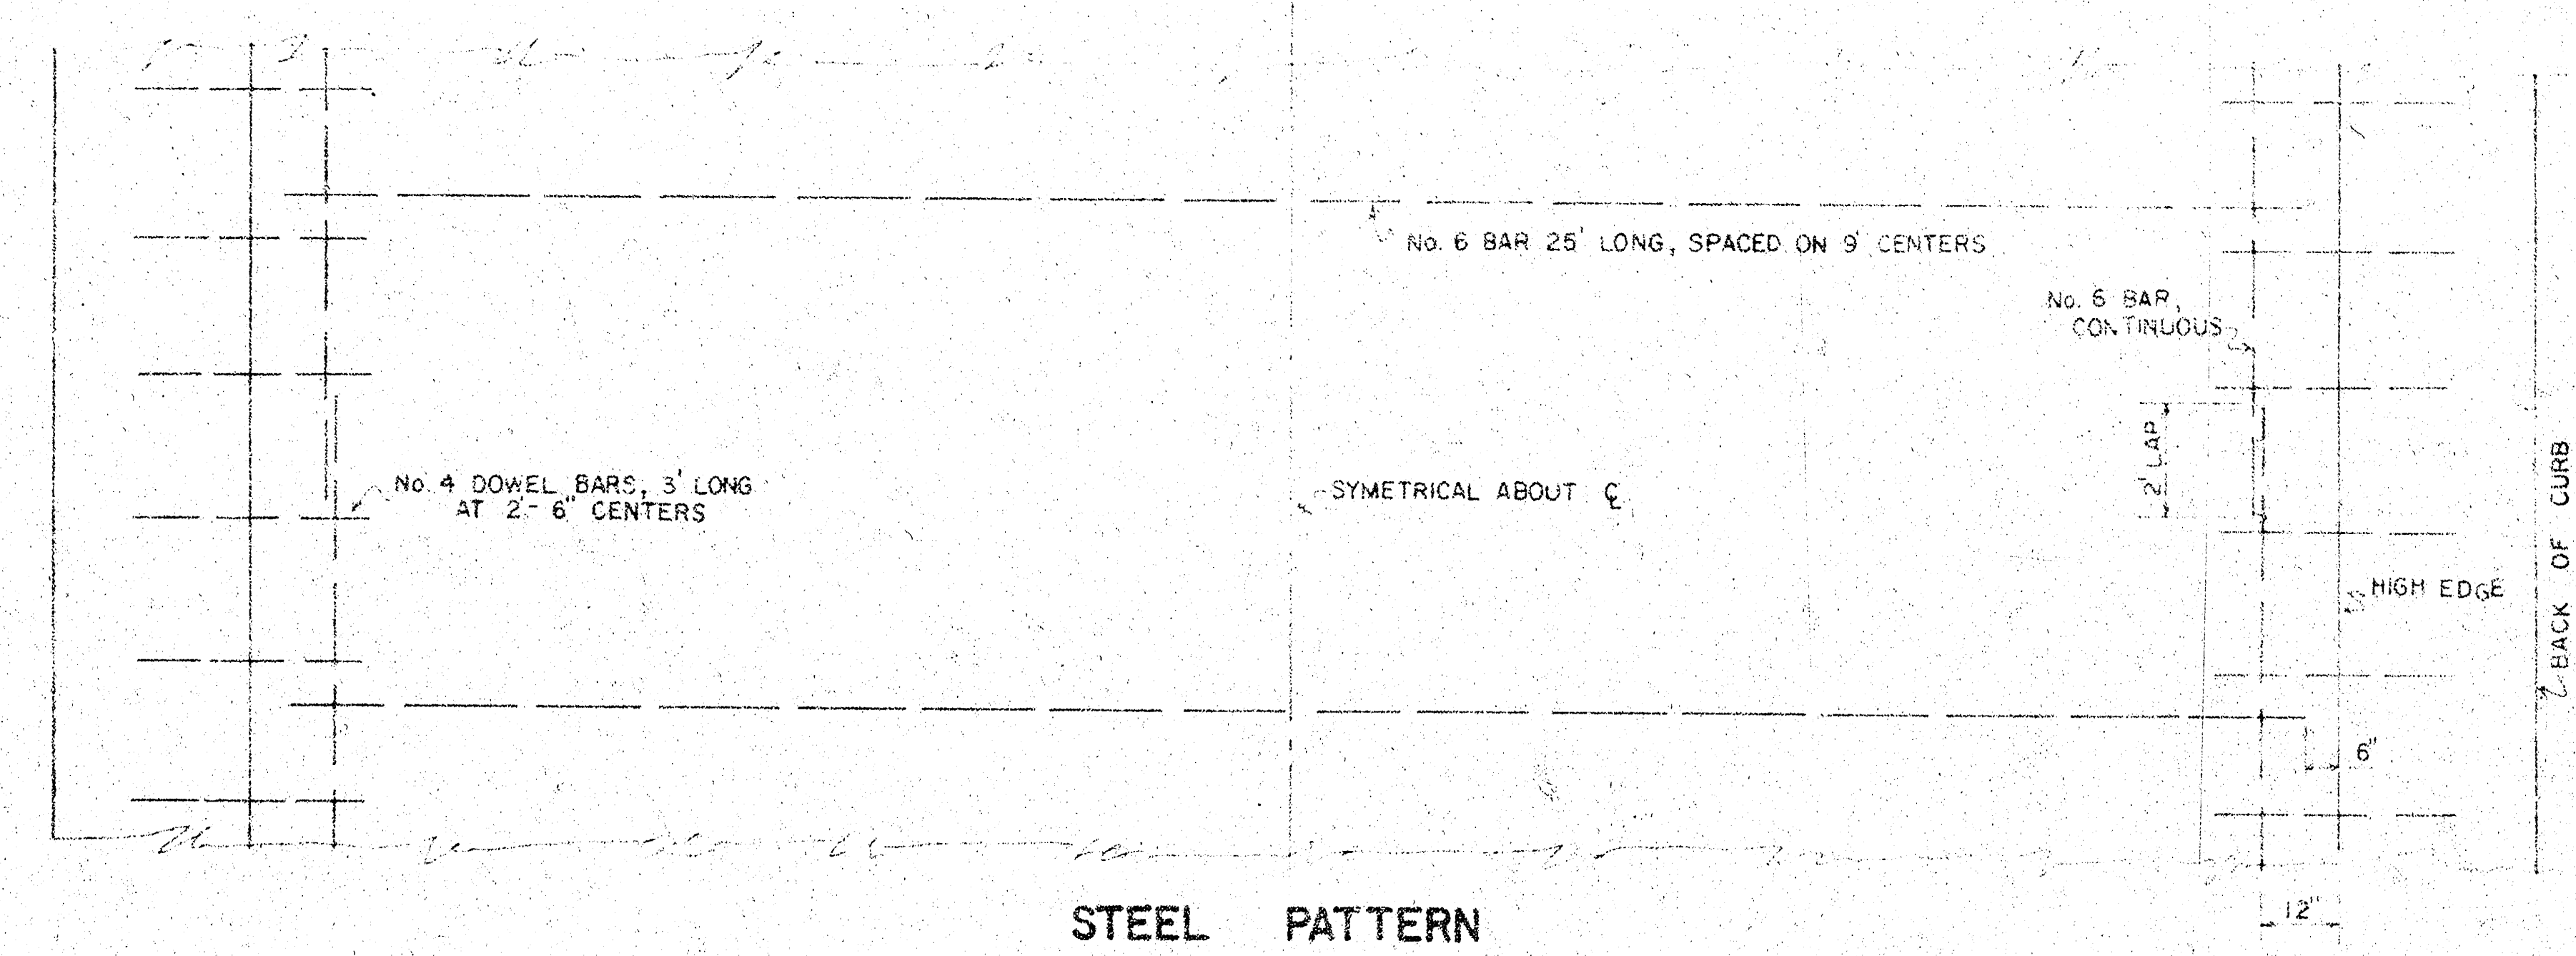

STEEL PATTERN

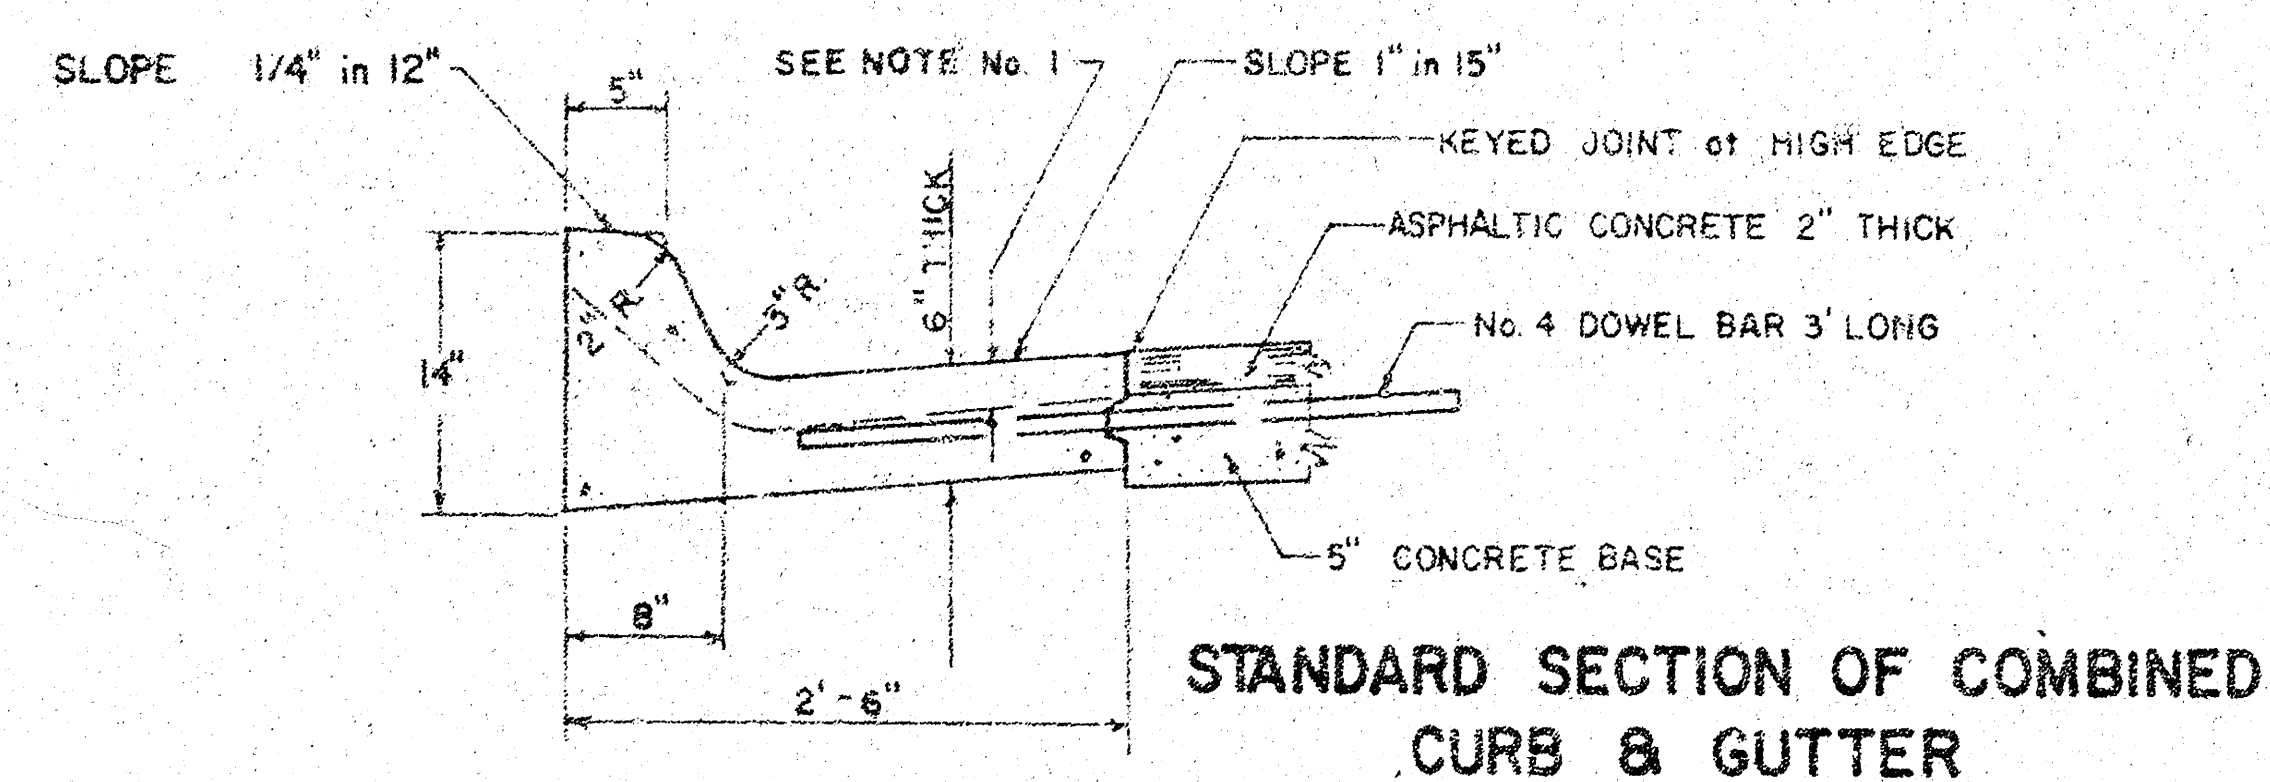


STANDARD SECTION OF COMBINED CURB & GUTTER

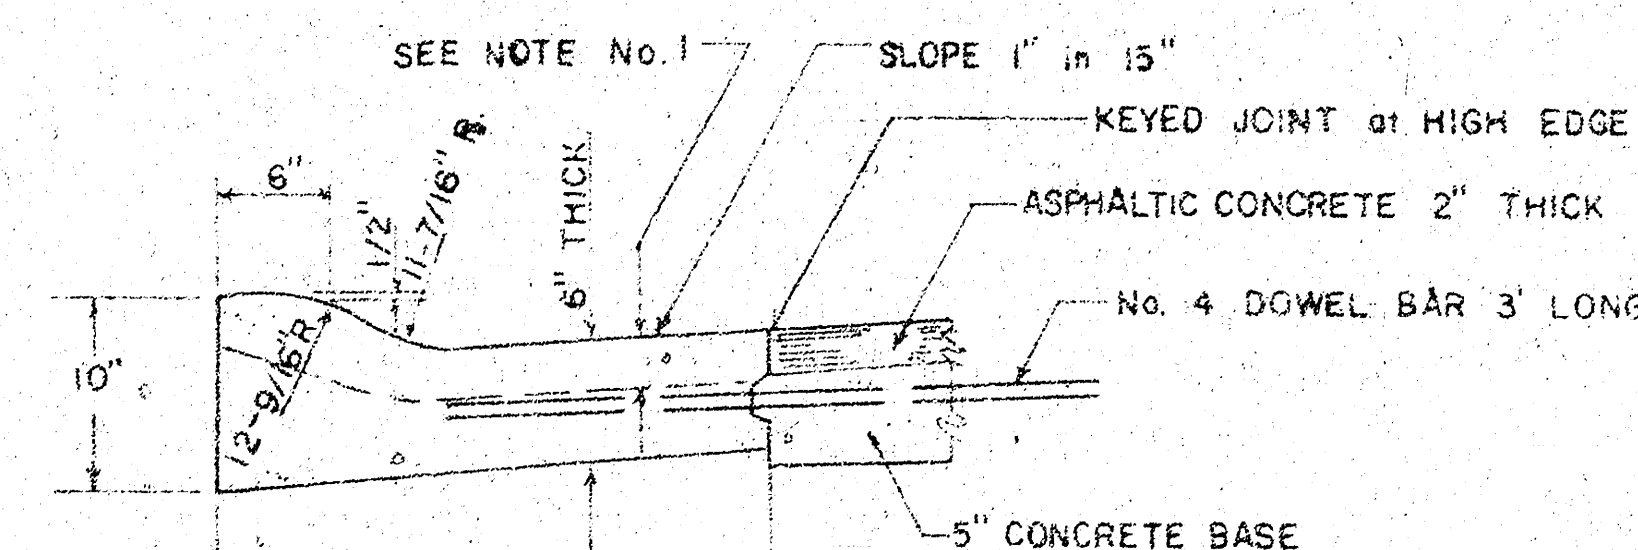

STANDARD SECTION OF ROLL-TYPE CURB & GUTTER

GENERAL NOTES

1. CONTRACTION JOINTS MAY BE CONSTRUCTED IN COMBINED CURB AND GUTTER BY SAWING WITH AN APPROVED CONCRETE SAW. THE SAW CUT SHALL EXTEND 2-1/2" BELOW THE SURFACE OF THE GUTTER AND CURB. SAWED CONTRACTION JOINTS SHALL HAVE A MAXIMUM SPACING OF 10' AND BE FILLED WITH A SPECIFIED JOINT FILLER, SUCH THAT THE JOINT IN THE GUTTER SECTION WILL BE COMPLETELY FILLED.

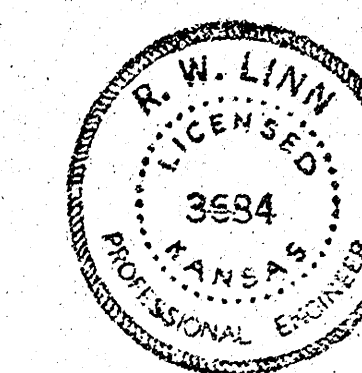


CITY OF WICHITA, KANSAS
 Department of Public Works - Engineering Division
 R. W. Linn, City Engineer
 Date: July, 1976 Project No. DAKS 561-17

FILMED FROM THE BEST AVAILABLE COPY

B-M

B.M. 126.15' 1/4" Cut top E.-Cb. Hyacinth & SL. Cornelson.
 B.M. 128.73' 5/16" Cor. Conc. Patch No. #2602 Cornelson.

Baseline is @ Cornelson.

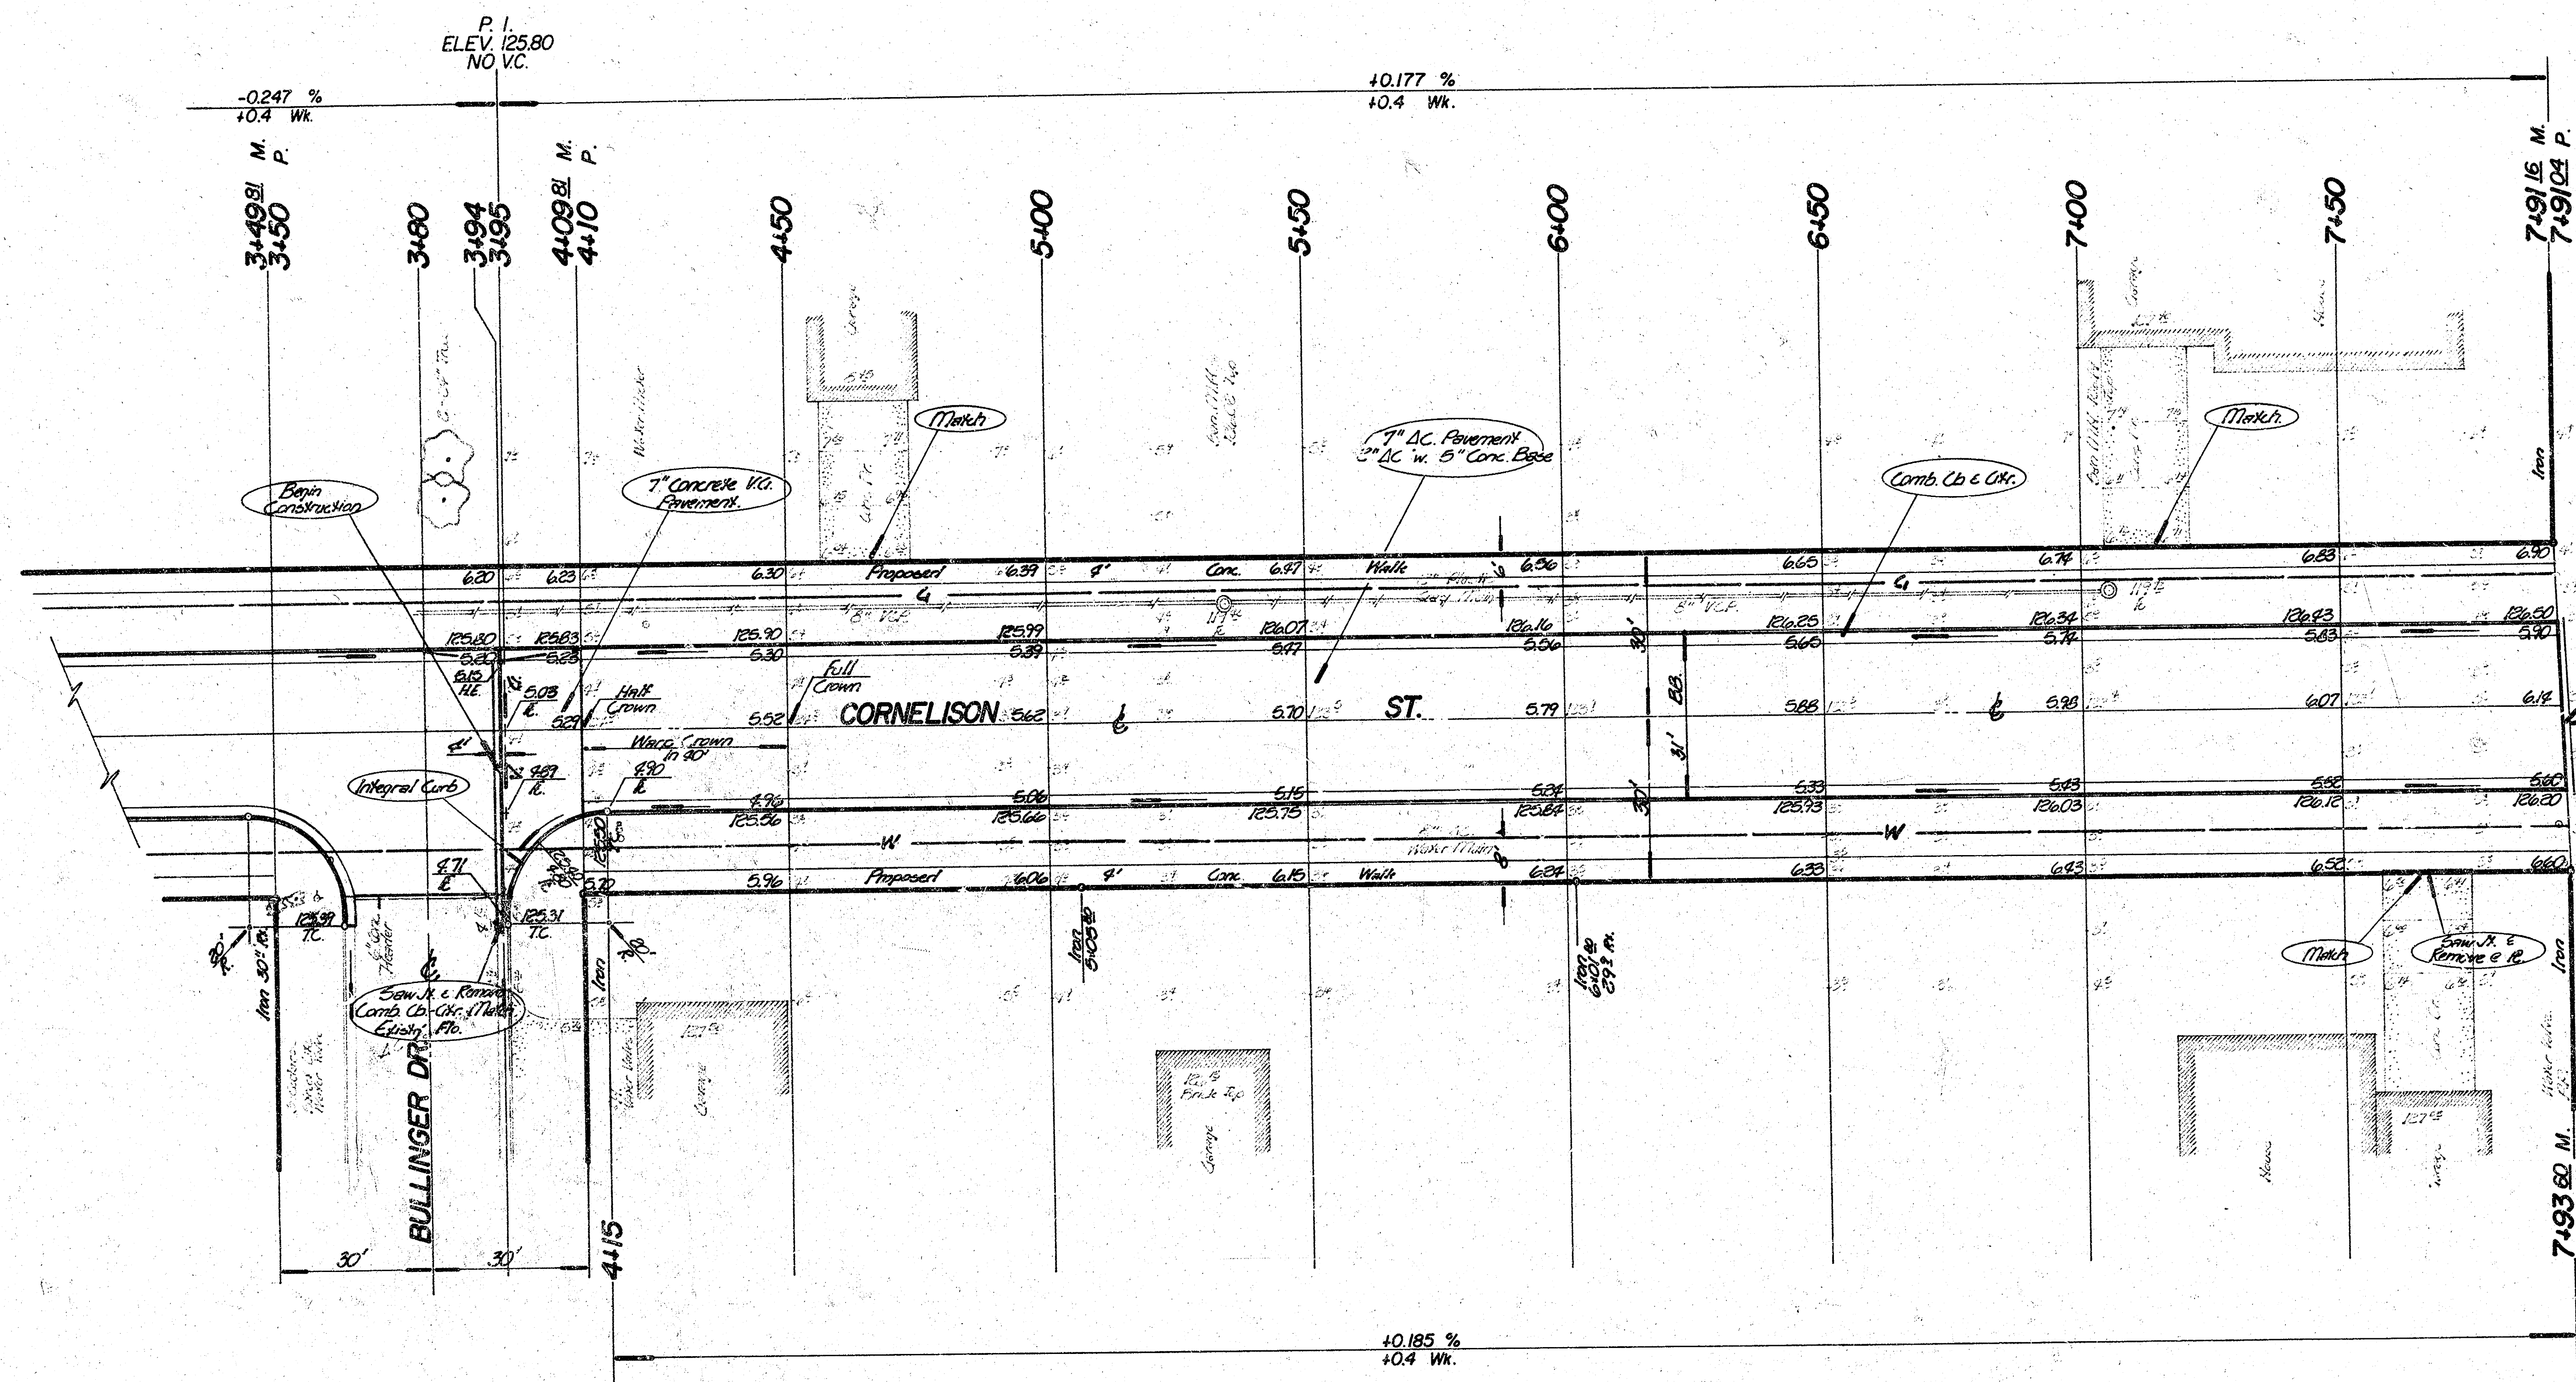

Scale:
1" = 20'

Note to Contractor:

Take ties & replace all "irons" moved or destroyed.
 All excess earthwork on proj. no. DAKS 564016 to be used on proj. no. DAKS 564017.
 Construction to allow for 8'-20' drives.

= indicates Removal.

Note: Change 5' to 6' Cb & Gutter.
 to Roll Cb & Gutter. 8/16/76

Earthwork Quantities

Property		City	
Exc. = 16.9 cy	Comp. Fill = 884.6 cy	Exc. = 6.3 cy	Comp. Fill = 0
+10% = 1.6 cy	+10% = 88.5 cy	+10% = .6 cy	
Total = 18.0 cy	Total = 973.1 cy	Total = 6.9 cy	
Manipulation = 1931 cy.		Manipulation = 412 cy.	

SUB-GRADE
 TYPE OF SUB-GRADE TREATMENT SHALL BE DETERMINED BY THE FIELD ENGINEER. SUB-GRADE TREATMENT MAY CONSIST OF LIME TREATMENT, CEMENT TREATMENT, SUB-GRADE MODIFICATION, OR ANY COMBINATION OF THESE.

NOTE TO FIELD ENGINEER & CONTRACTOR
 Grade posting and clear right-of-way for proposed sidewalk. Compact fill in sidewalk area to be constructed by "OTHERS".

CORNELISON ST.

E.L. Lot 3, Blk. 1, River Park Addition to E.L. Blk. 1, River Park Addition.
 31' BB - 2" Asph. Conc. Surf. w/ 5" Conc. Base - Combined Curb & Gutter.

CITY OF WICHITA, KANSAS

R. W. Linn City Engineer
 Project No. DAKS 564017
 Date: July, 1976

FILMED FROM THE BEST AVAILABLE COPY.....