ELM ST. EL OLIVER to EL GLENDALE. 26' Conc.
B.M. Elev. 174.25 S.W. Cor. Copina Culvert on Central East of Blakley Drive

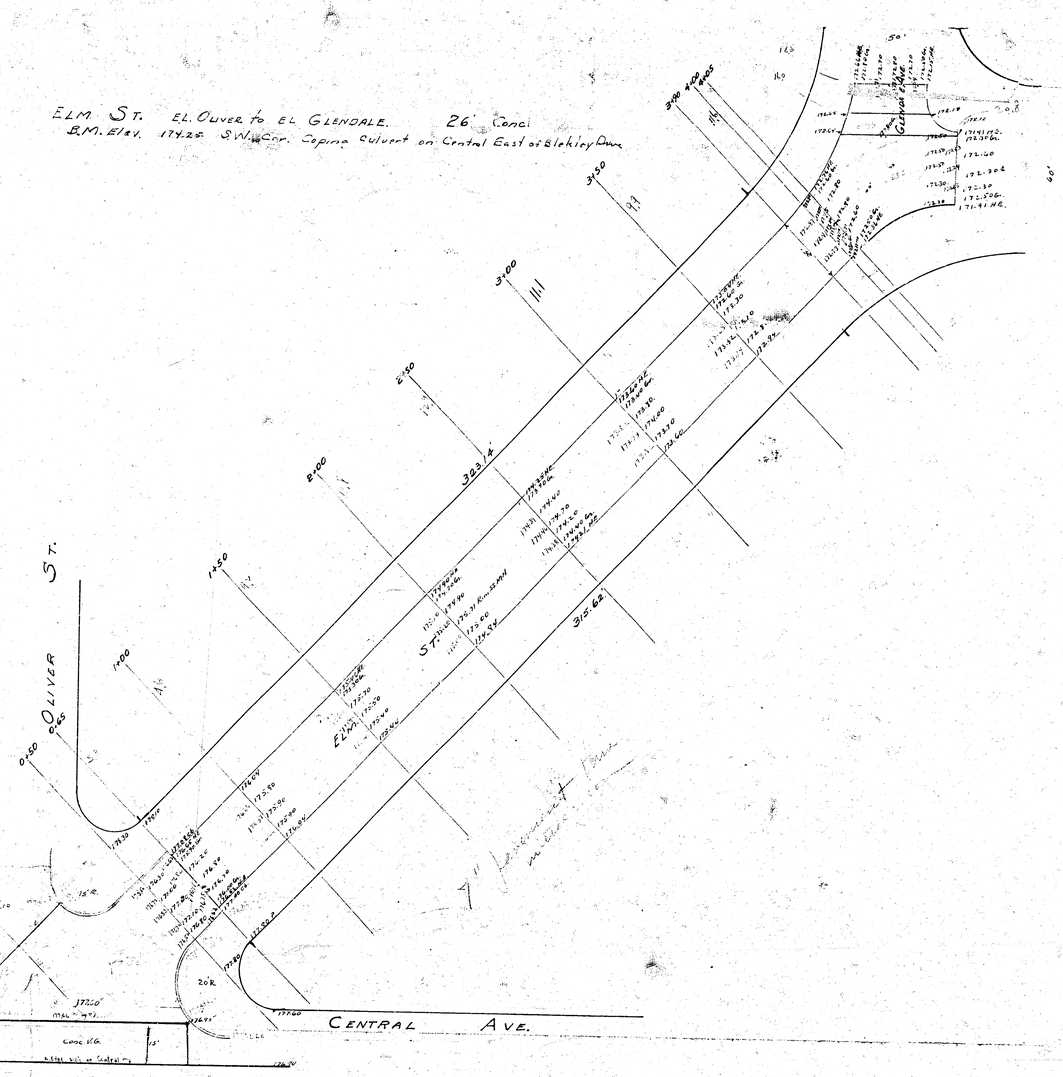

For final estimate get more complete cross sections for the intersection of Elm & Central