1941

ELM - GLENDALE to PAV BET. GLENDALE & HARDING

20' CONC.

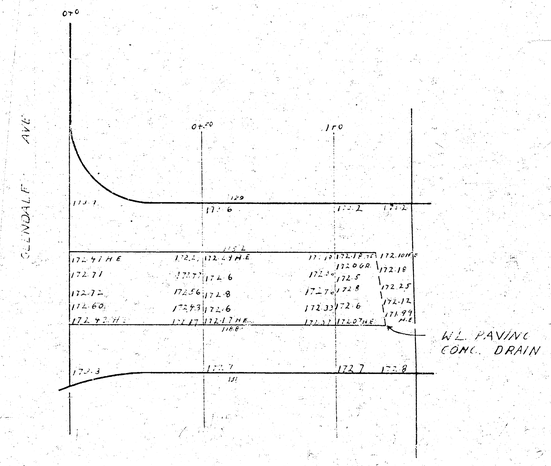

BM 174.04 W'-IN WPA N CB ELM 5' W OF WL. HARDING

BM 172.49 E'IN ELTING W.S. DRIVE S.CB ELM @ E.S. CONC. DRAIN