


Book 38 y

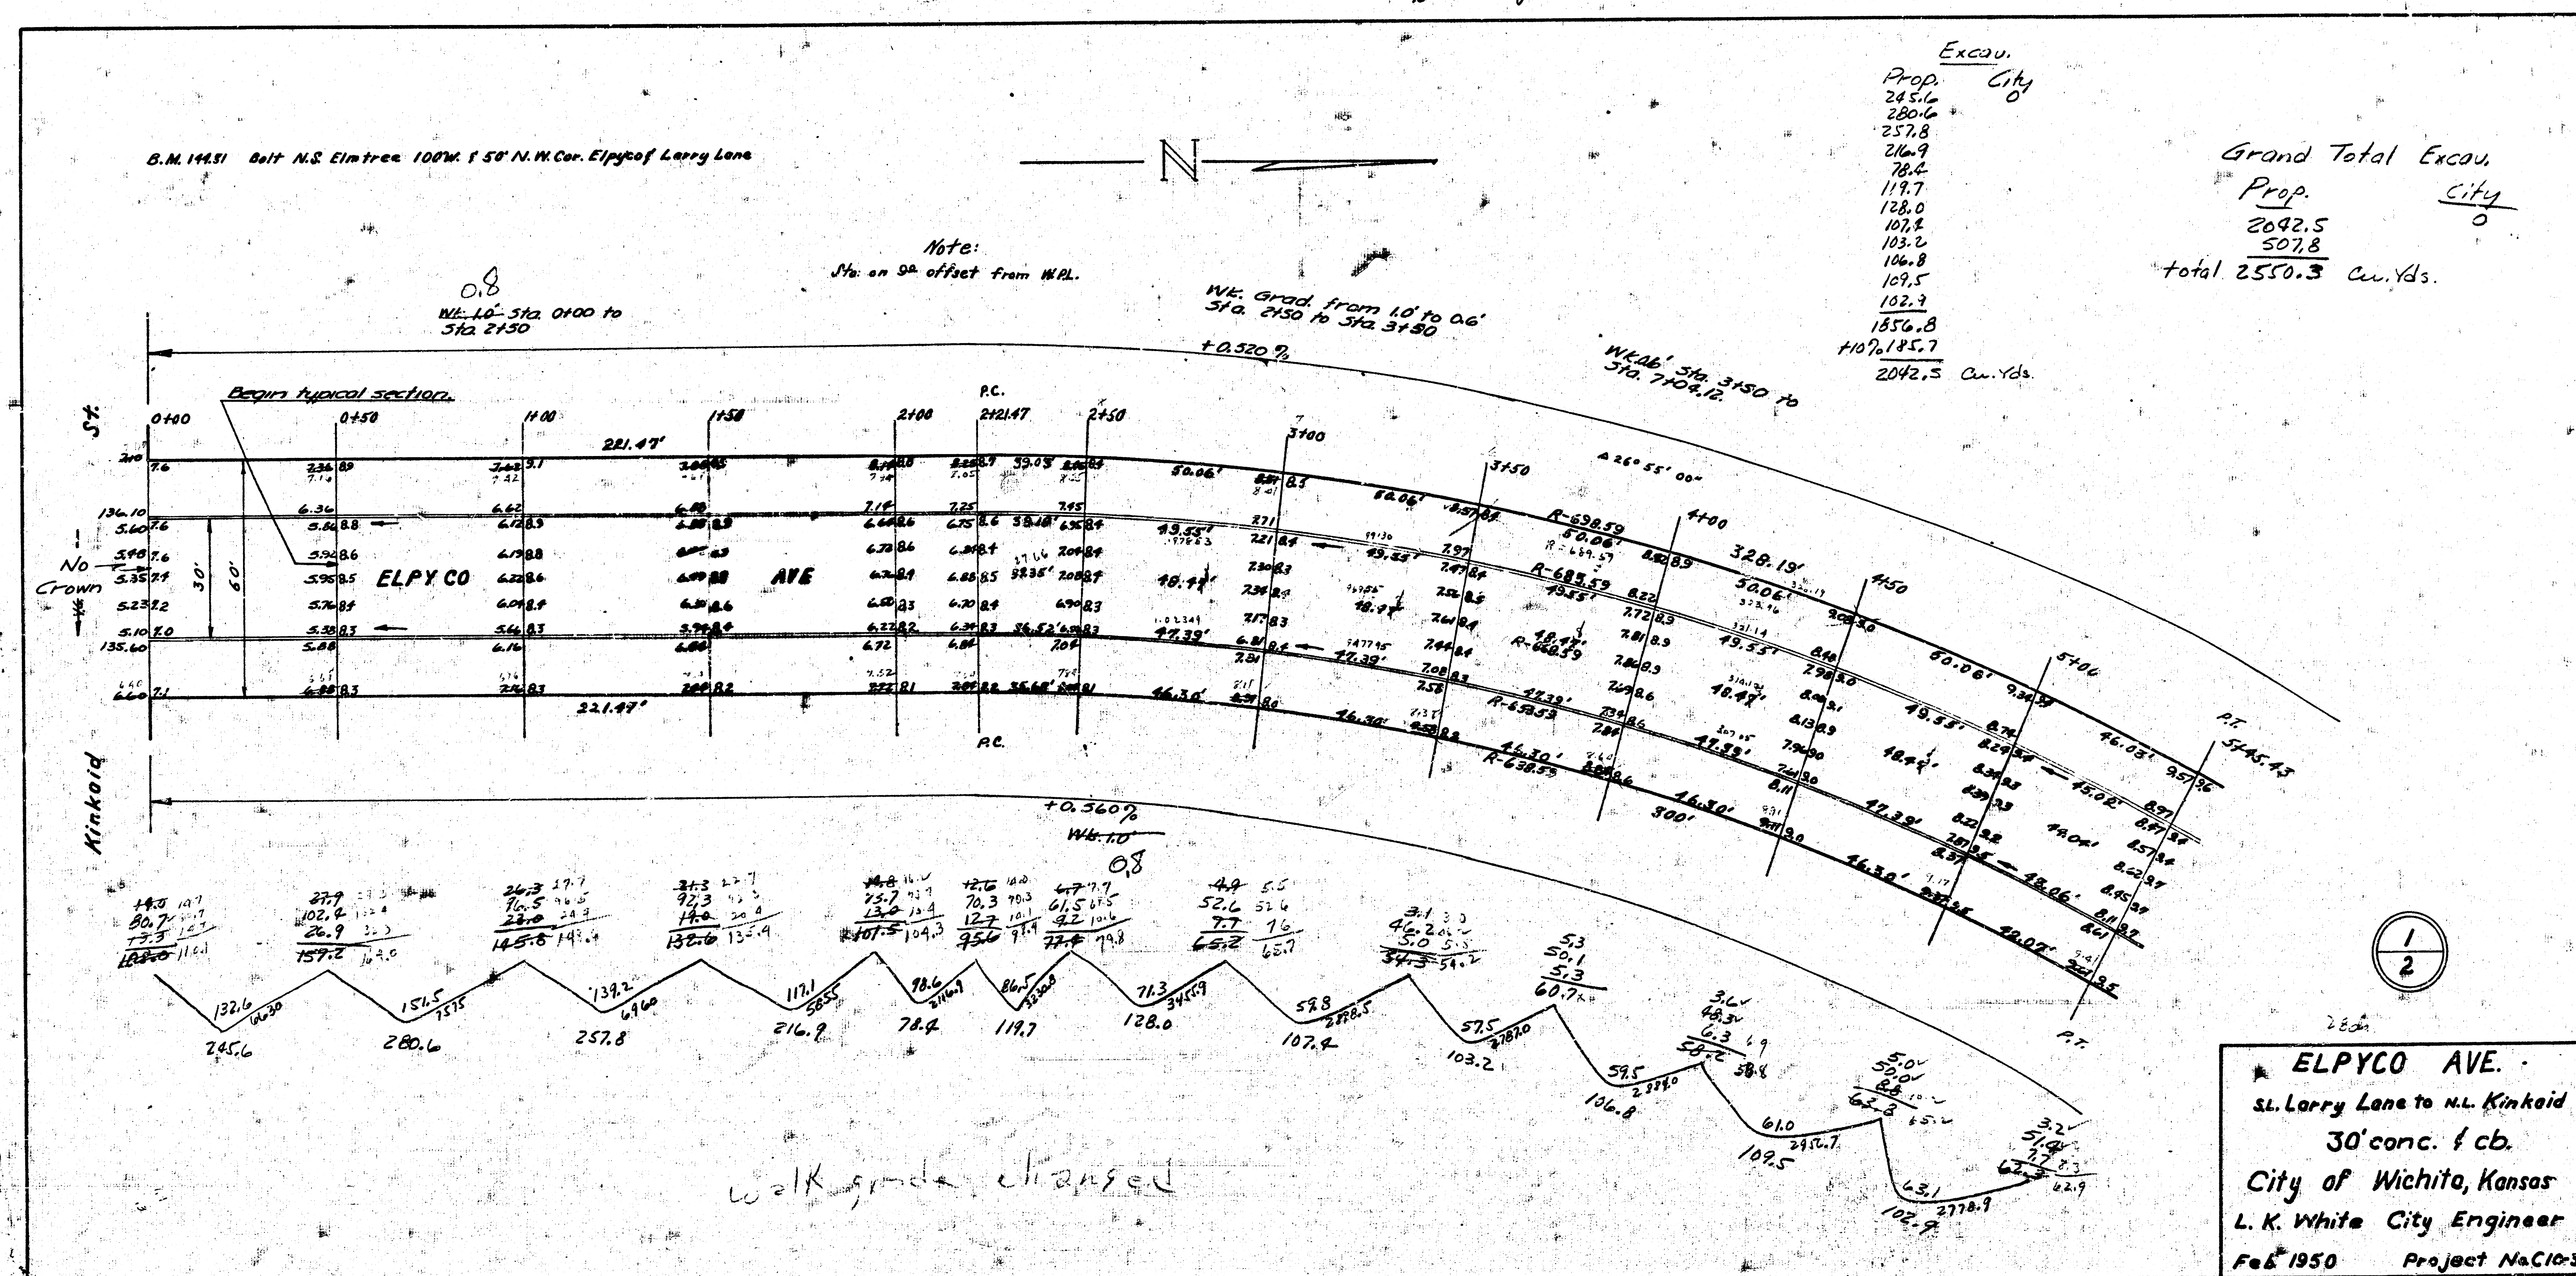


Book 384

Note: Sta on 32' offset from W.P.L.

NOTE: Section of pit from Sta 4100 to P.T. Sta 5145.43, is included on sheet #1.

B.M. 144.31 Bolt N.S. Elm Tree 100' W 150' N N.W. Cor Elpycof Larry Lane

Excau.
Prop. City
193.3
153.7
164.6
141.6
107.8
507.8 Cu Yds.

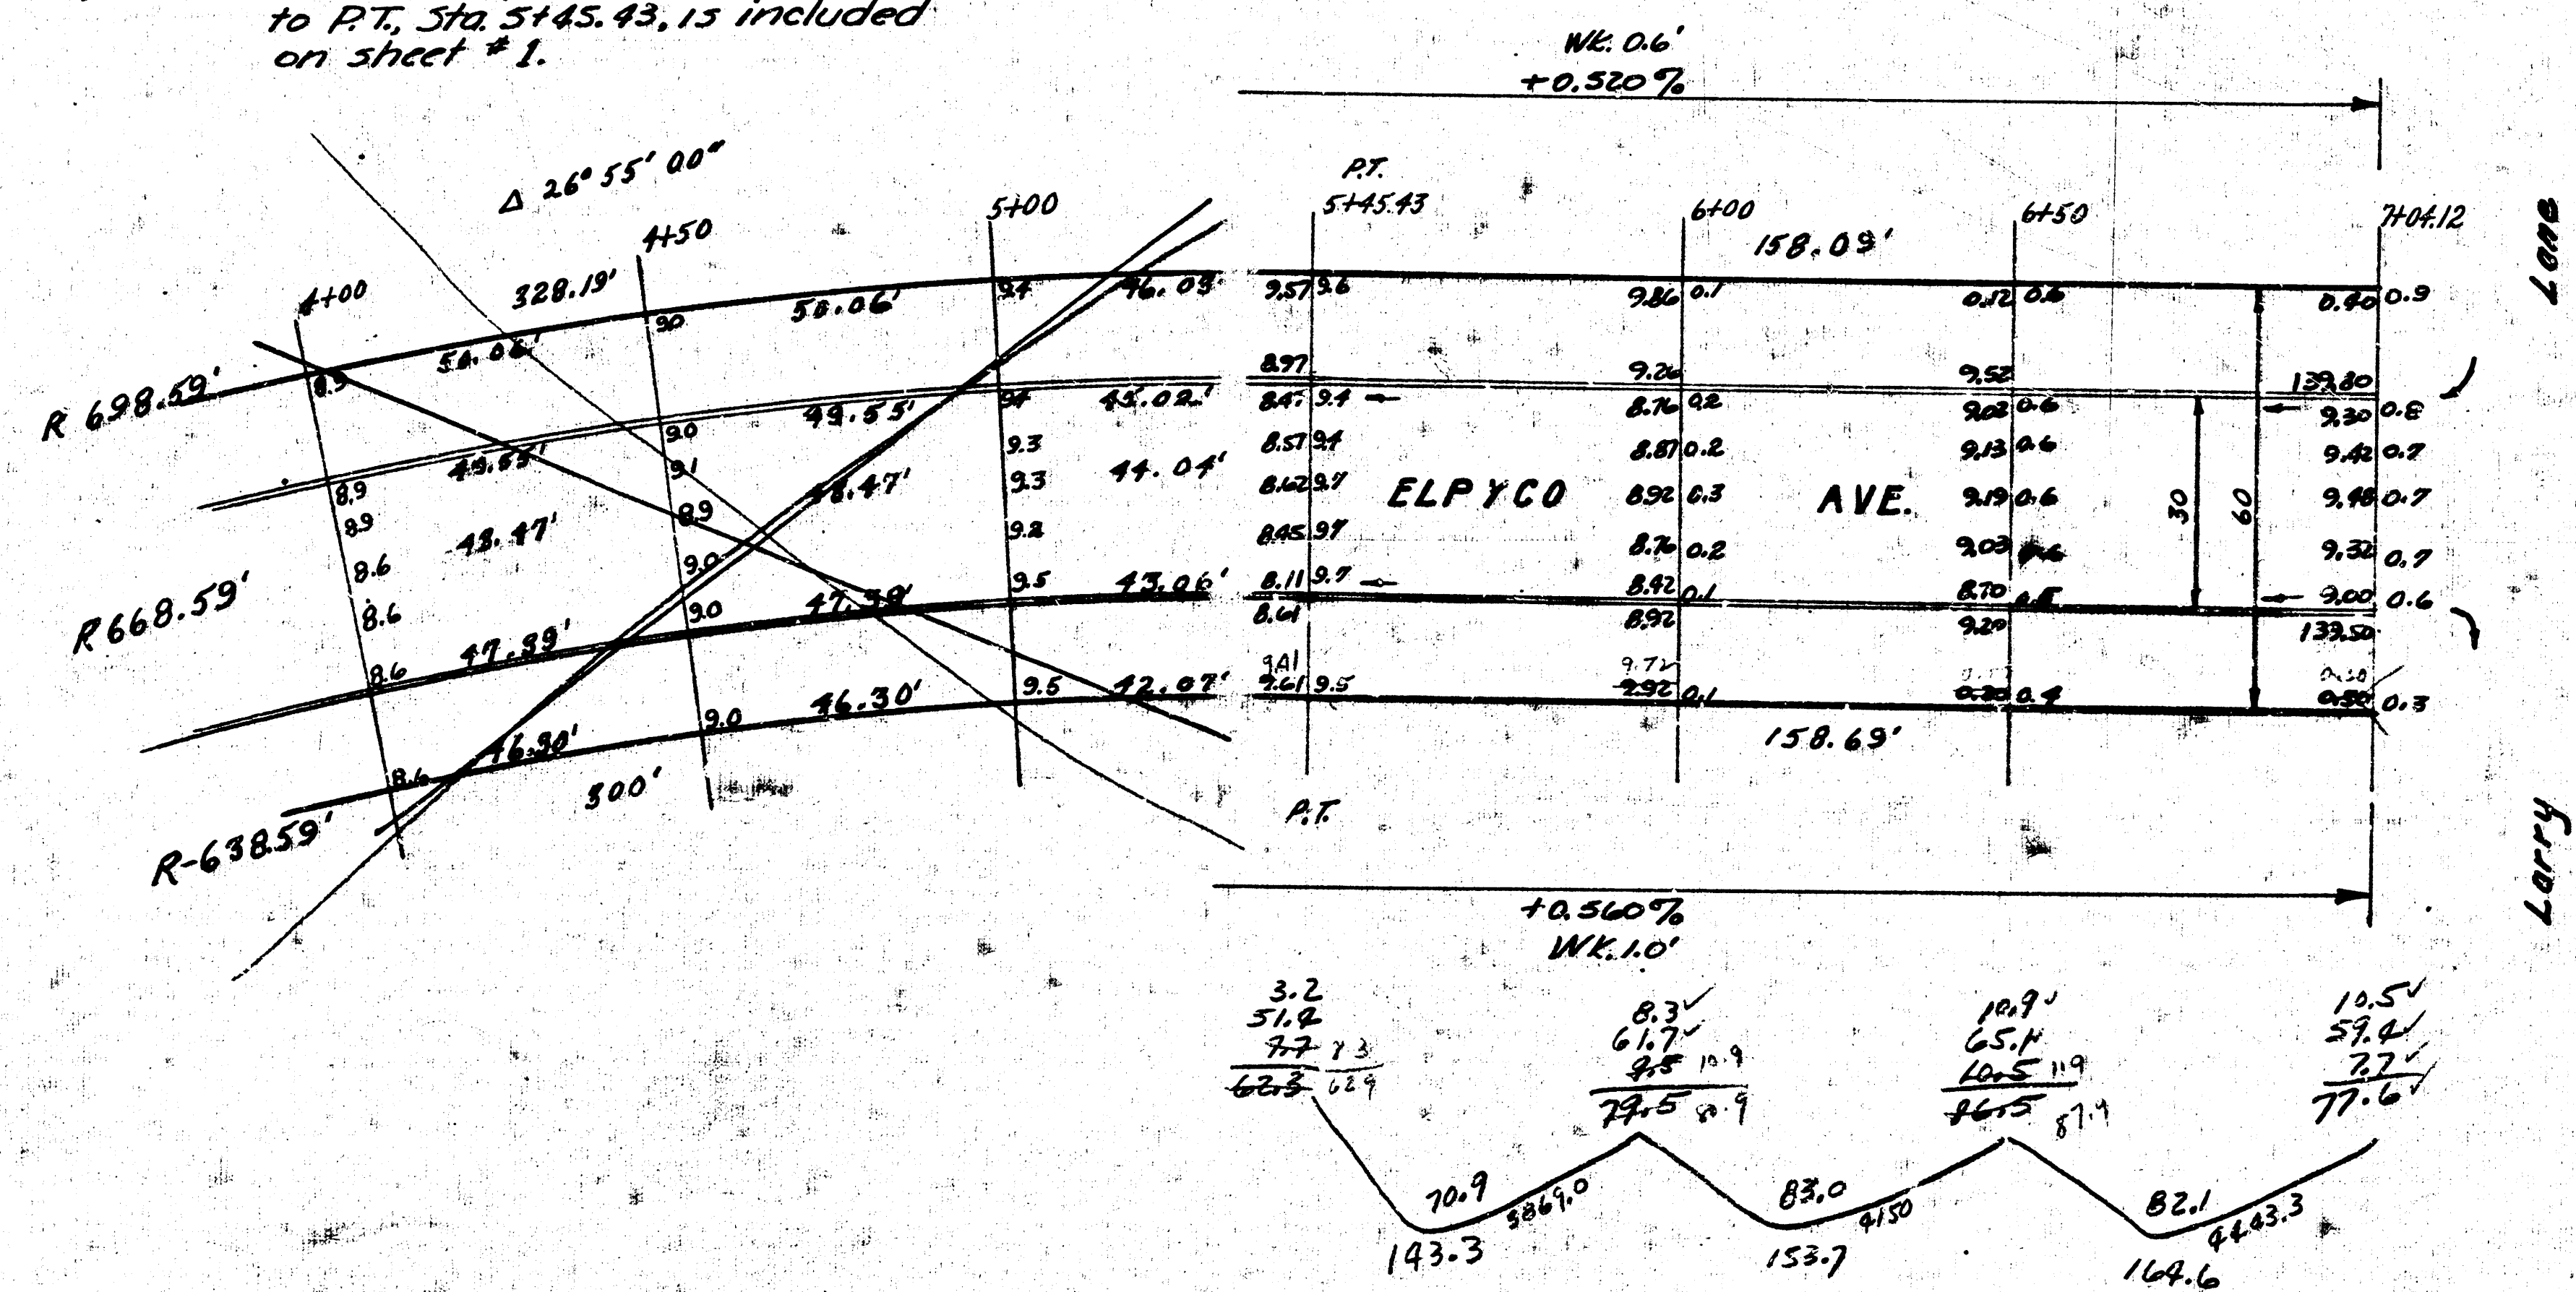

2
2

4 e 5 18