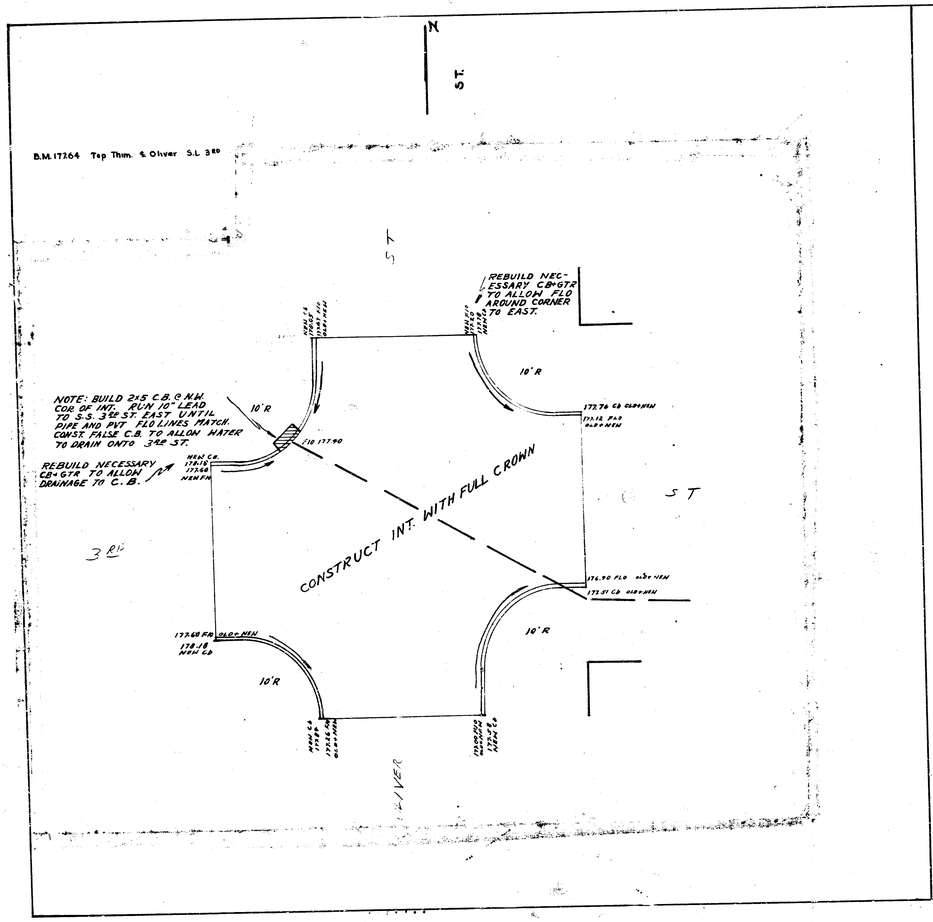


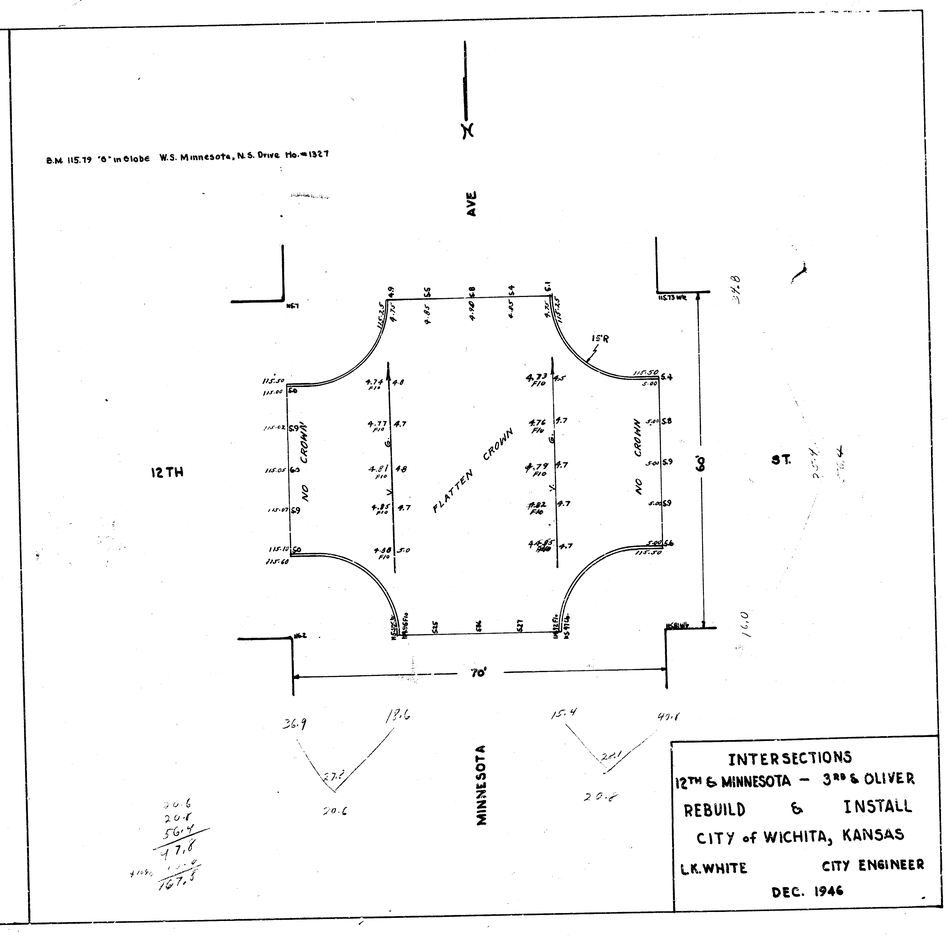


INTERSECTIONS
12TH & MINNESOTA – 3RD & OLIVER
REBUILD & INSTALL
CITY of WICHITA, KANSAS
L.K. WHITE CITY ENGINEER
DEC. 1946

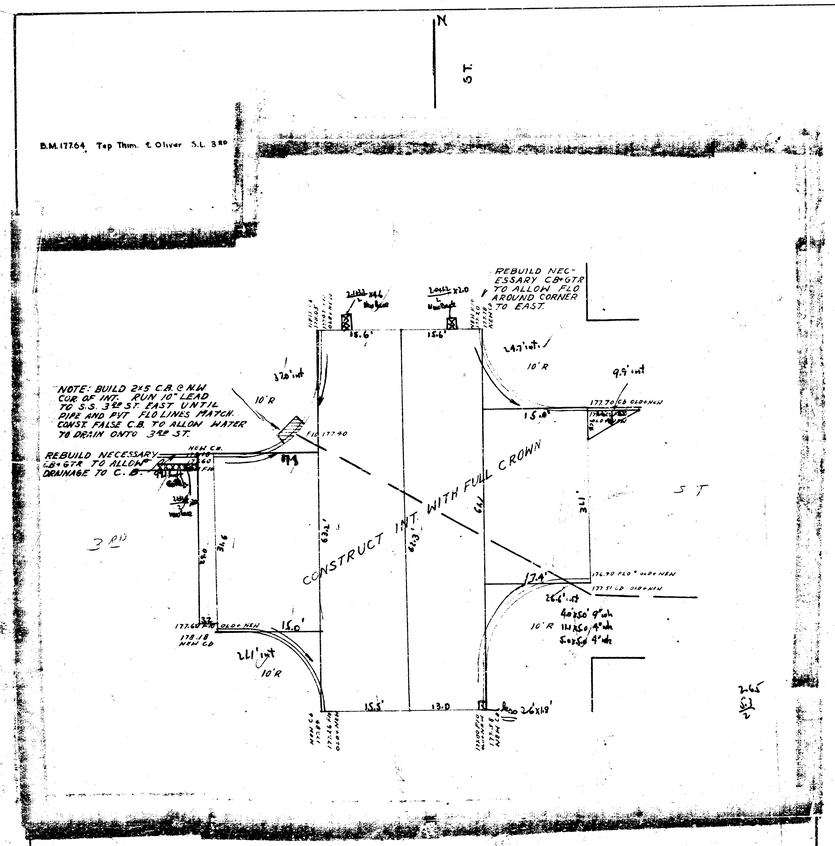


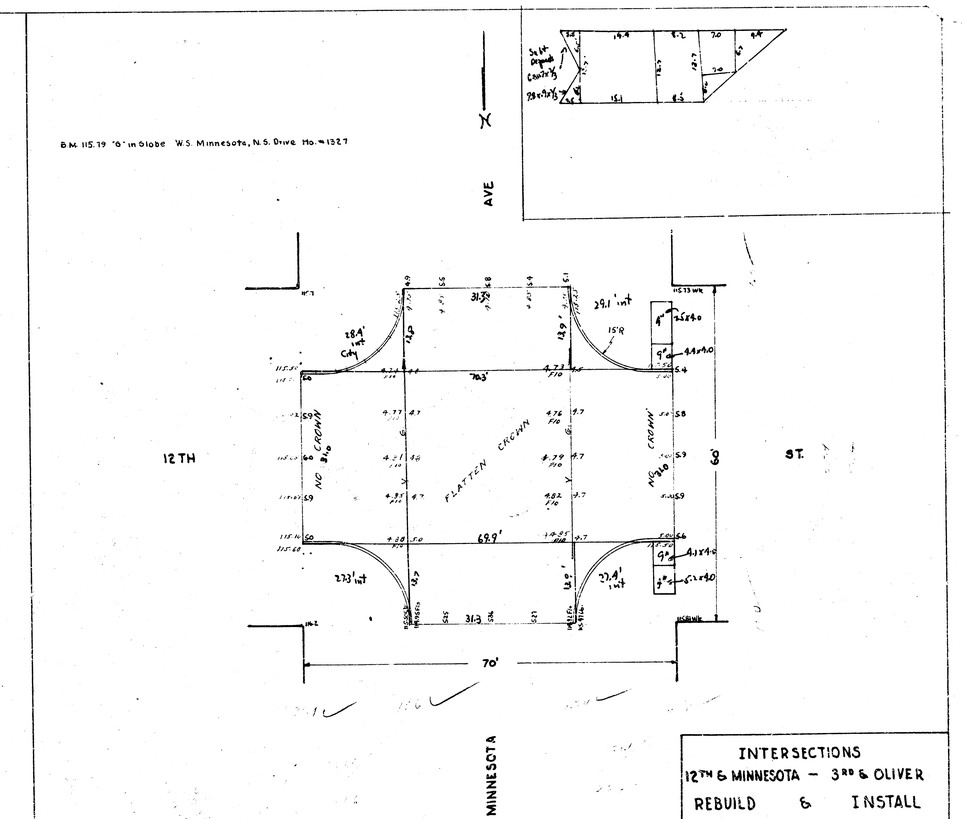


INTERSECTIONS
12TH & MINNESOTA – 3RD & OLIVER
REBUILD & INSTALL
CITY of WICHITA, KANSAS
L.K. WHITE CITY ENGINEER
DEC. 1946