


B.M. 152.825 S.E. Cor. Porch House # 2269 N. Velutina
 B.M. 166.75 S.W. Cor. Porch House # 2368 N. Erie

Chaining No. on E. E.

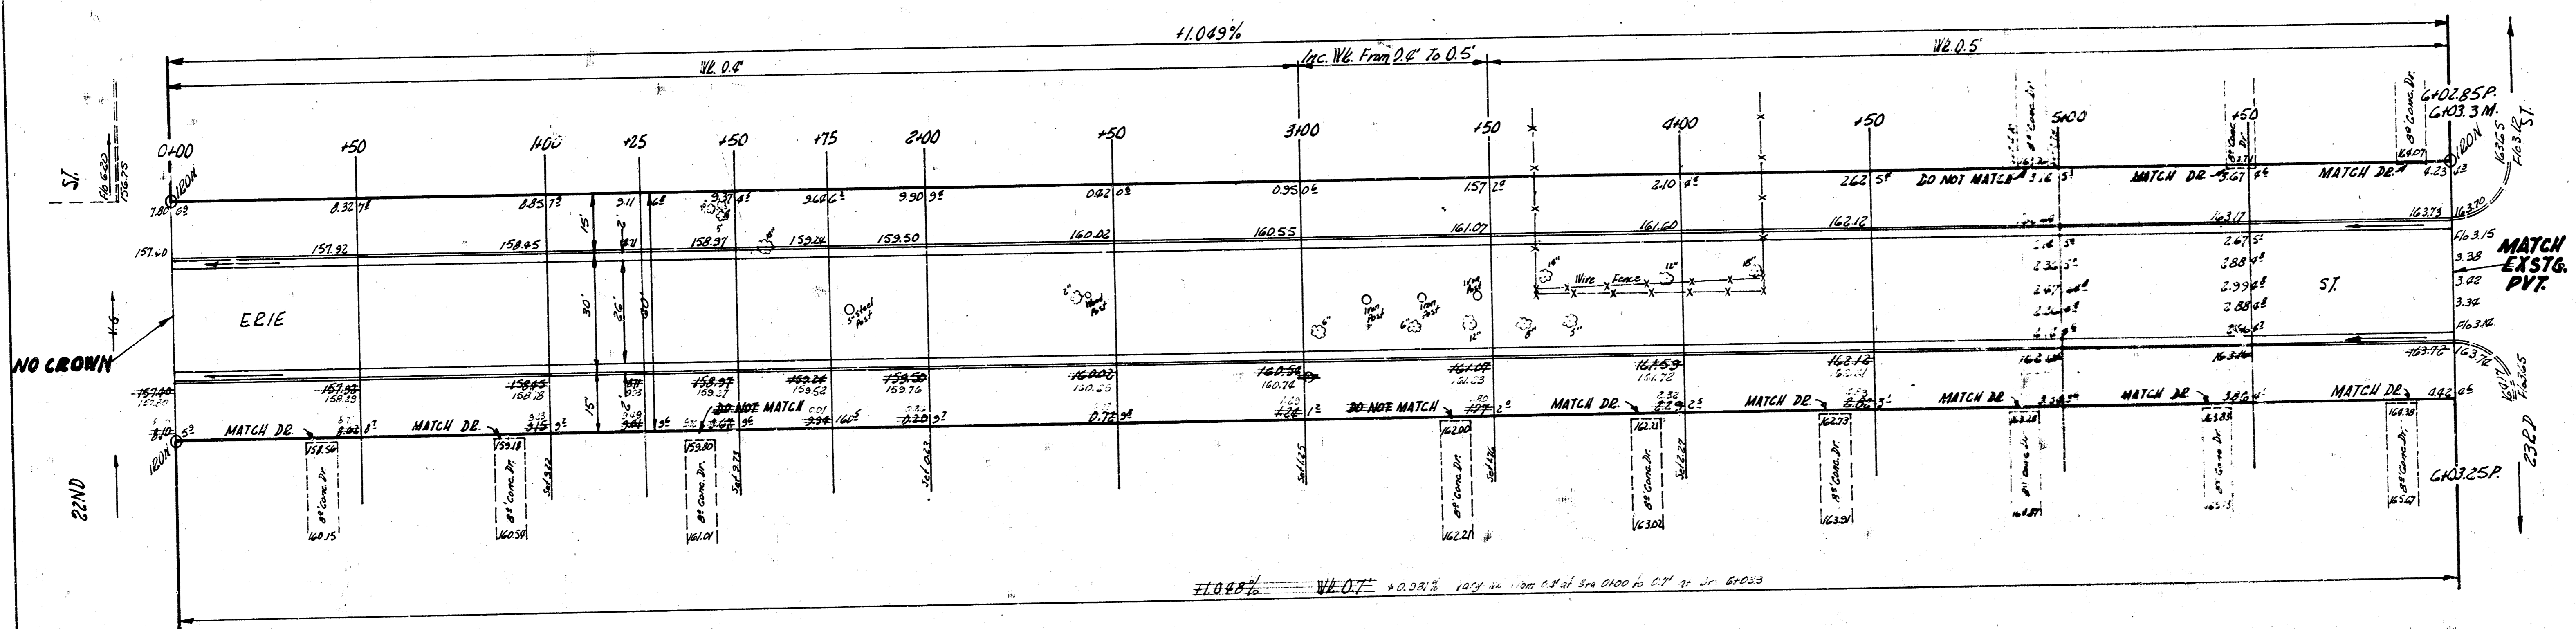

NOTE TO FIELD ENGINEER & CONTRACTOR
 Re-cross section to determine amt. of loose
 fill to be removed & replaced with sand
 in draw at approx. Sta 2+00.

ERIE ST
 NL 22ND - SL 23RD
 26'-2'-30" AC.
 CITY OF WICHITA, KANS
 B.E. SMITH CITY ENGINEER
 FEB. 1955 PROJ. NO. C13-83

