B.M. 158.44 Top Iron N.E. Cor. Ellen & Estelle

NOTE: STATIONING IS ON E.P.L.

N

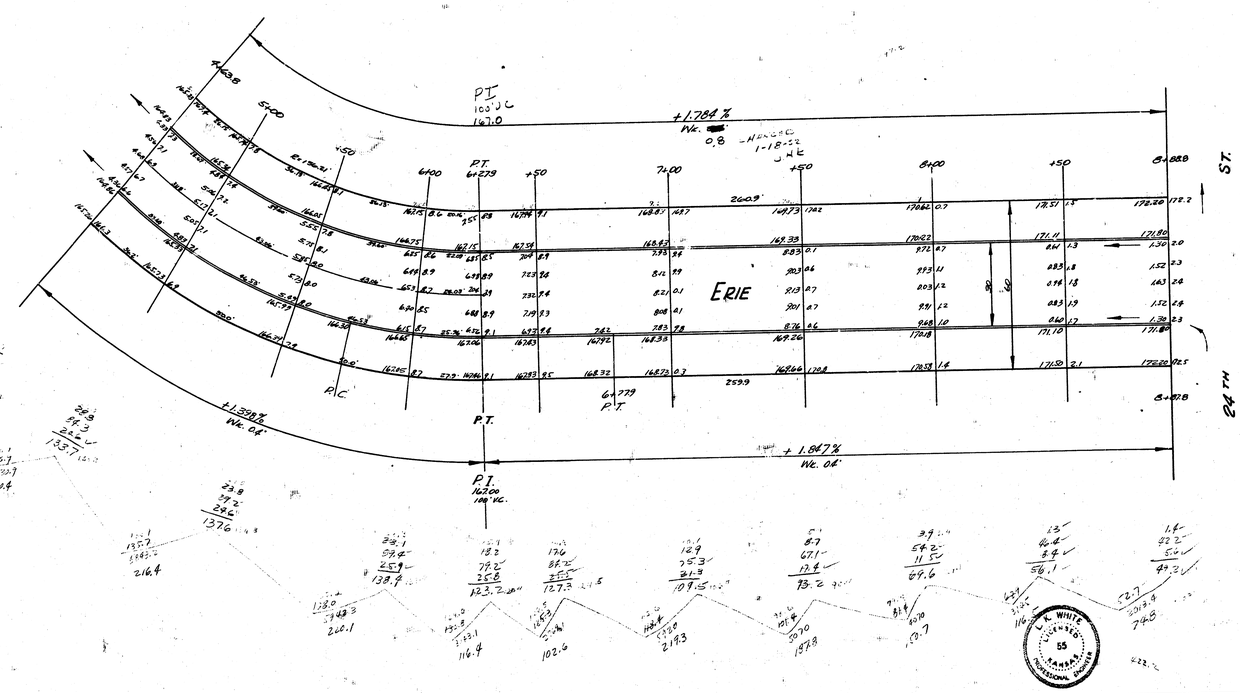

ERIE
E.L. LOT 15, BLK. N, AUDREY MATLOCK HEIGHTS TO S.L. 24TH
30' CONC. & CB.
CITY OF WICHITA, KANSAS
L. K. WHITE CITY ENGINEER
SEPT. 1951 PROJ. C11-93

L. K. WHITE LICENSED 55 KANSAS PROFESSIONAL ENGINEER

(18) 5 14 P