


Survey: Hanson  
 Plan: Schmitt  
 Exc.: db  
 Checked: Brubaker

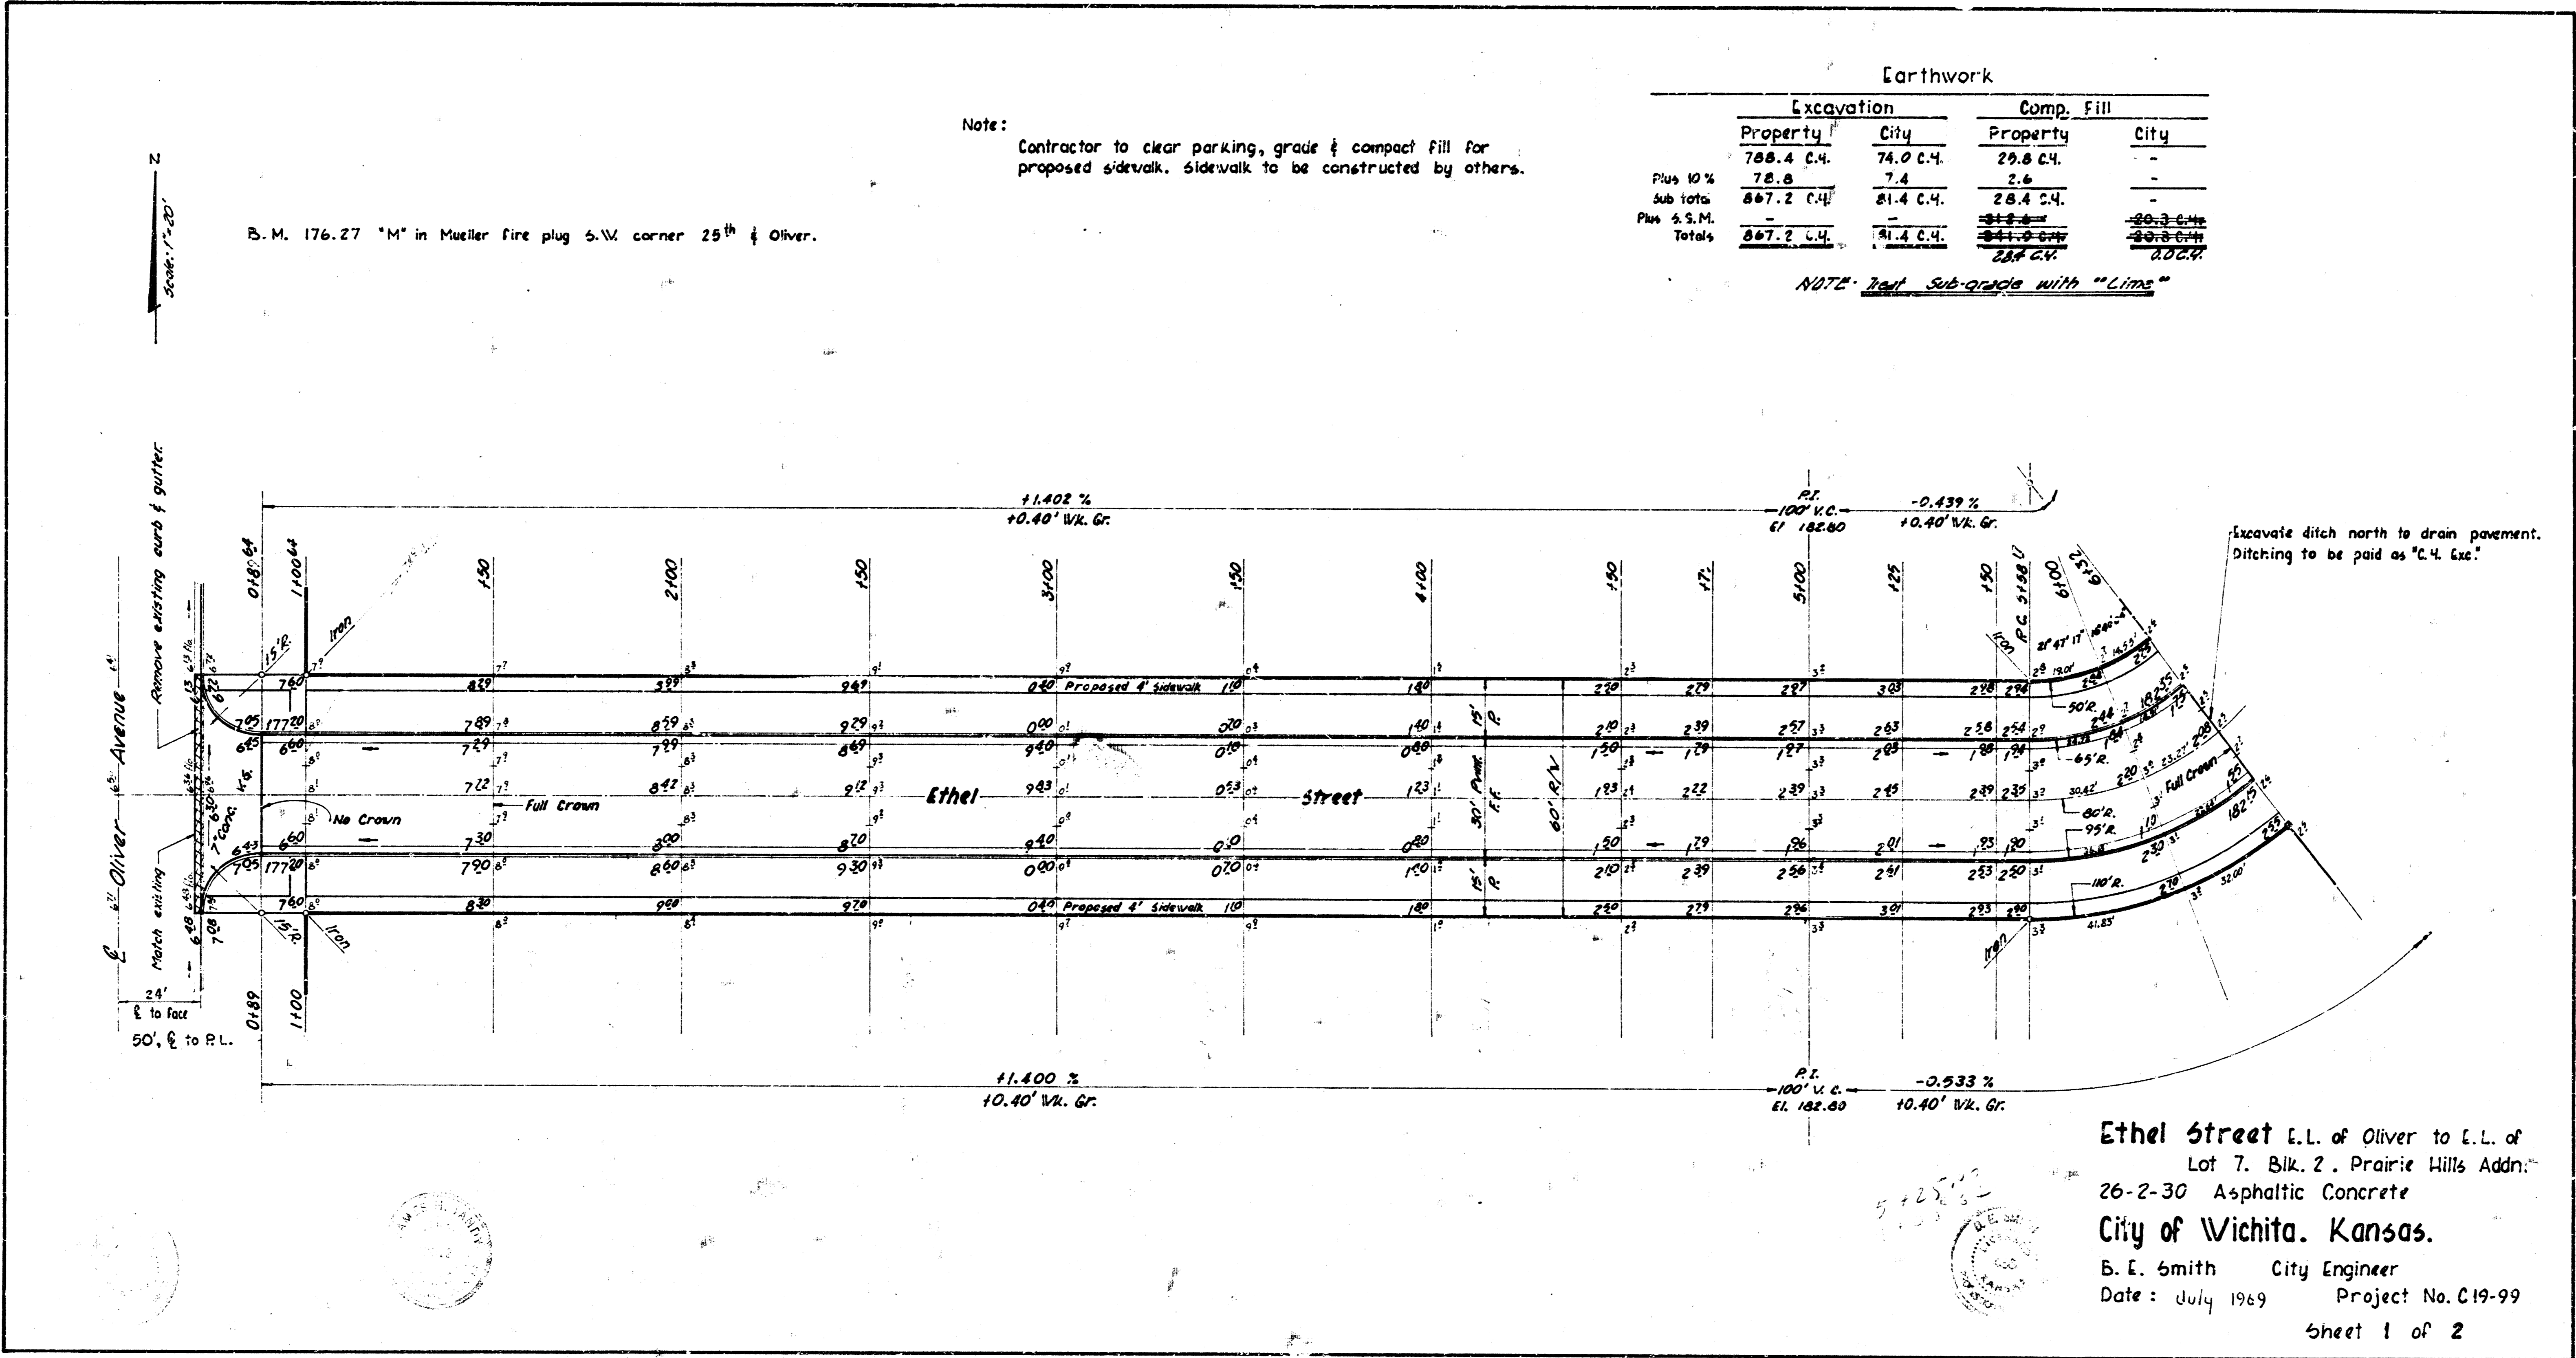

Ethel Street E.L. of Oliver to E.L. of  
 Lot 7, Blk. 2, Prairie Hills Addn.  
 26-2-30 Asphaltic Concrete  
**City of Wichita, Kansas.**  
 B. E. Smith City Engineer  
 Date: July 1969 Project No. C19-99  
 Sheet 1 of 2