
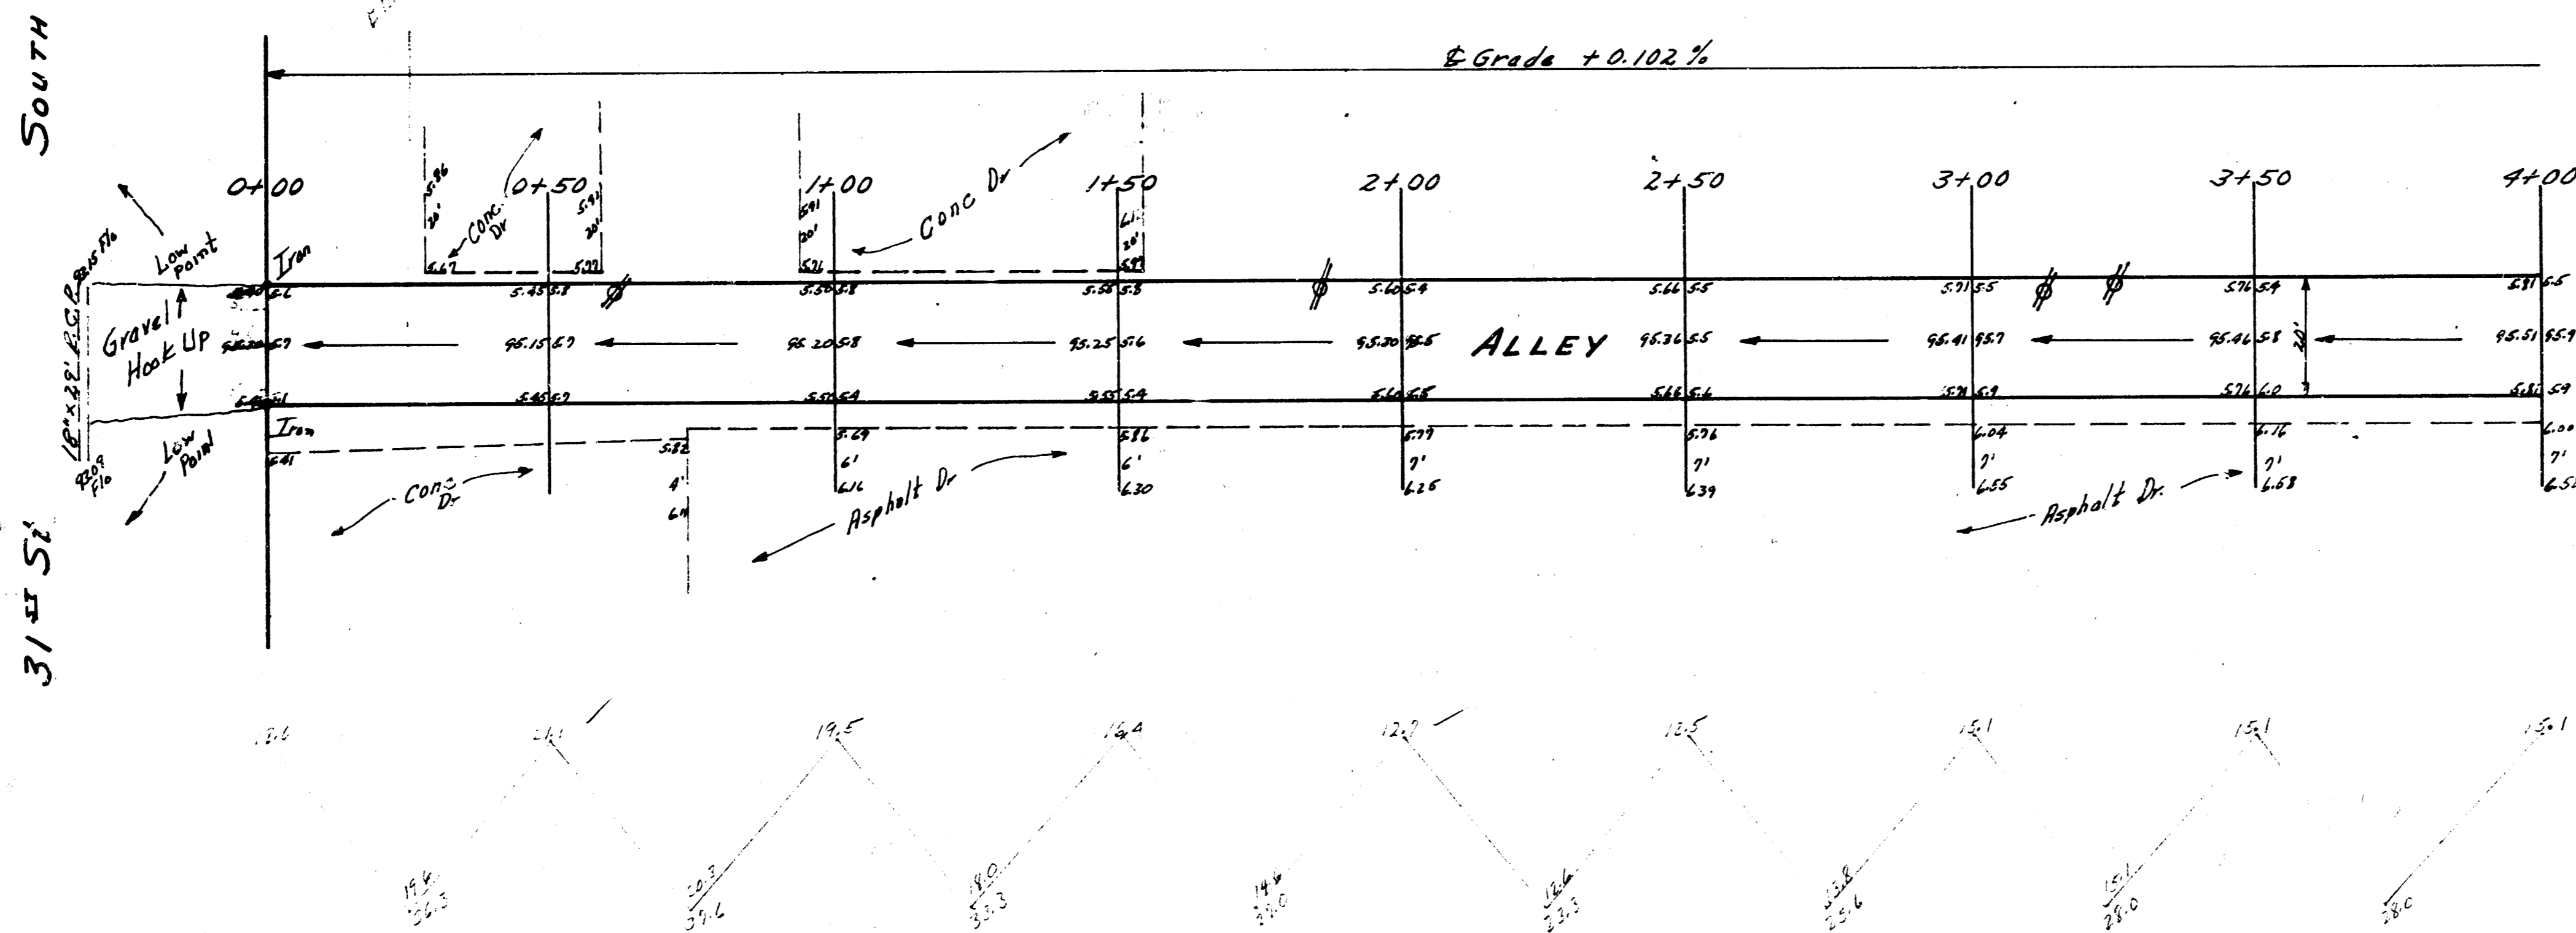
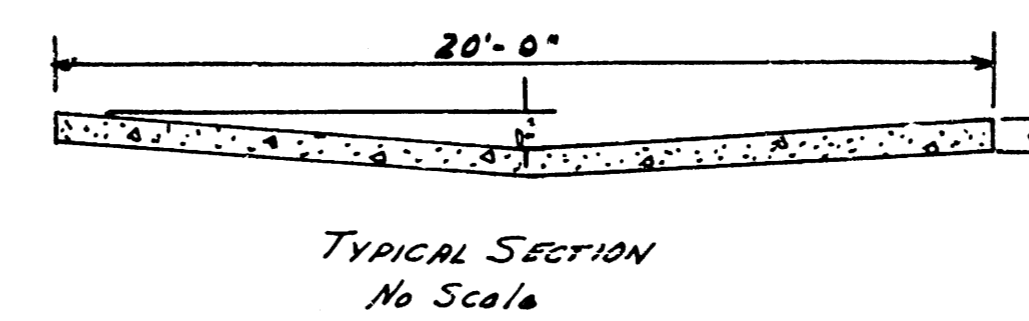


BM 85.76 Standard SE Cor. Seneca f 31<sup>st</sup> St. So.  
 Base Line of Stationing On E. of Alley

Scale 1"=20'

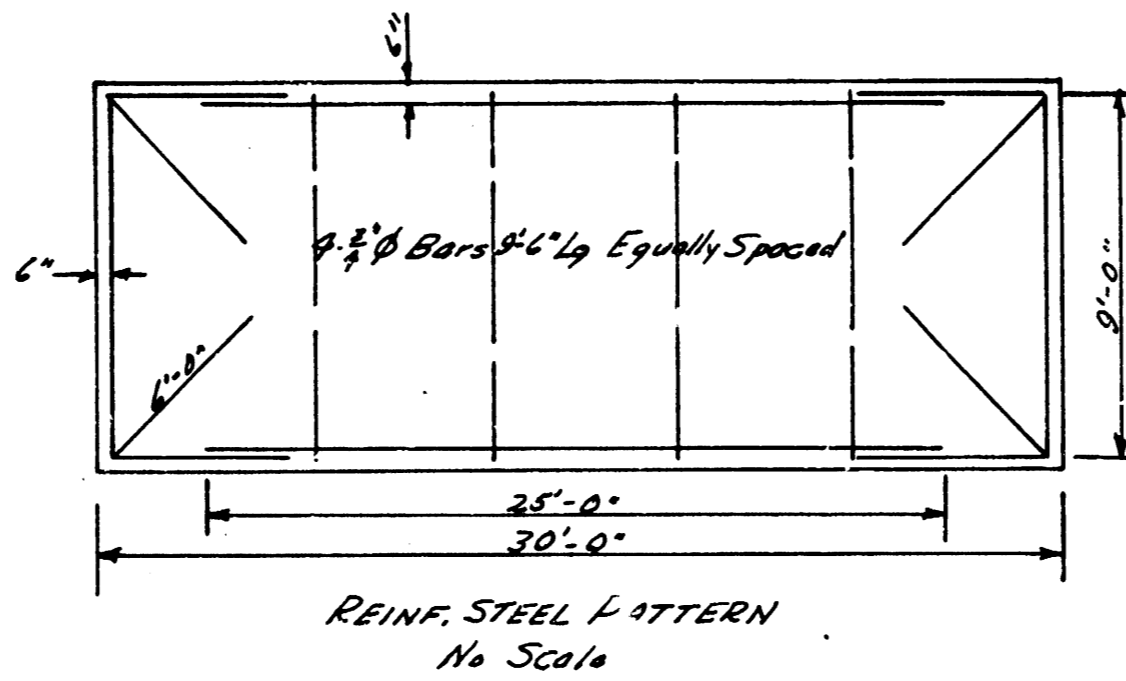


Property  
 199.6  
 + 107.8 = 307.4  
 899.6 Cont'd

371  
 45.7  
 1107.4 = 1143.1  
 50.3 Cont'd



1/3

**ALLEY WEST OF SENECA**  
 N.L. 31<sup>ST</sup> TO W.L. SENECA  
 20' CONC. 7" THICK  
**CITY OF WICHITA KAN**  
**BE SMITH** CITY ENGINEER  
 AUG. 1956 Proj. No. C16-104

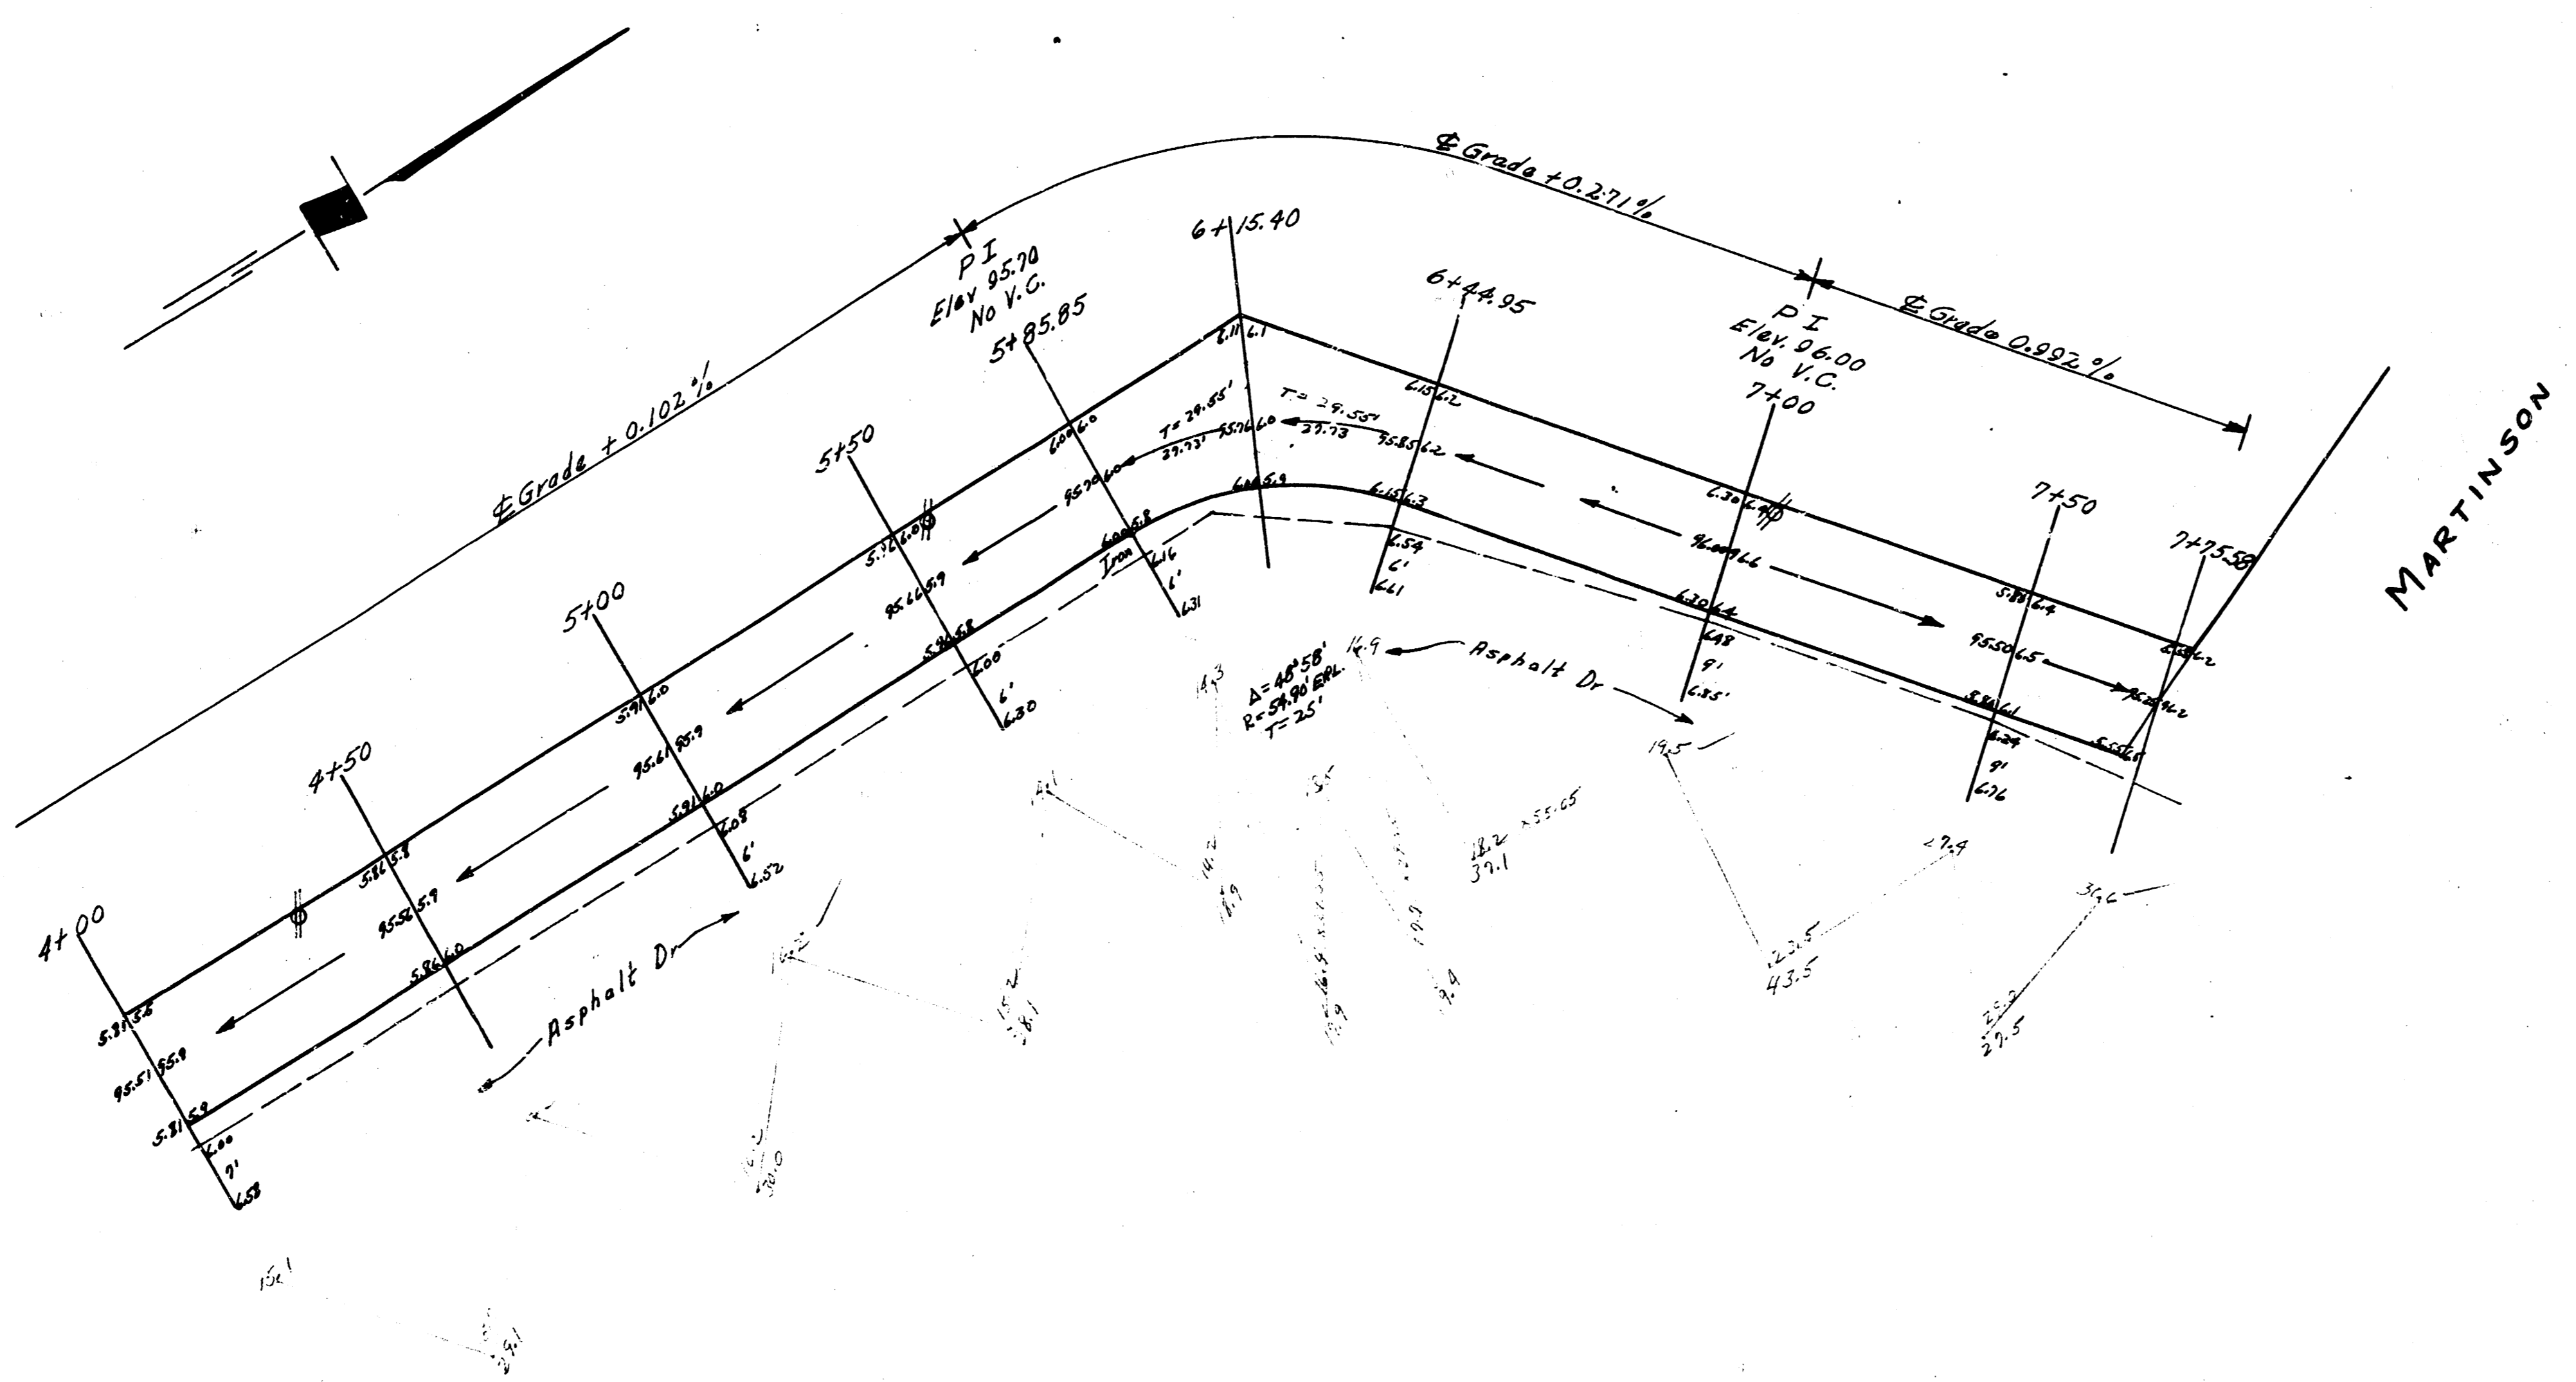





ALLEY WEST OF SENECA

N.L. 31<sup>ST</sup> TO W.L. SENECA

D.M. 95.76 Stand. S.E. Cor Seneca & 31st St. S.

Chaining & Sta on E Alley

Manson  
D.E.L.

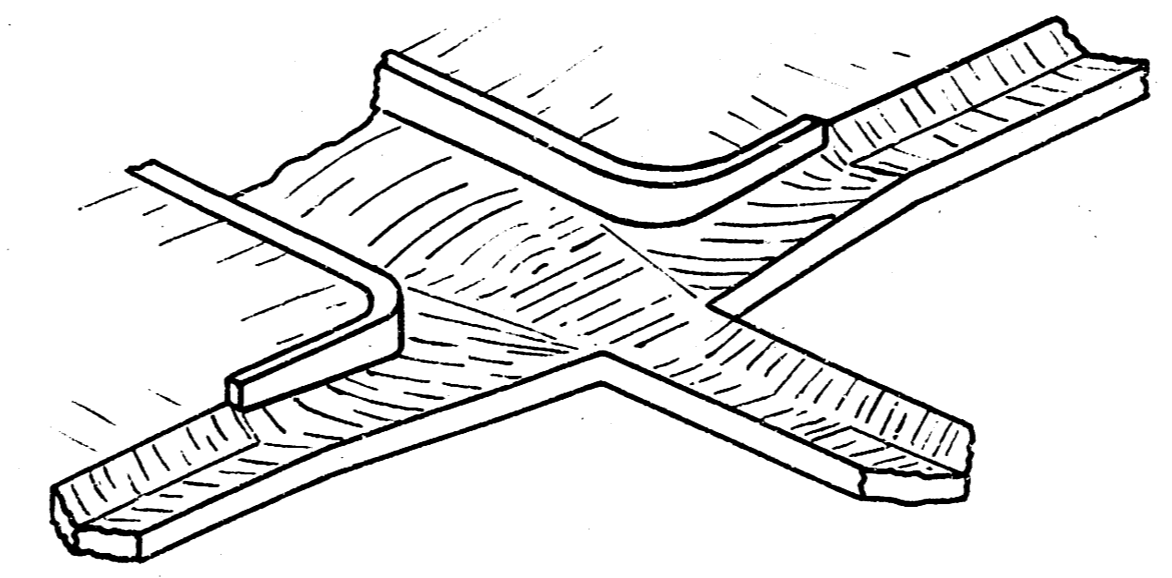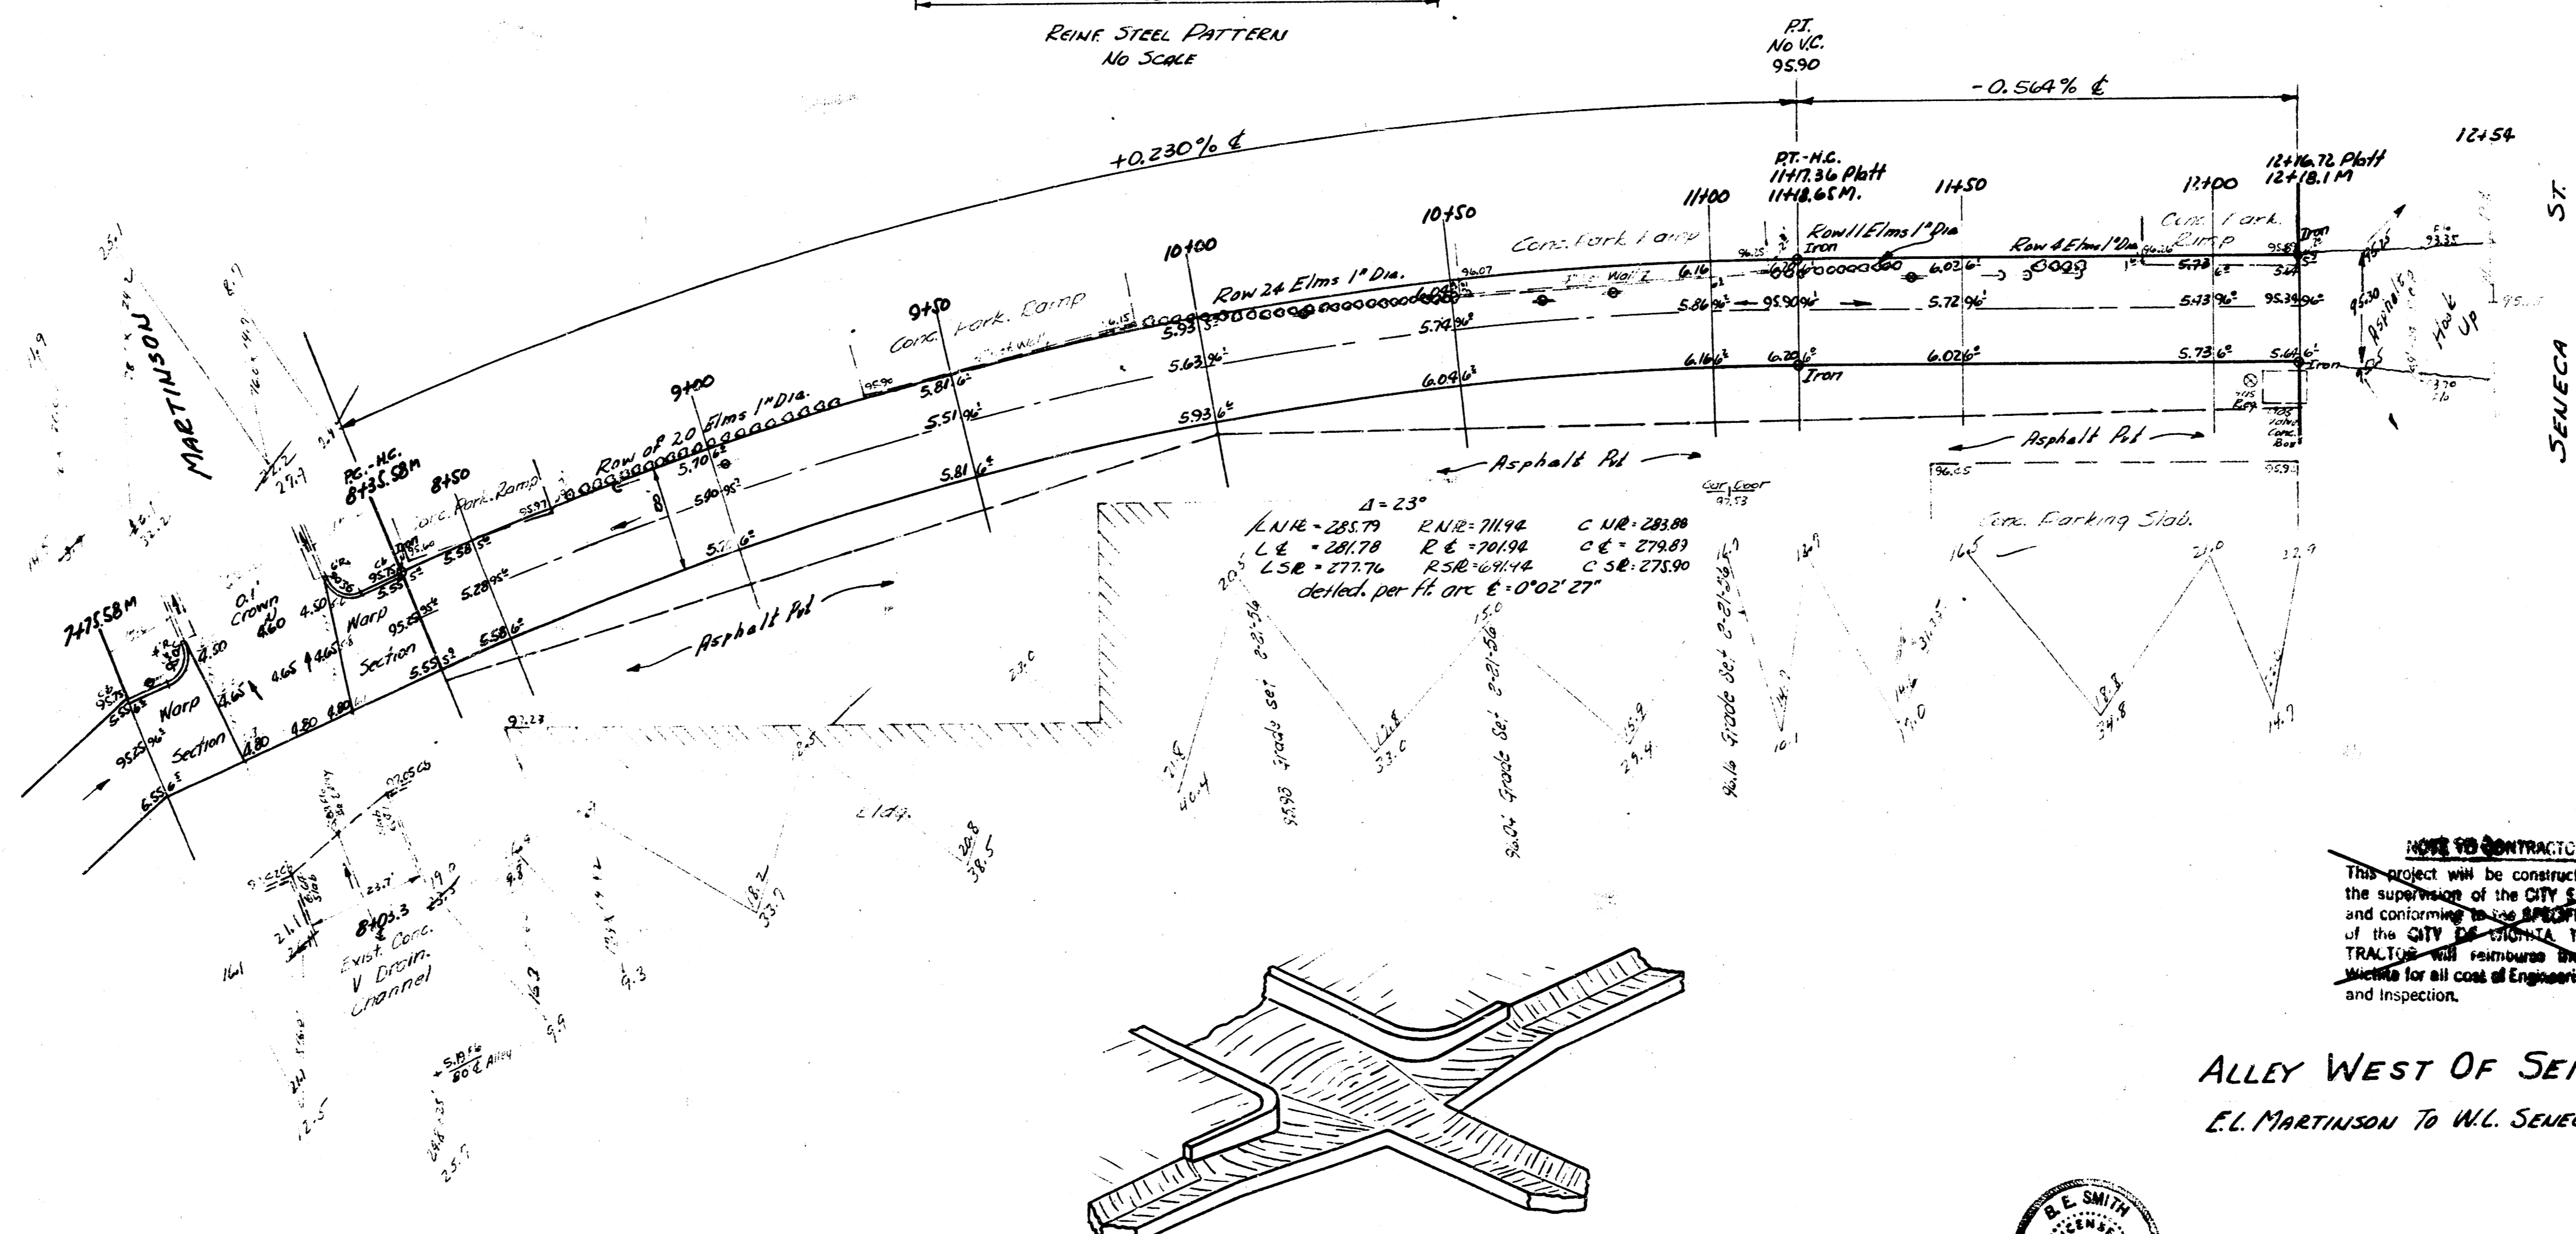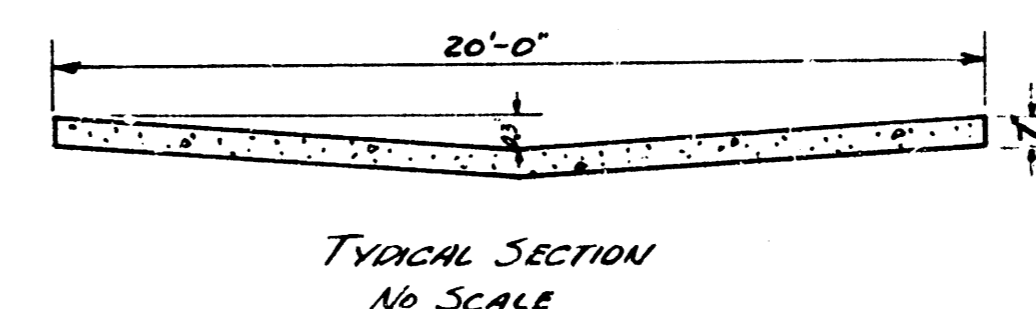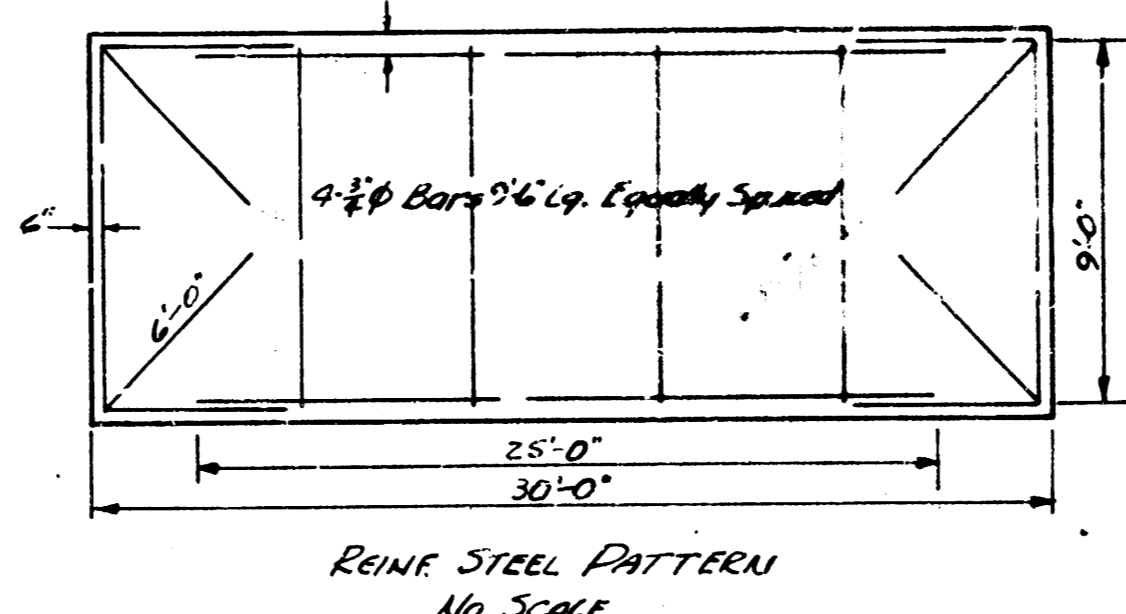

**NOTE TO CONTRACTOR:**  

ALLEY WEST OF SENECA  
E.L. MARTINSON TO W.L. SENECA



3/3

DETAIL OF INTERSECTION  
ALLEY & MARTINSON