

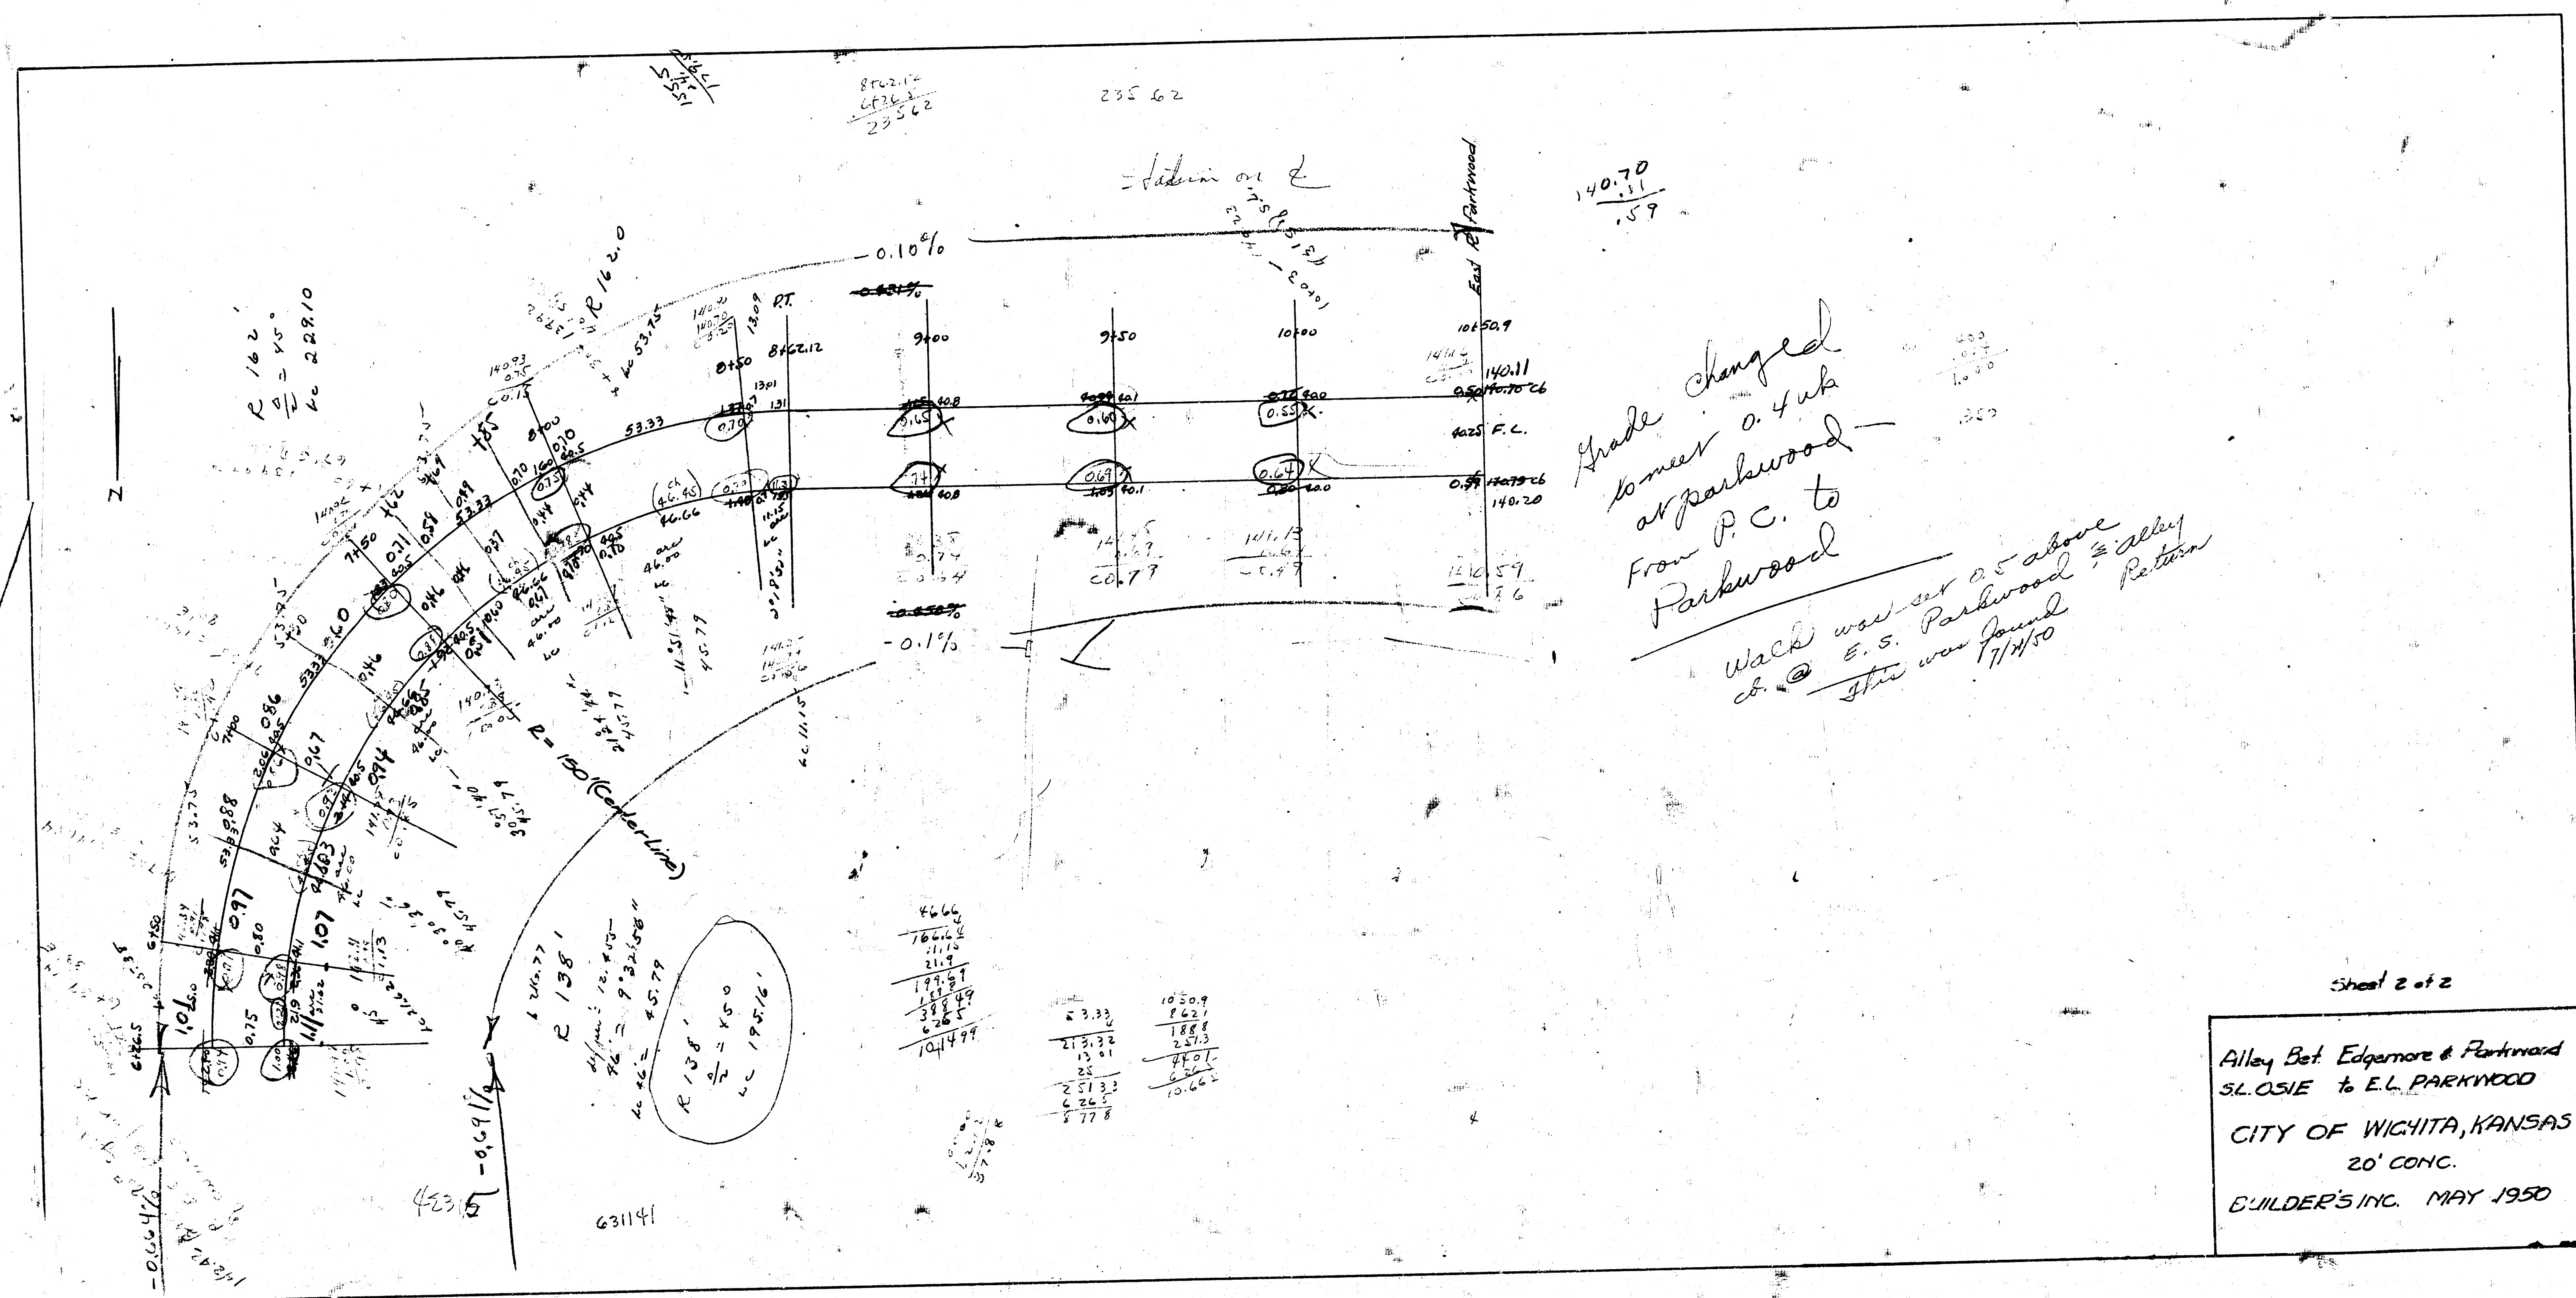
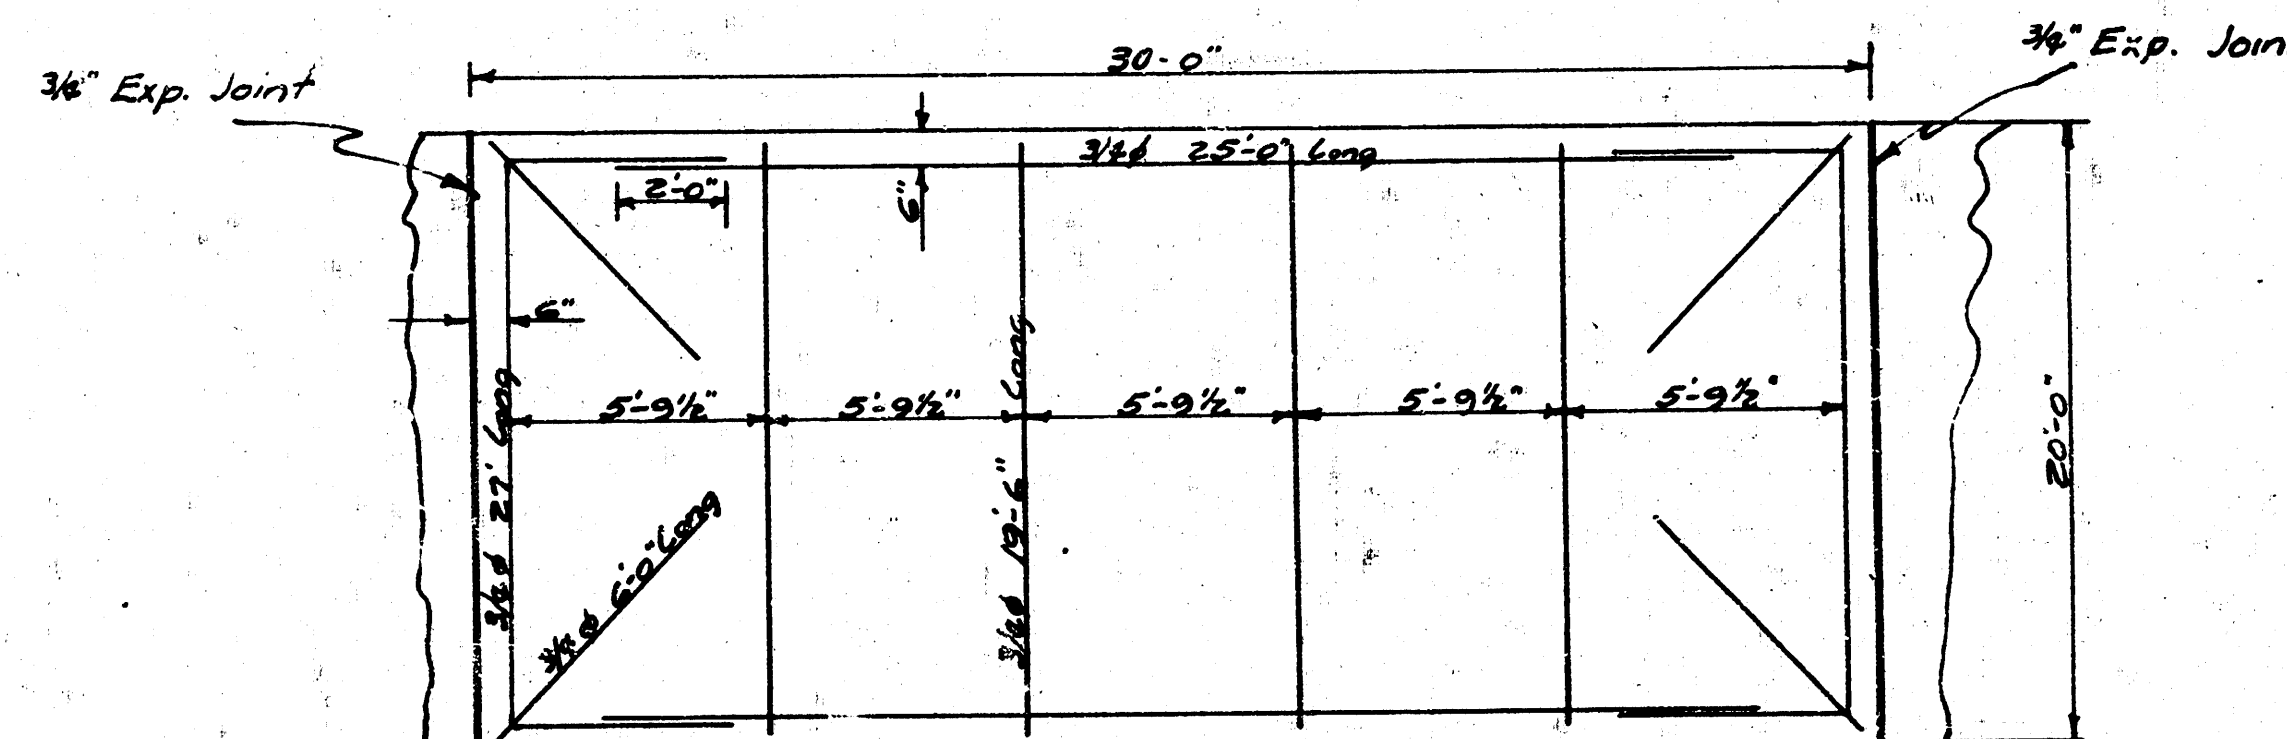


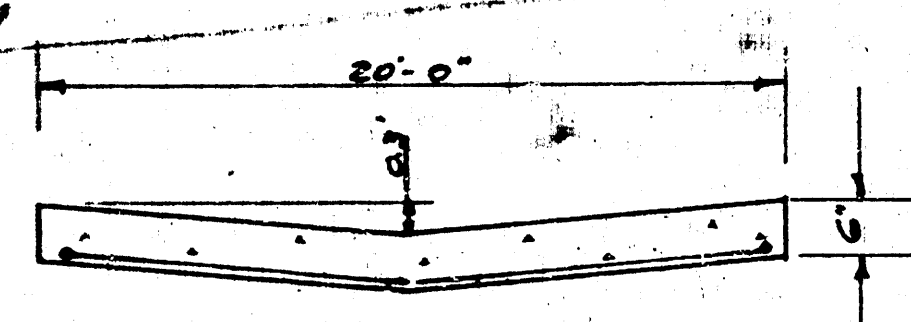

BM. 146.89 WICHITA STANDARD SW. COR. EDMORE
HARRY

Private Job.

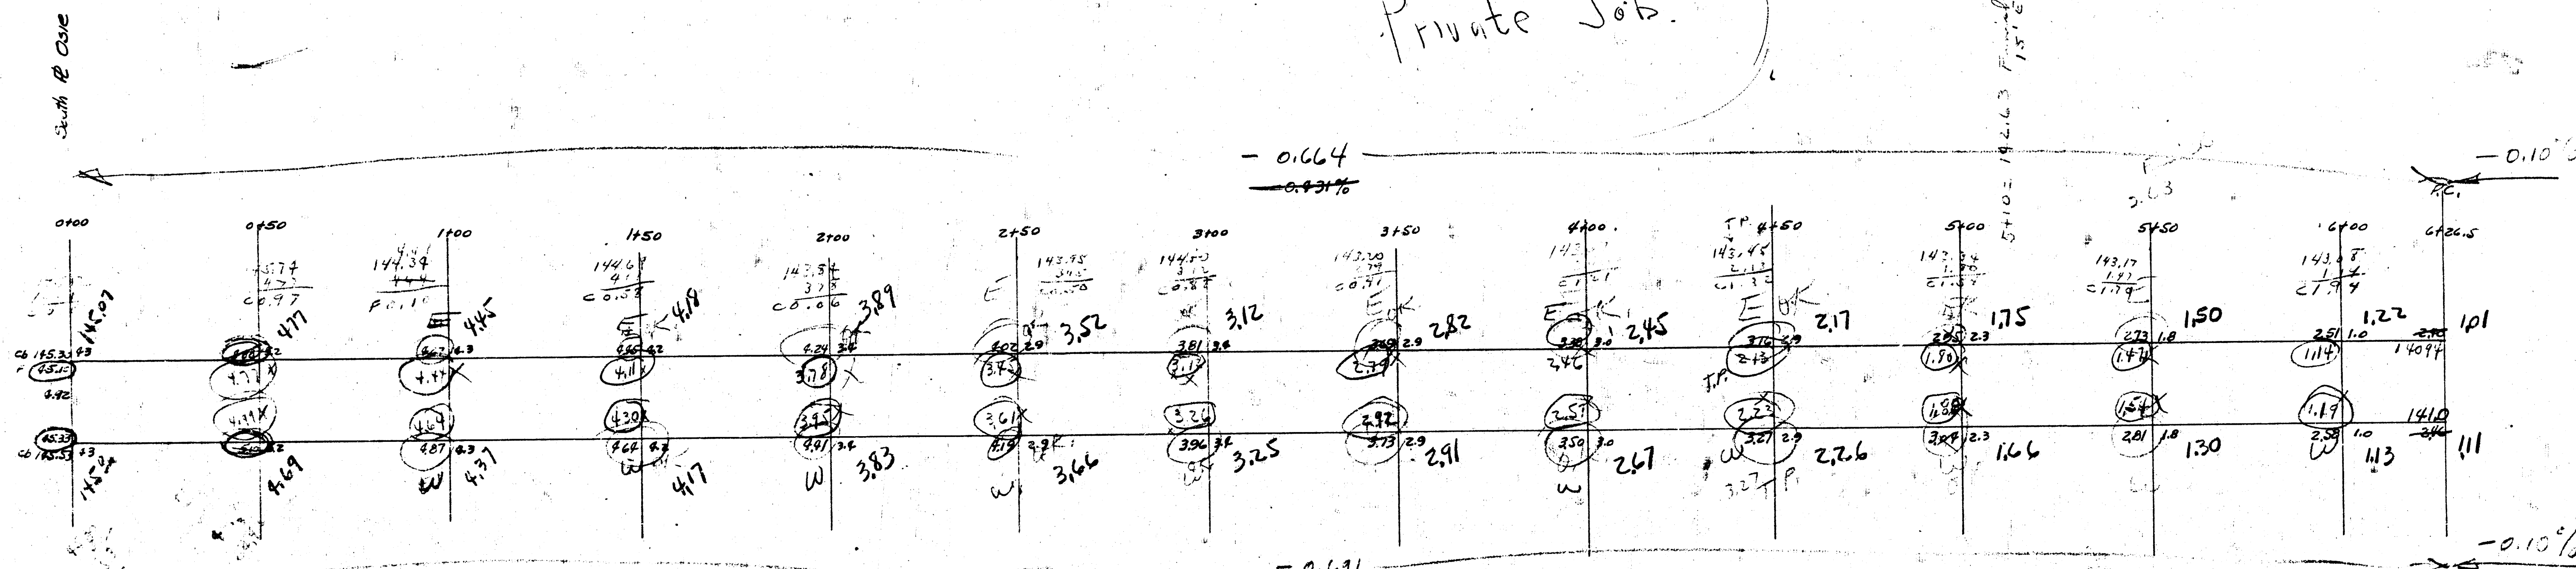

- NOTE:-
1. Elevations to Right of Sta. lines are ground Elevations
 2. All Fill under pavement shall be stabilized with sand and compacted, in 6" lifts, with a sheeps foot roller
 3. Pavement shall be poured full width in one pour
 4. Pavement shall be reinforced as shown in detail
 5. Exp. Joint. to be non-extruding type

Sheet 1 of 2

Alley Bet. Edgemore & Parkwood
SLODIE to E.L. PARKWOOD
CITY OF WICHITA, KANSAS
20' CONC.
BUILDER'S INC. MAY 1950

BM. 1683 WICHITA STANDARD SW. COR. EDGEWOOD
HARRY

Note: This plan has been changed.
See attached prints

