
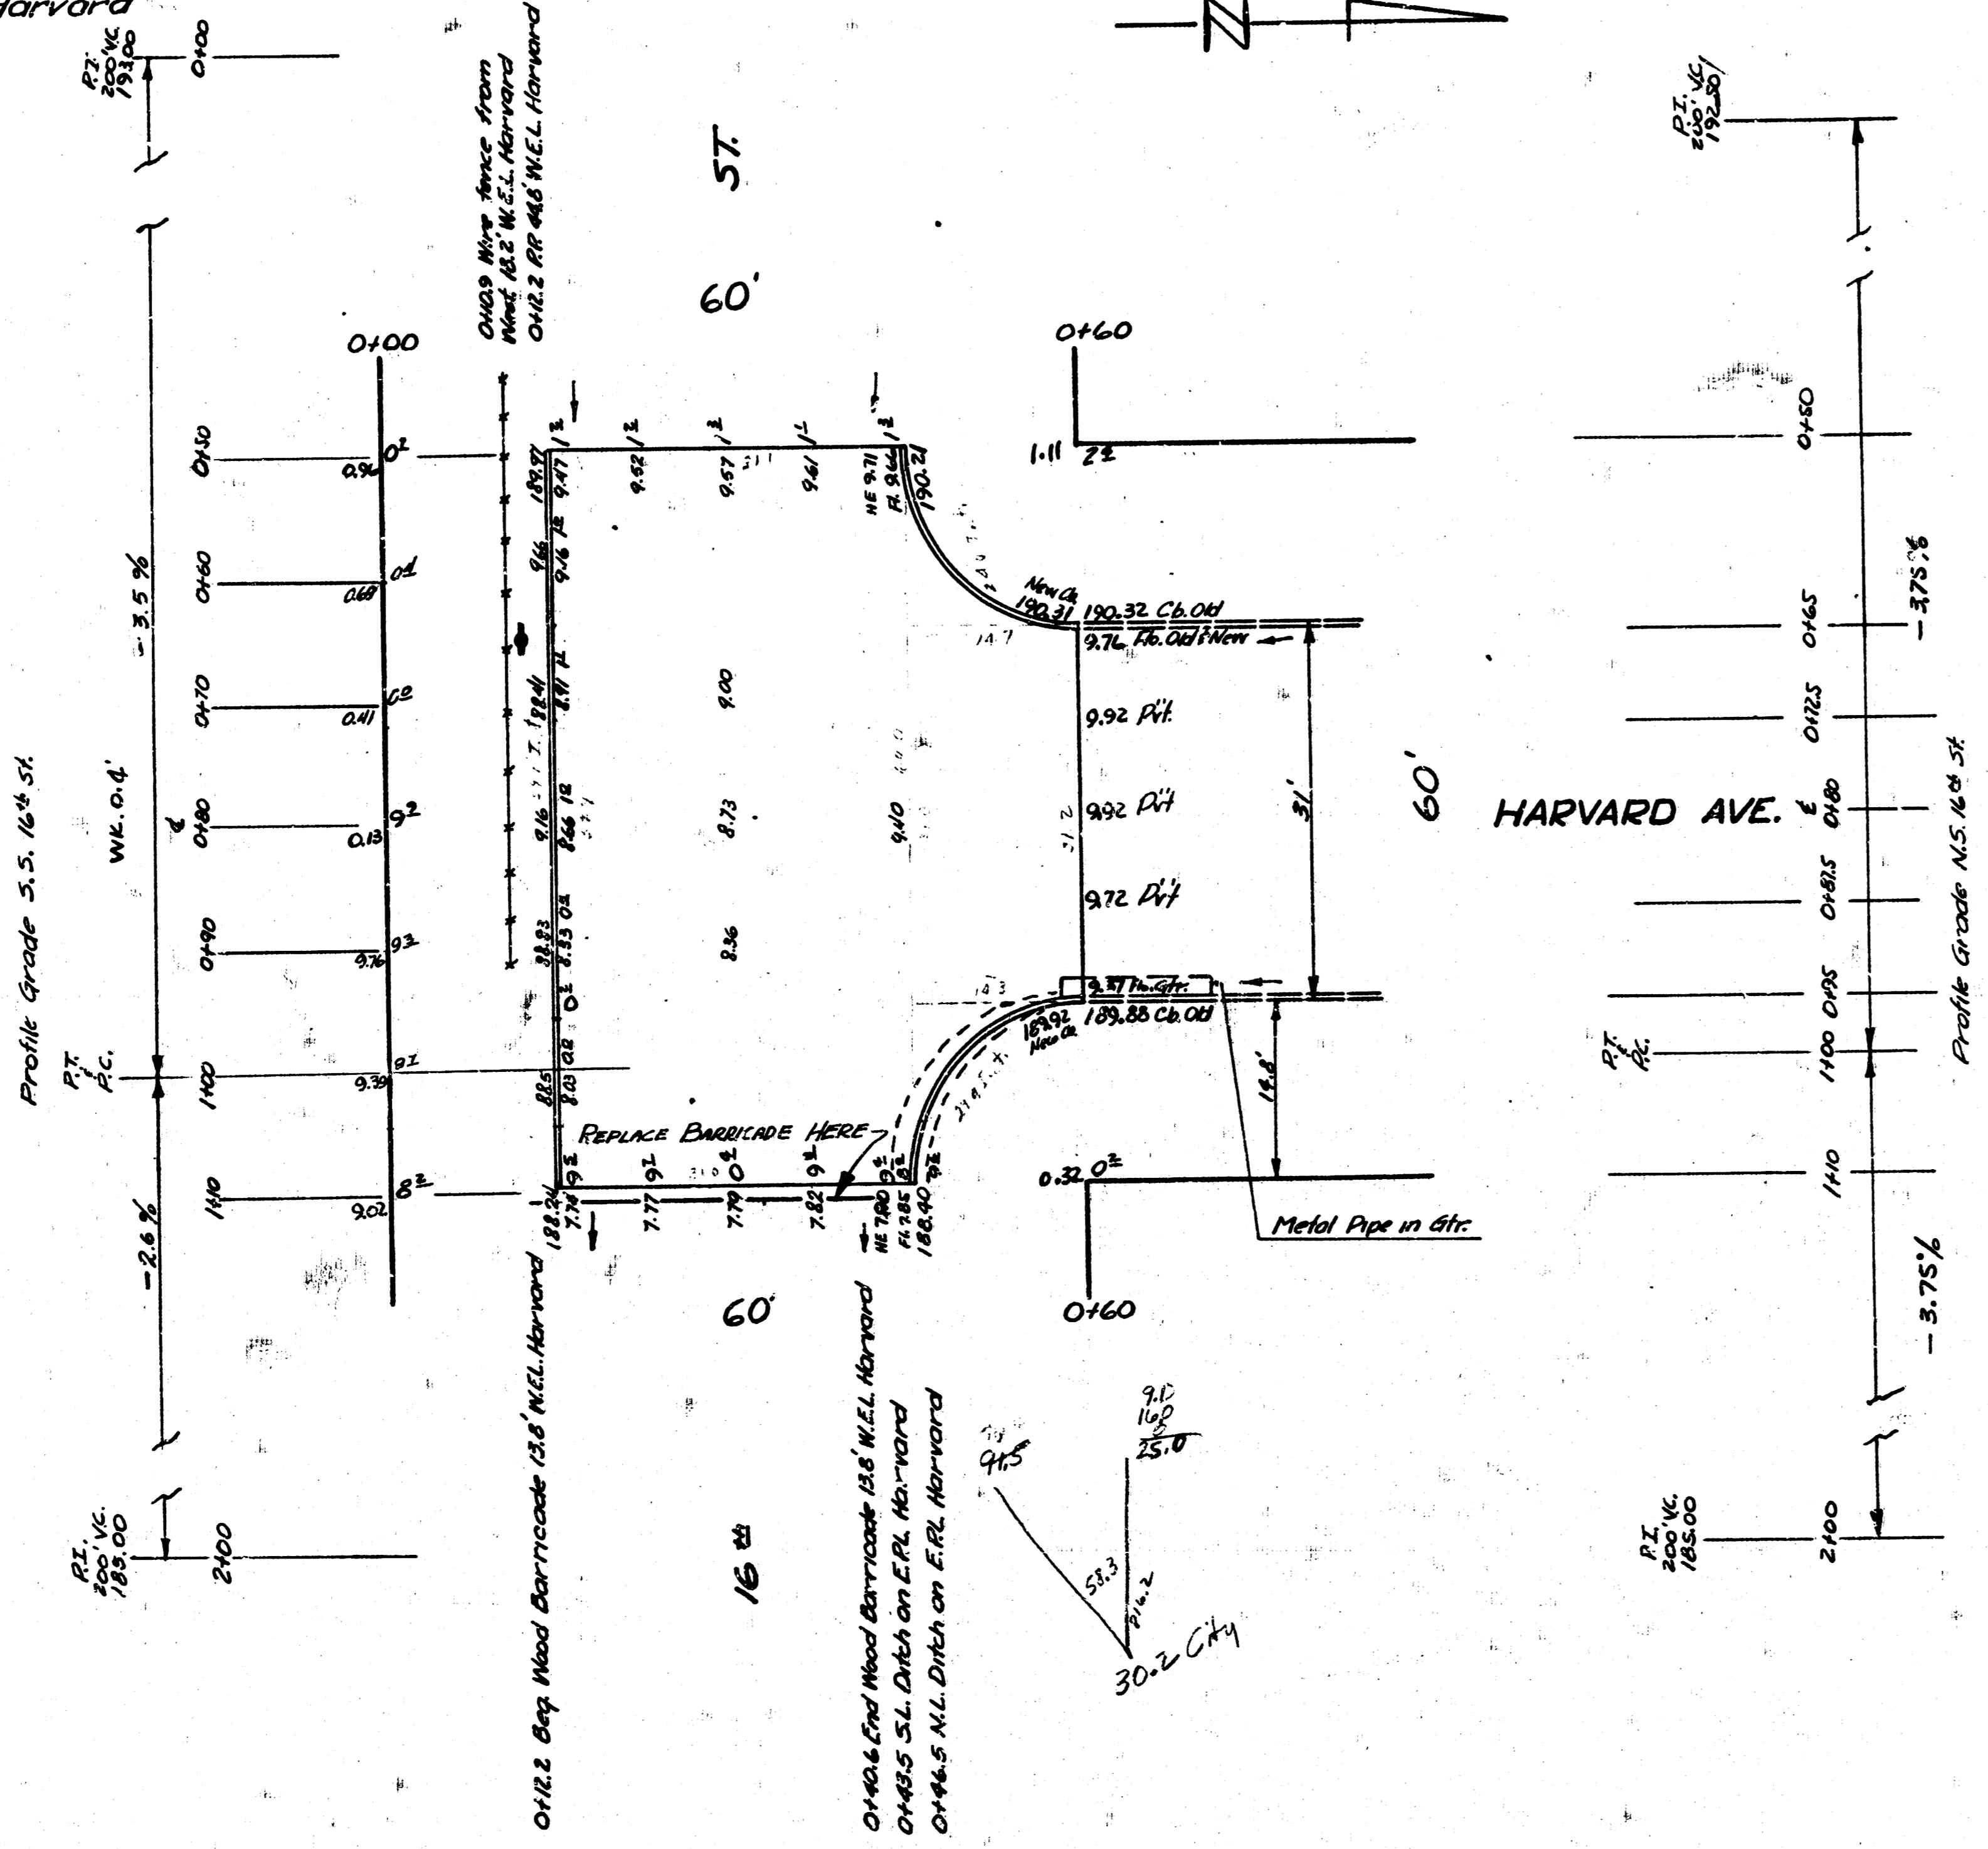


MG 6


B.M. 19298 'G' in Globe Ctr. N. Rod. Dr. Ho. # 1705 Harvard
 B.M. 19964 '+' in Pkt. in E. 17th E.L. Harvard

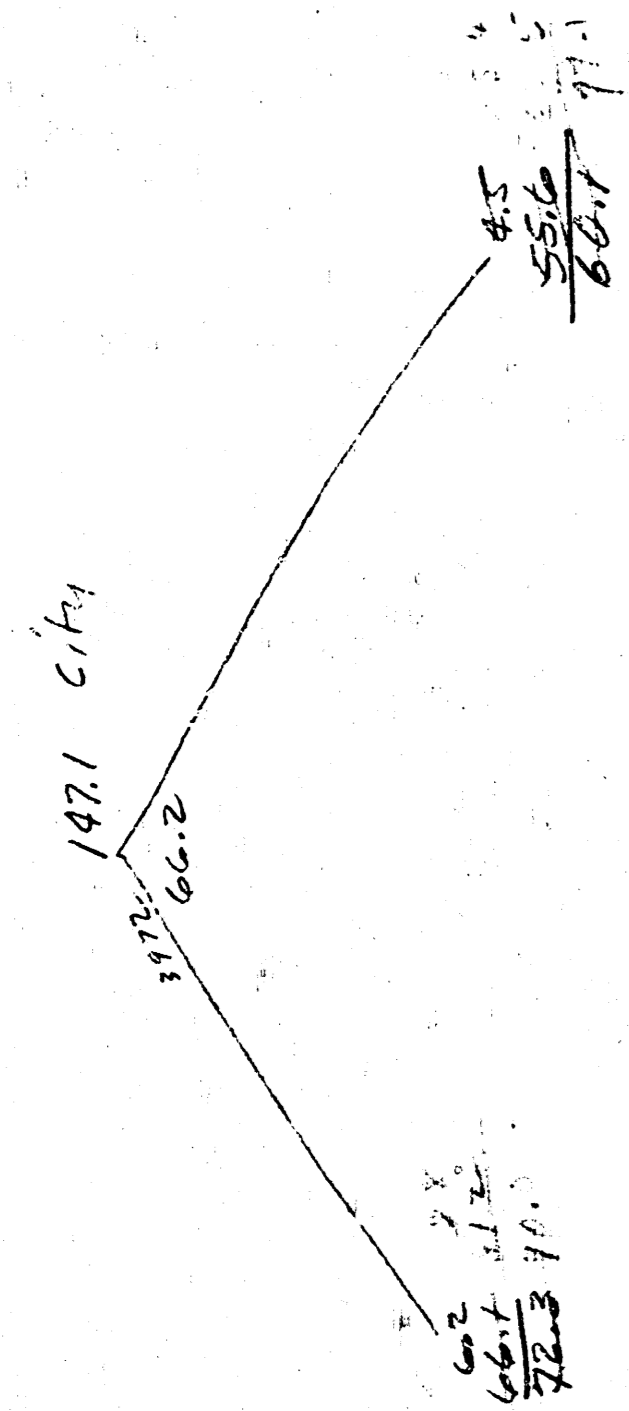

Excess

Prop.	City
0	147.1
	30.2
	177.3
110.0	17.7
Total 175.0 Cu. Yds.	

INTERSECTION
 16th HARVARD
 6" CONC.
 CITY OF WICHITA, KANS.
 L.K. WHITE CITY ENGINEER
 JAN. 1951 PROJ. NO. C11-5

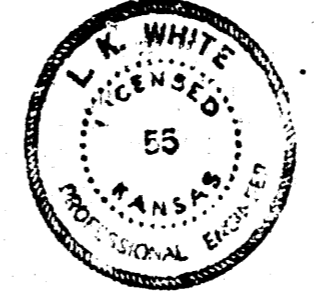

58