
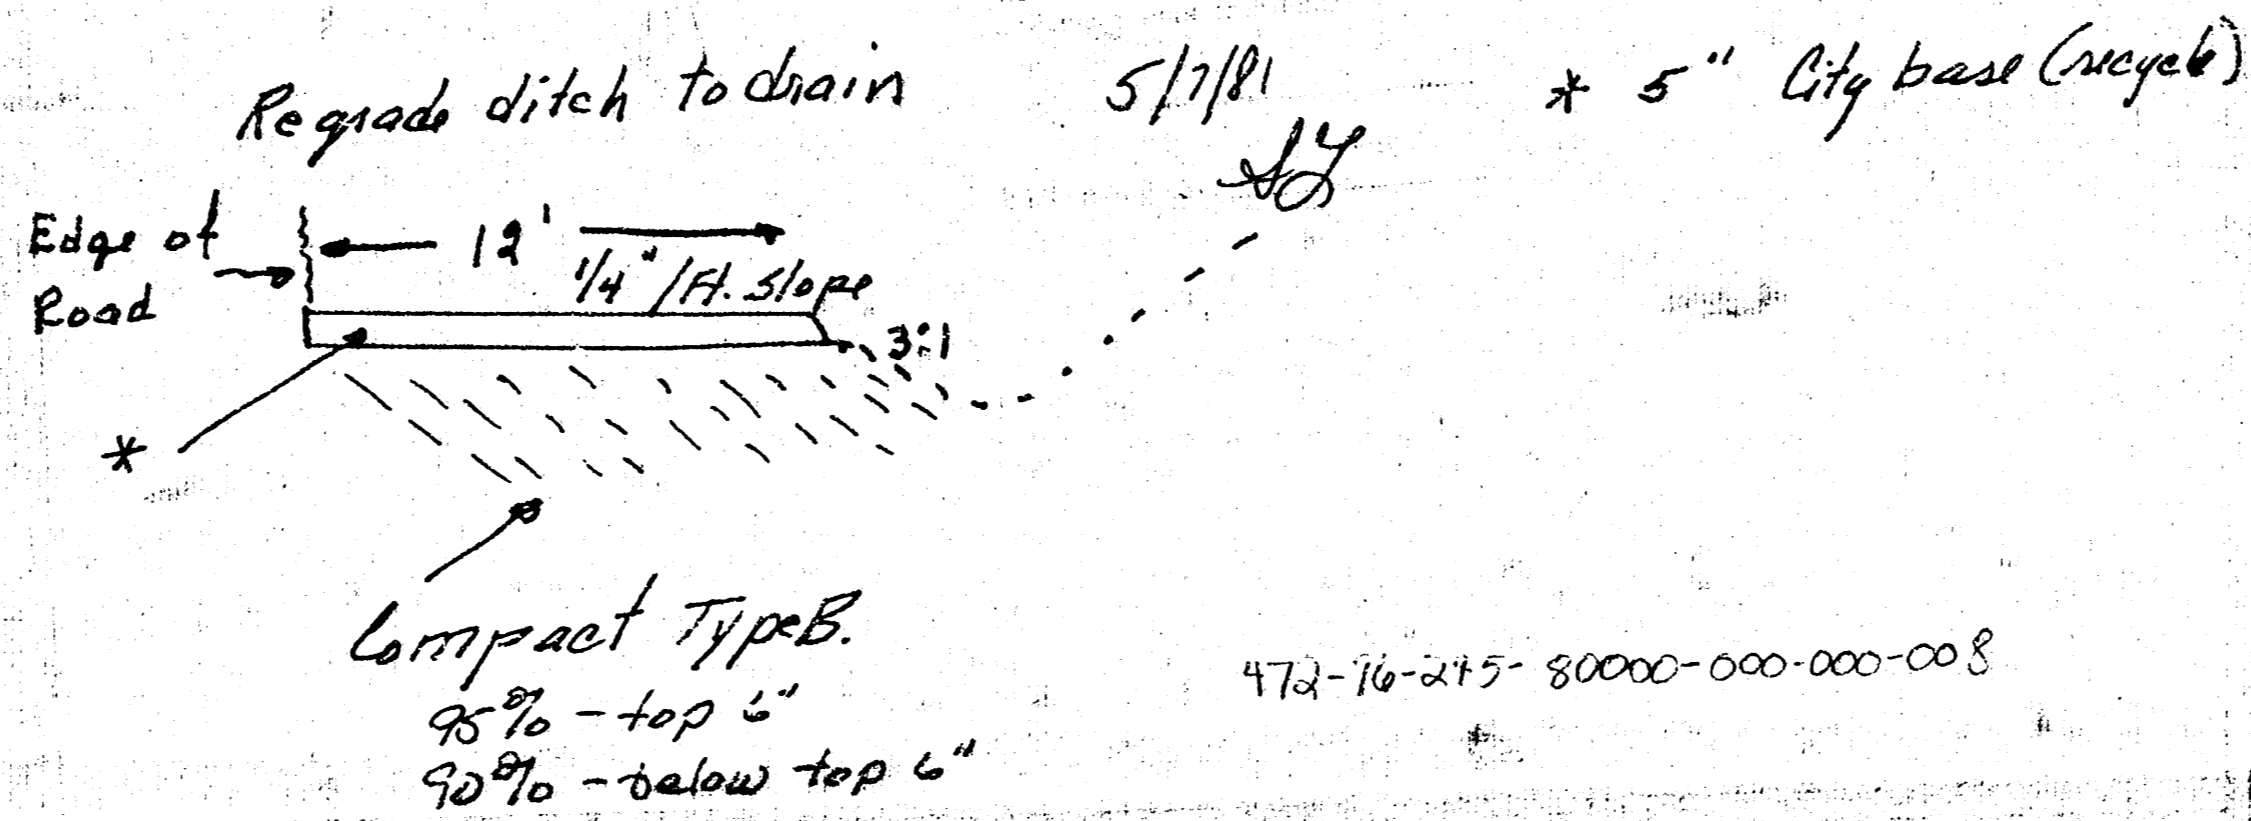


Decoll Lane 13th & Oakwood

13th

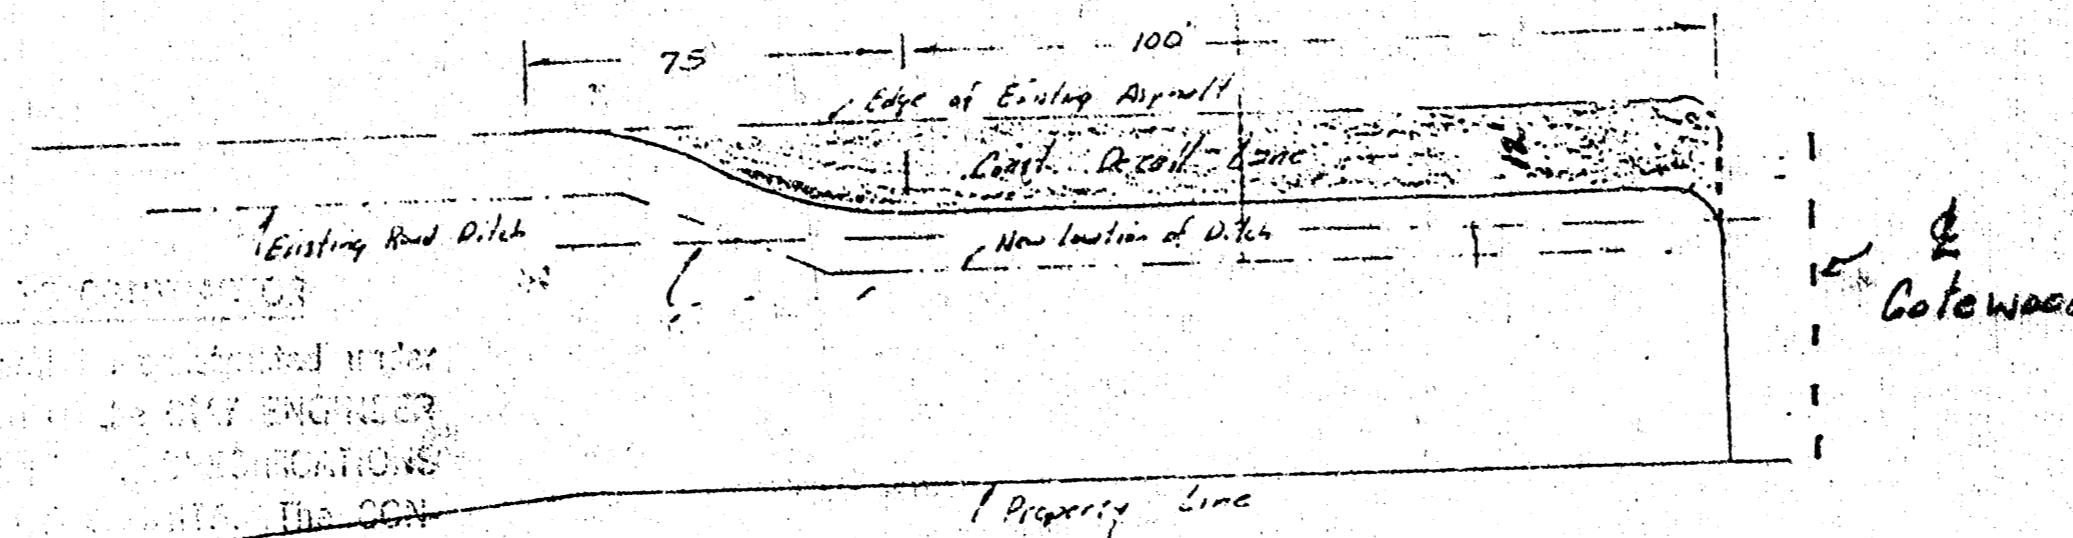

Compact Type B.

95% - top 6"

90% - below top 6"

472-76-215-80000-000-000-008