B.M. Iron in thimble C. Palisades + 53 Boston 105.51

ALLEY BETWEEN BOSTON & SHIRK. 25' CONCRETE.
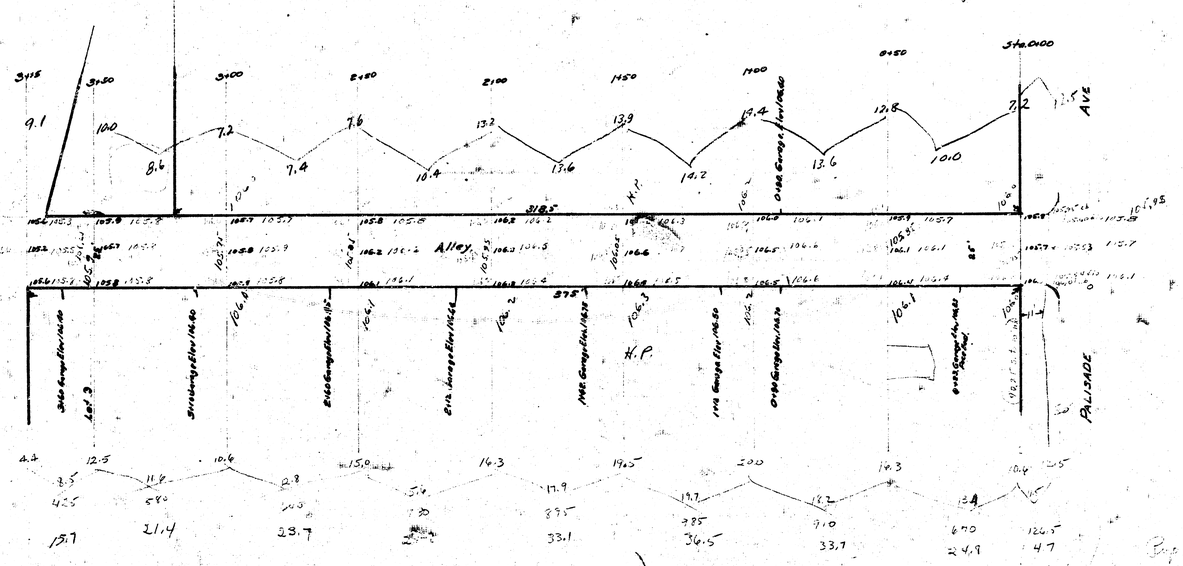
Rebuild fence at Palisade