

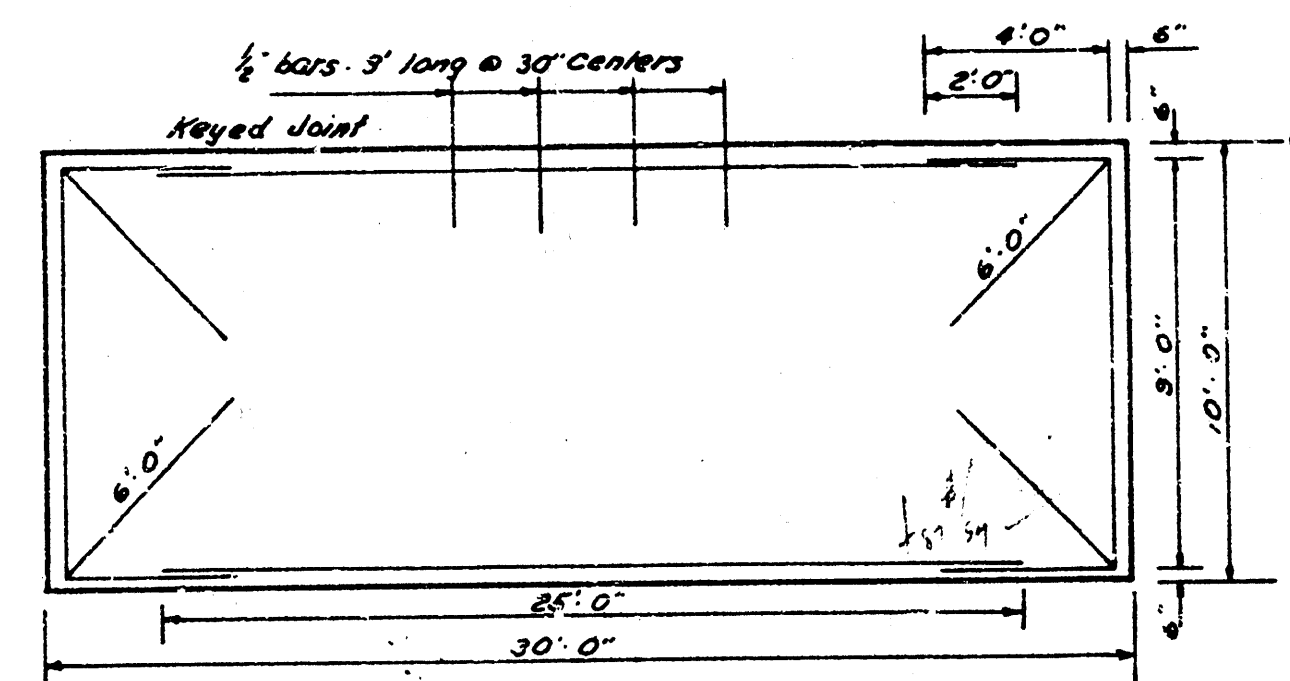


Drawing DWG 19-20-6
 City Engineer
 Date July 1969

Base Line is the East Line of the Alley
 BM = 101.39 S. End of West Cb. on Alley Return Between Meridian & St. Clair

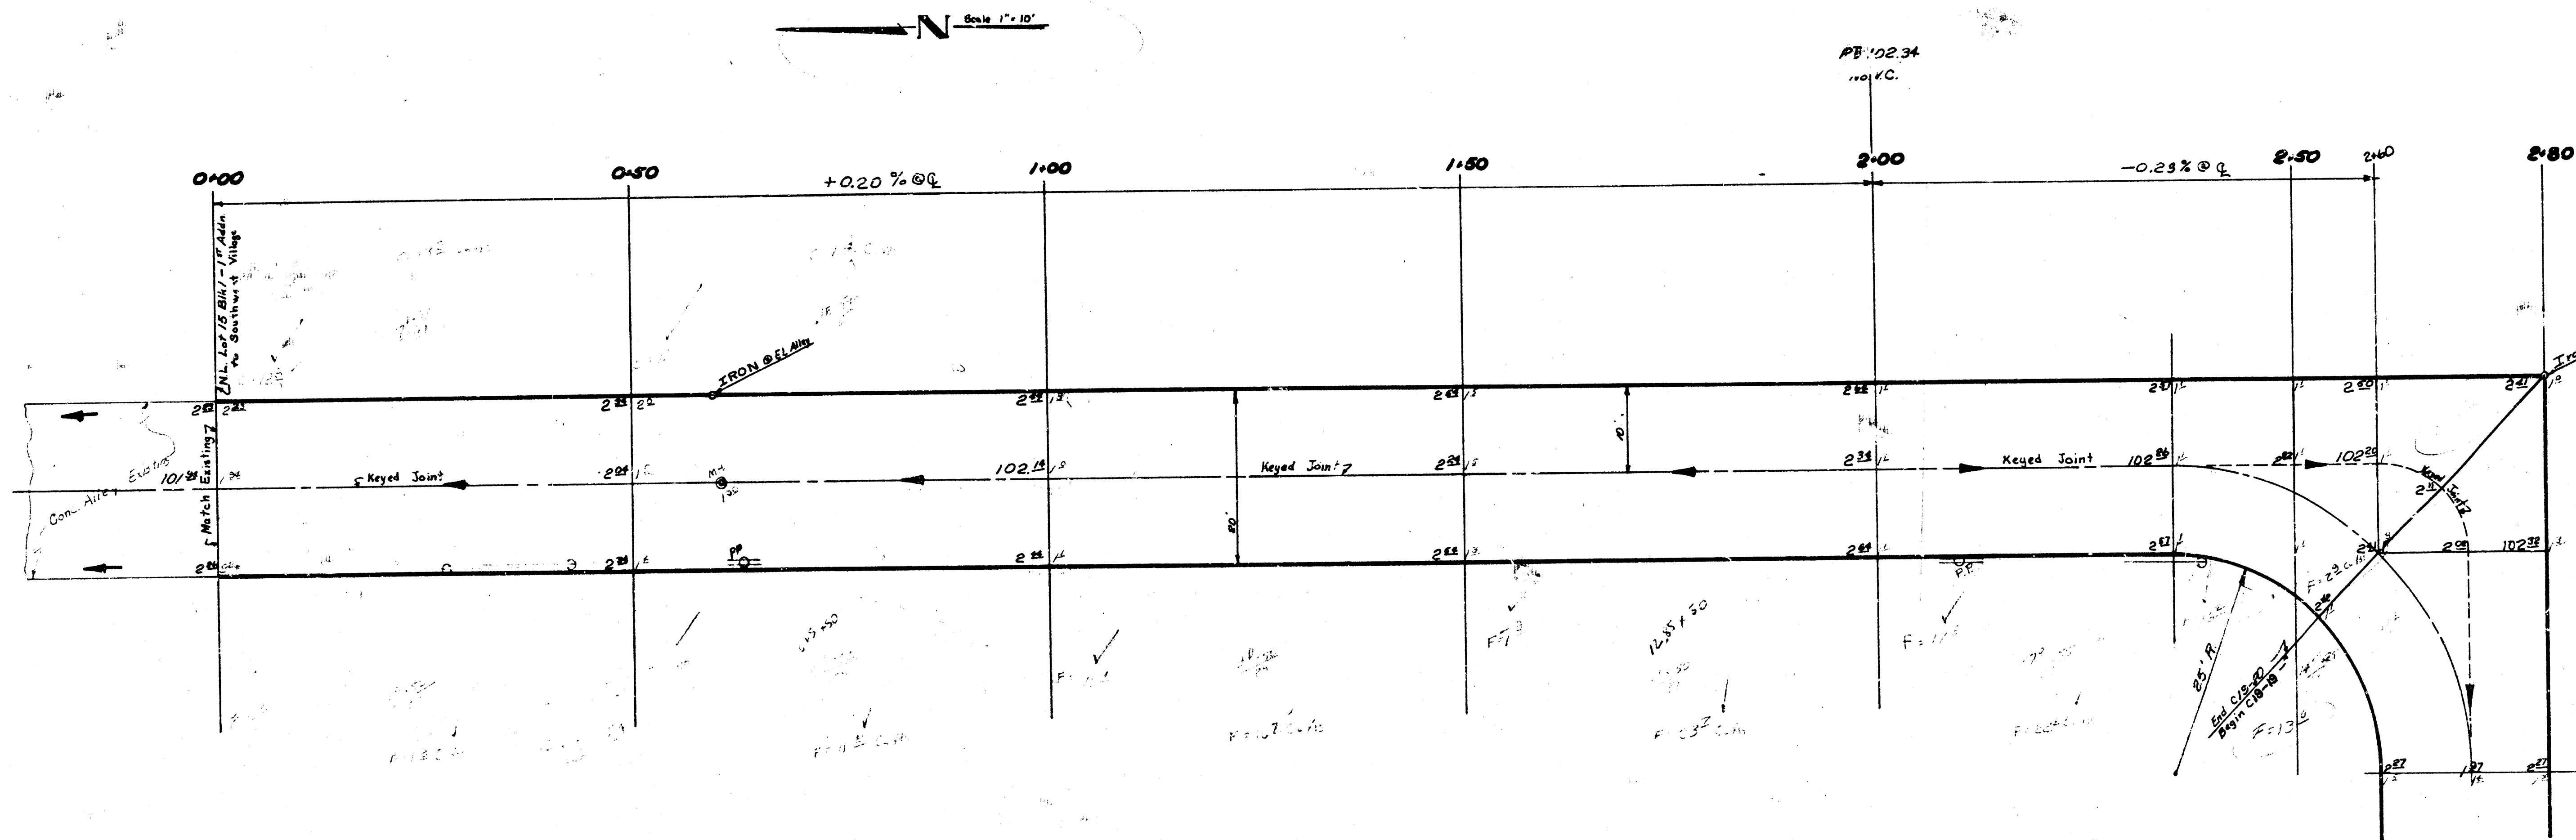

Steel Pattern
 All steel 1/2" x 1/2" except where noted
 No Scale

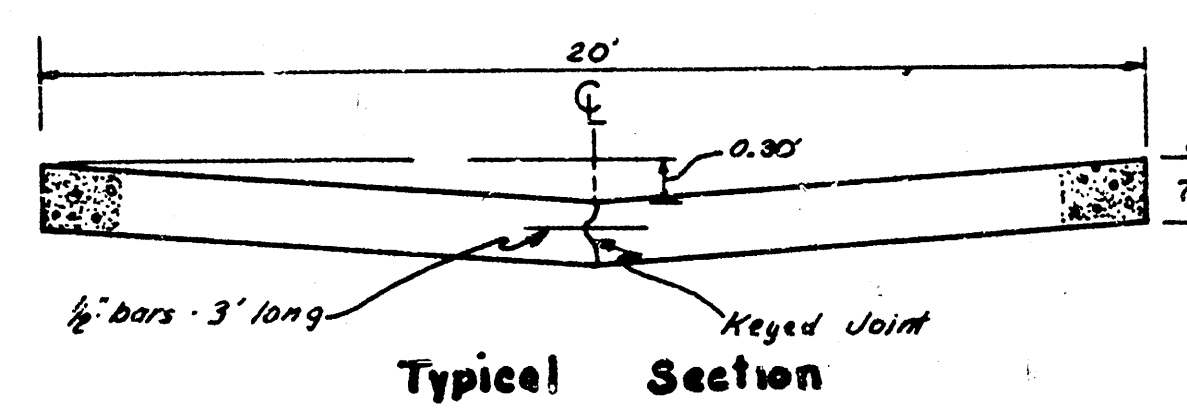

Typical Section
 No Scale

Comp. Fill	
89.1	Cu. Yds.
+10% 9.9	
Total 99.0	Cu. Yds.

Excavation	
14.6	Cu. Yds.
+10% 1.5	
Total 16.1	Cu. Yds.

690 Sq. Yds. Lime Treated Sub-Grade



ALLEY BET. MERIDIAN & ST. CLAIR
 From St. Alley S. of Pawnee to N.L. Lot 15
 Blk 1, First Addn. to Southwest Village - 20'-7" Conn.
CITY OF WICHITA, KANSAS
 B. E. Smith City Engineer
 Date JULY 1969 Proj. No. C19-20