BM. 107.22 □ on N. end E.cb. Alley N.L. Indianapolis
B.M. 109.35 N.E. cor. lower step E ent. Skelly Oil Bldg. S.S. Orme

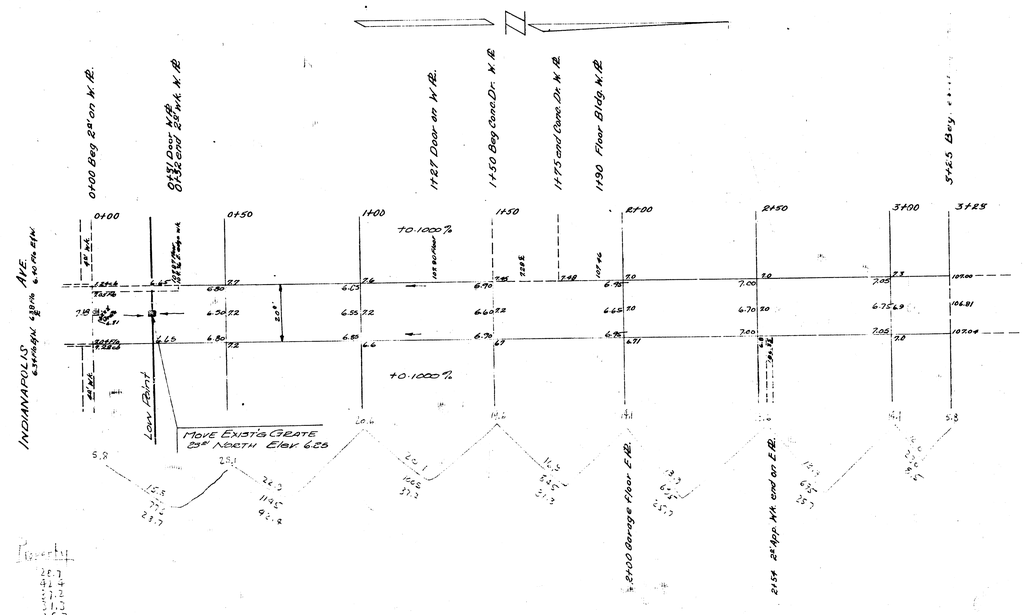

Quantity
28.7
41.4
37.2
31.0
25.7
25.7
9.5
199.5
20.0 = 10%
219.5 Total Cu. yds. excavation

ALLEY
BET. WASH. & MOSLEY N.L. IND'P'LS EXISTING PVT.
T" CONC 20'
CITY OF WICHITA, KANSAS
L. K. WHITE CITY ENGINEER
JAN 1951 PROJ. NO. C10-157