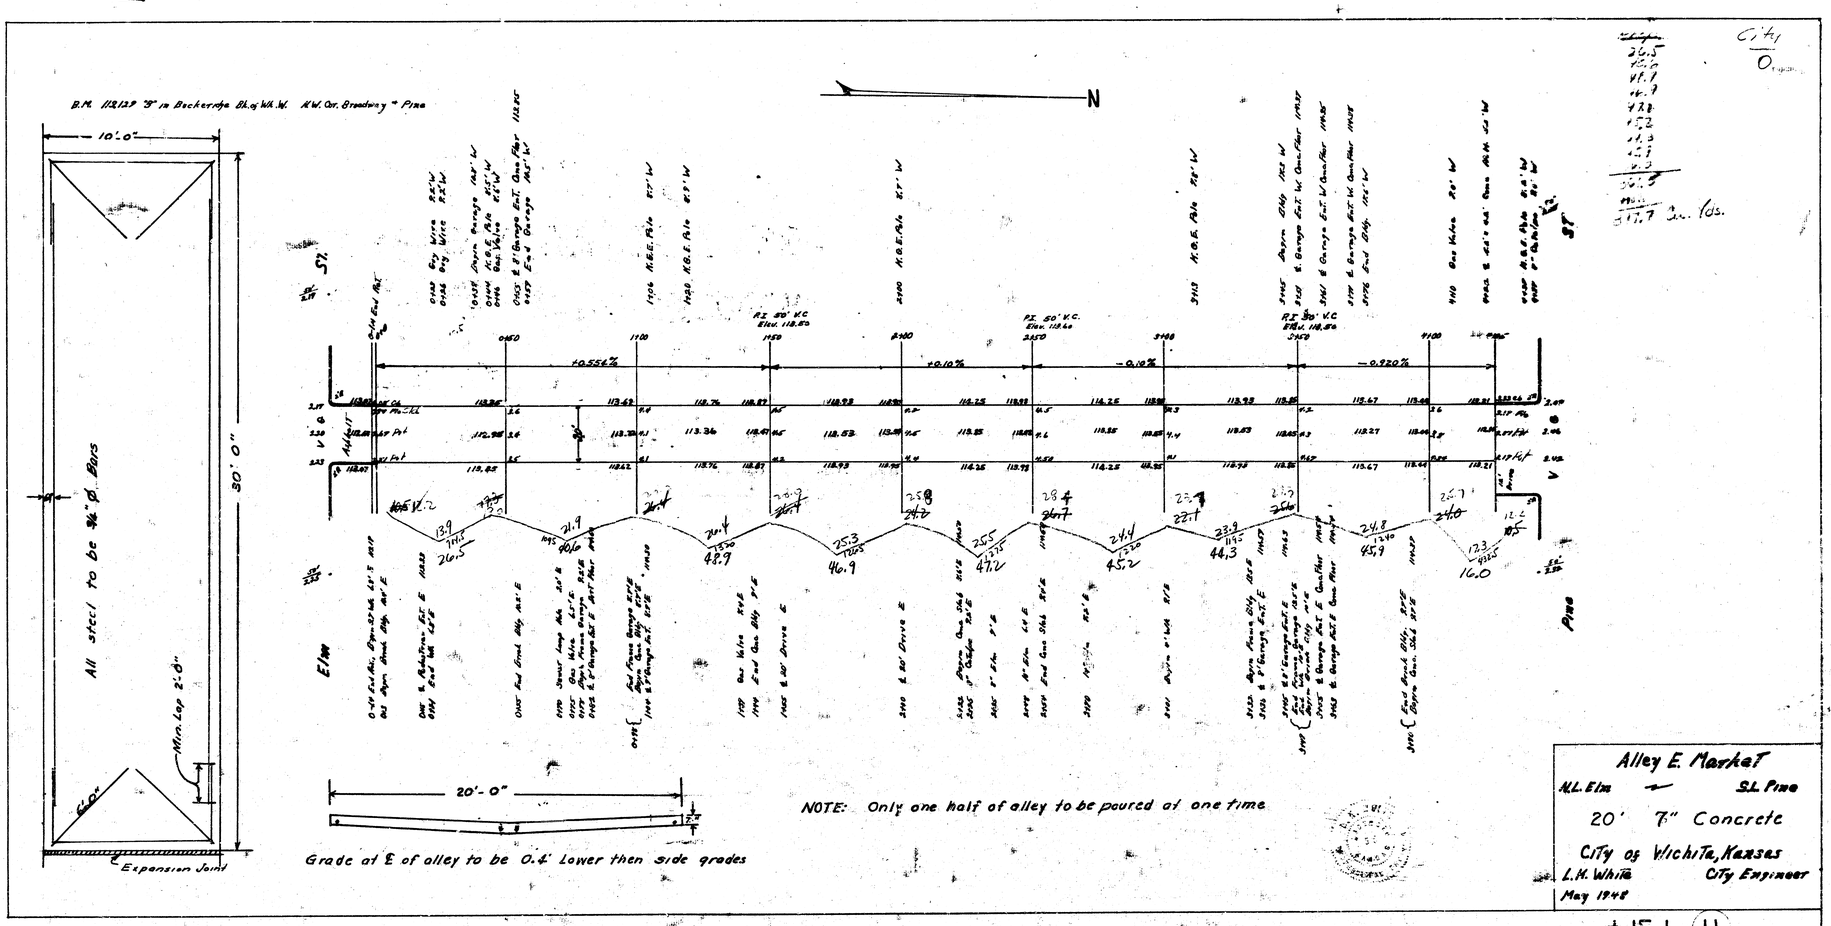
B.M. 112.137 "S" in Rockcrete Blk. of Wk. W. N.W. Cor. Broadway & Pine
10'-0"
30'-0"
All steel to be ¾" ø Bars
Min. Lap 2'-0"
Expansion Joint
20'-0"
Grade at ℄ of alley to be 0.4' Lower than side grades
N
Elm
Pine
+0.556%
+0.10%
-0.10%
-0.920%
P.I. 50' V.C.
Elev. 118.80
NOTE: Only one half of alley to be poured at one time
Alley E. Market
N.L. Elm — S.L. Pine
20' 7" Concrete
City of Wichita, Kansas
L.H. White City Engineer
May 1948

#151 (15)