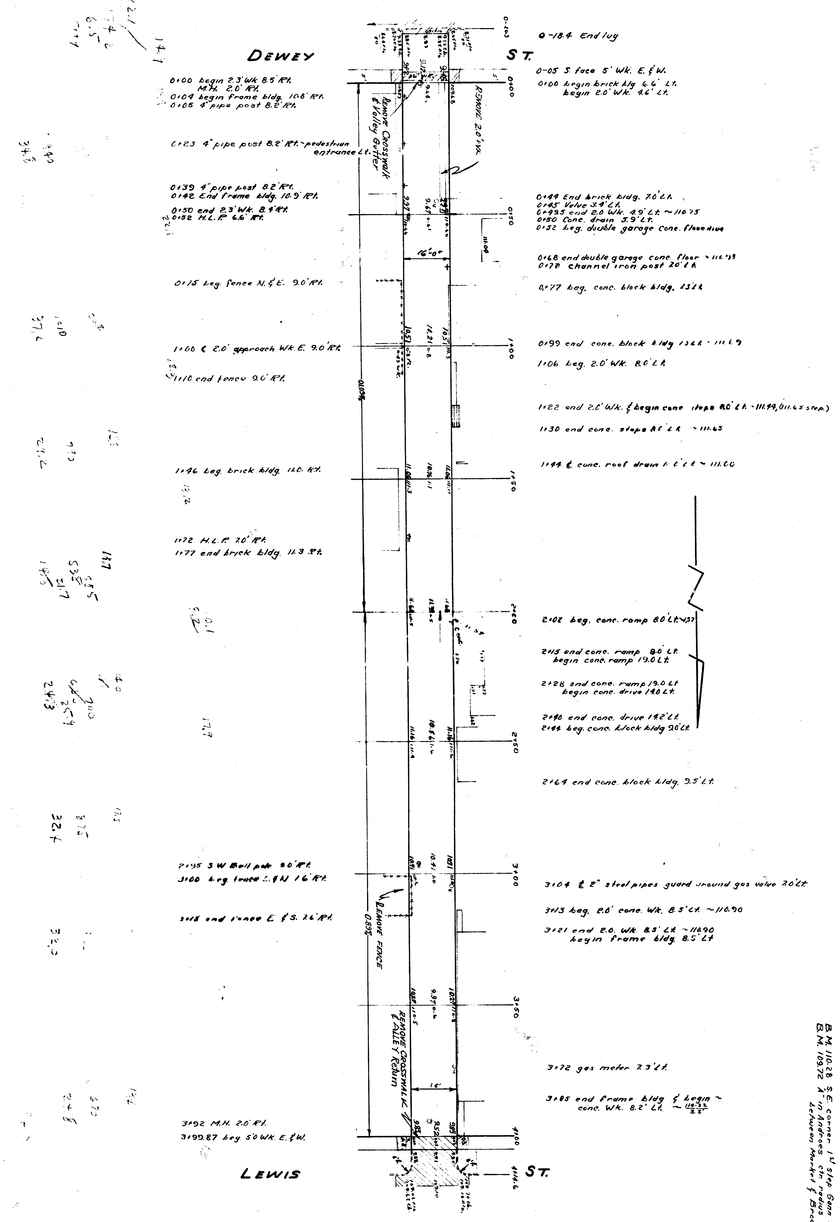

ALLEY BET. MARKET & BROADWAY
N.L. DEWEY ~ S.L. LEWIS
16' CONC. - 7"
CITY OF WICHITA, KANSAS
L.K. WHITE CITY ENGINEER
MAY 1929 PROJ. NO. C19-86