


ALLEY NORTH OF DOUGLAS
FROM EMPORIA TO ST. FRANCIS AVE.
WICHITA KANSAS
CORRECTED TO JANUARY 1924.

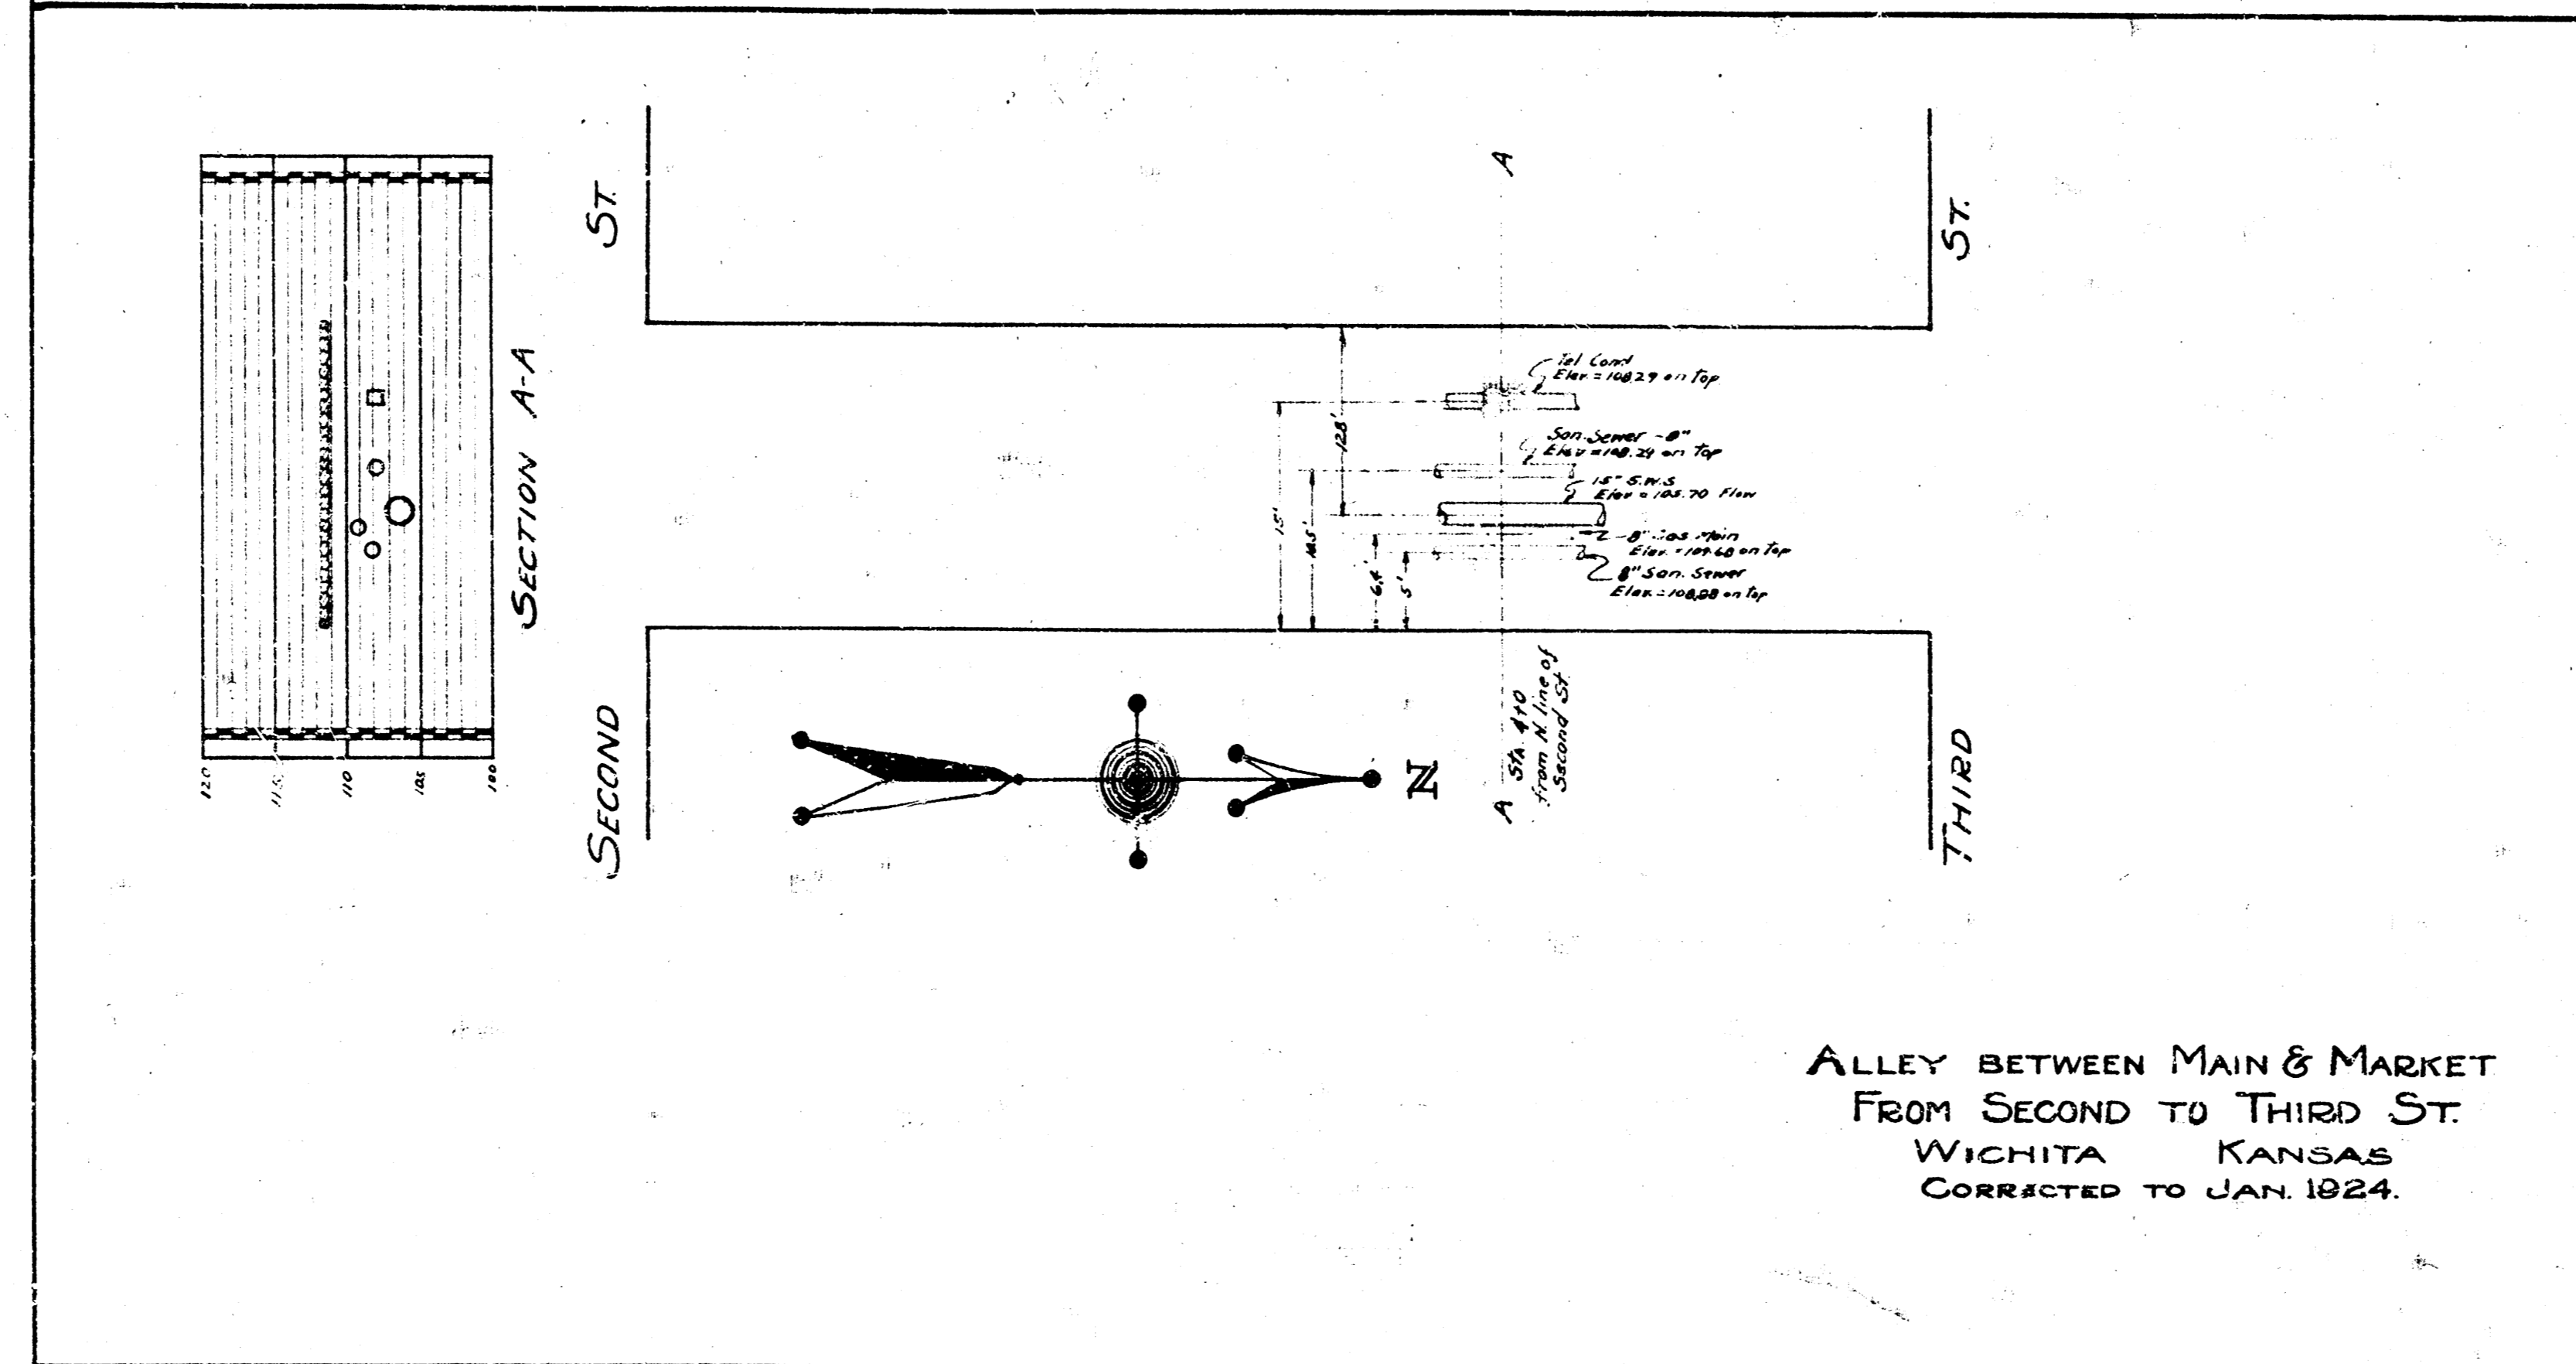

ALLEY BETWEEN MAIN & MARKET
FROM SECOND TO THIRD ST.
WICHITA KANSAS
CORRECTED TO JAN. 1924.