
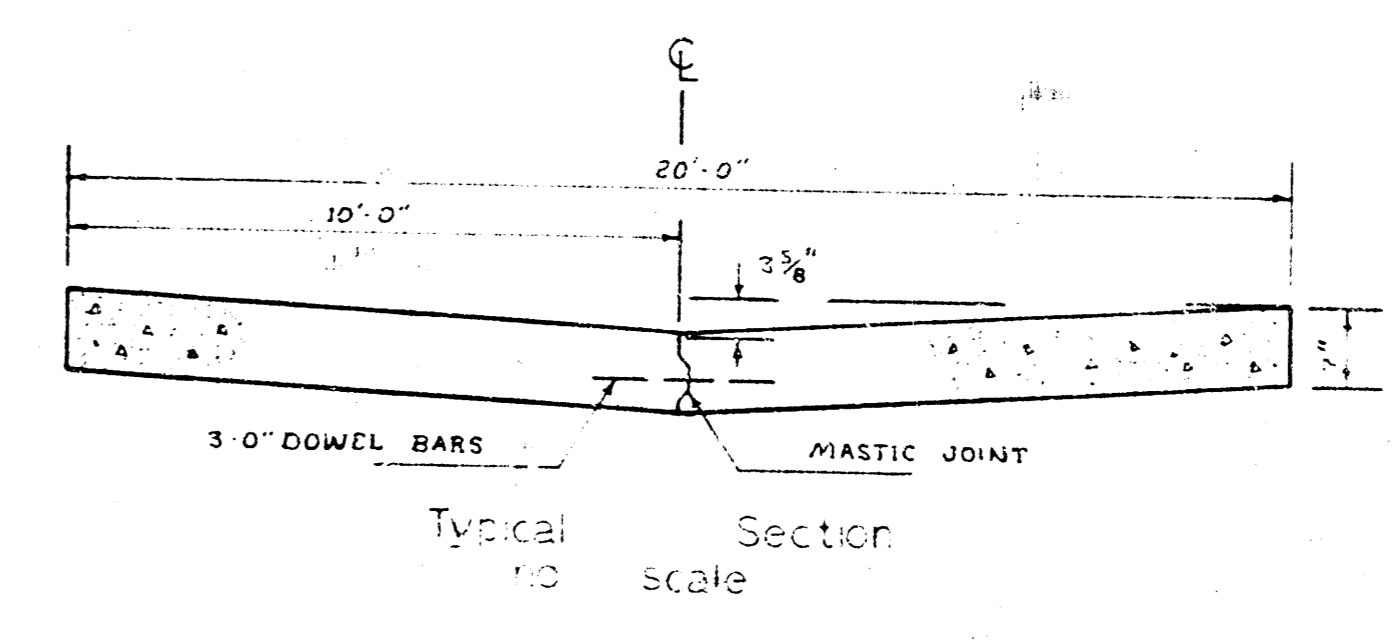


N  
Scale 1" = 20'

LIST OF QUANTITIES		FINAL
1,585	Sq yds pavement	1,586.6 SY.
685	Lin feet mastic	7,070 LF.
10,300	Lbs rein steel	10,395 LBS.
44	Lin feet int curb	43.8 LF.

NOTE: Field Eng to cross section prior to construction for earthwork quantities.

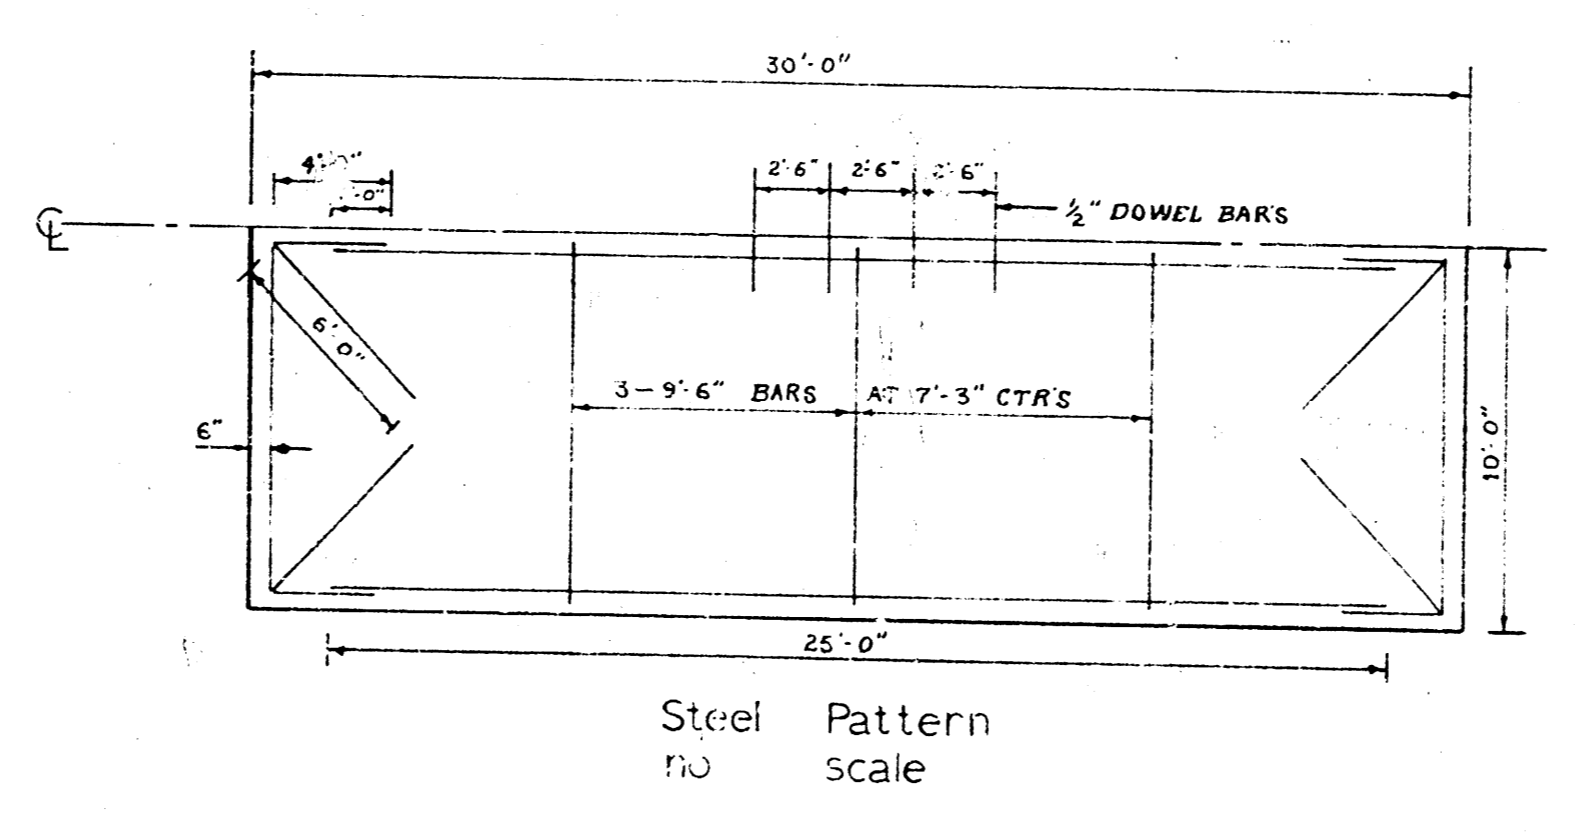

**ALLEY NORTH OF CENTRAL**  
 East Line Woodlawn Blvd to East Line Alley East of Woodlawn Blvd.  
**20'-7" CONC - PAVEMENT**  
 B.E. SMITH City Engineer  
 CITY OF Wichita, Kansas  
 DATE: \_\_\_\_\_ Private Project