


ALLEY- between Topoka & Emporia.

Waterman to English

Concrete- 7"

B.M. Elev. 108.38 "K" in Keeler N.S. Waterman & S. Alley Lot Topoka & Emporia.

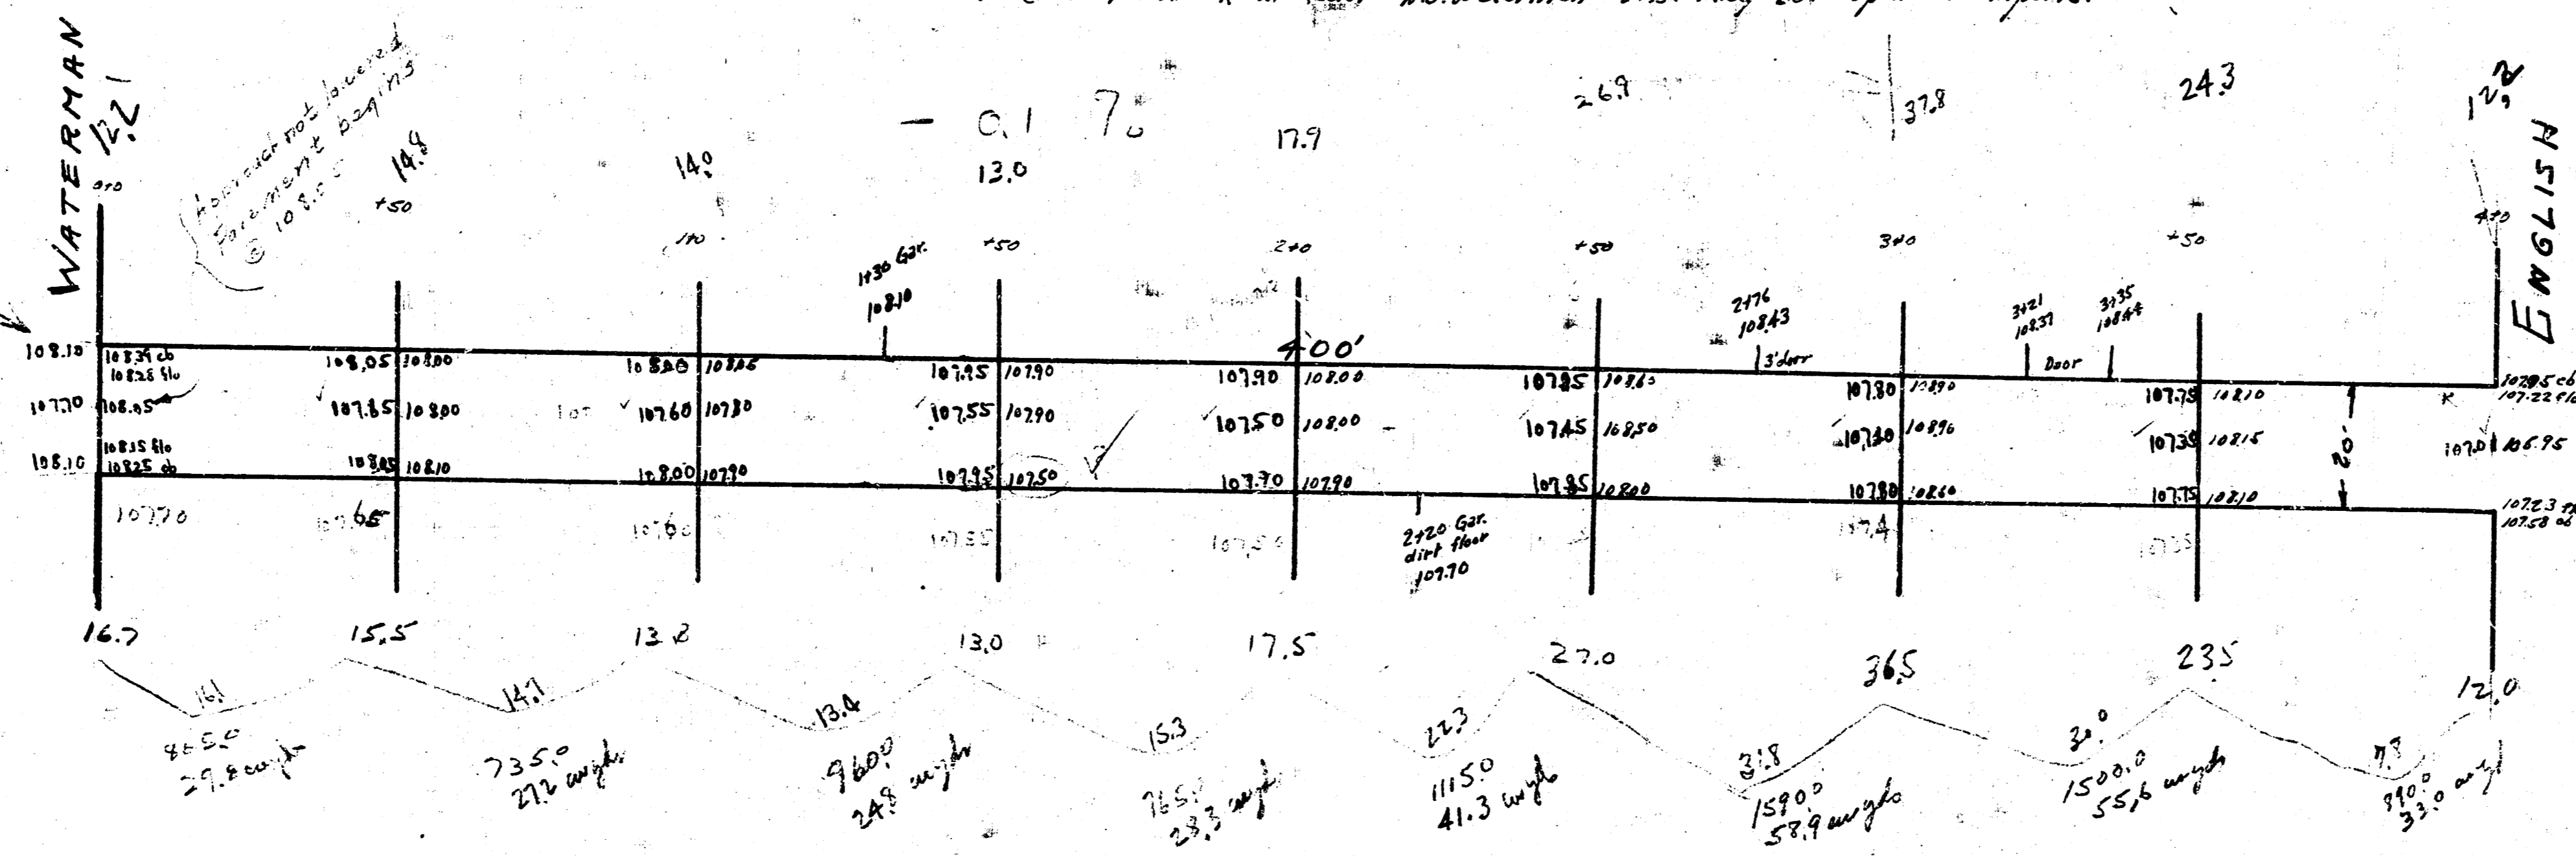

Length = 277.9
+ 17.2 = 295.1
322.8 w/gl