

PAVING PLAN 1944

ALLEY BETWEEN TOPEKA & EMPORIA
N.L. 20TH ST. TO S.L. 21ST ST


20' CONCRETE

Eq. 24" in Topeka - 118.04
118.17

120.4
119.2
1.2

119.0
118.5
0.5

8. MELEY. 122.97 IRON IN THIMBLE N.S. 20TH
W.S. ALLEY

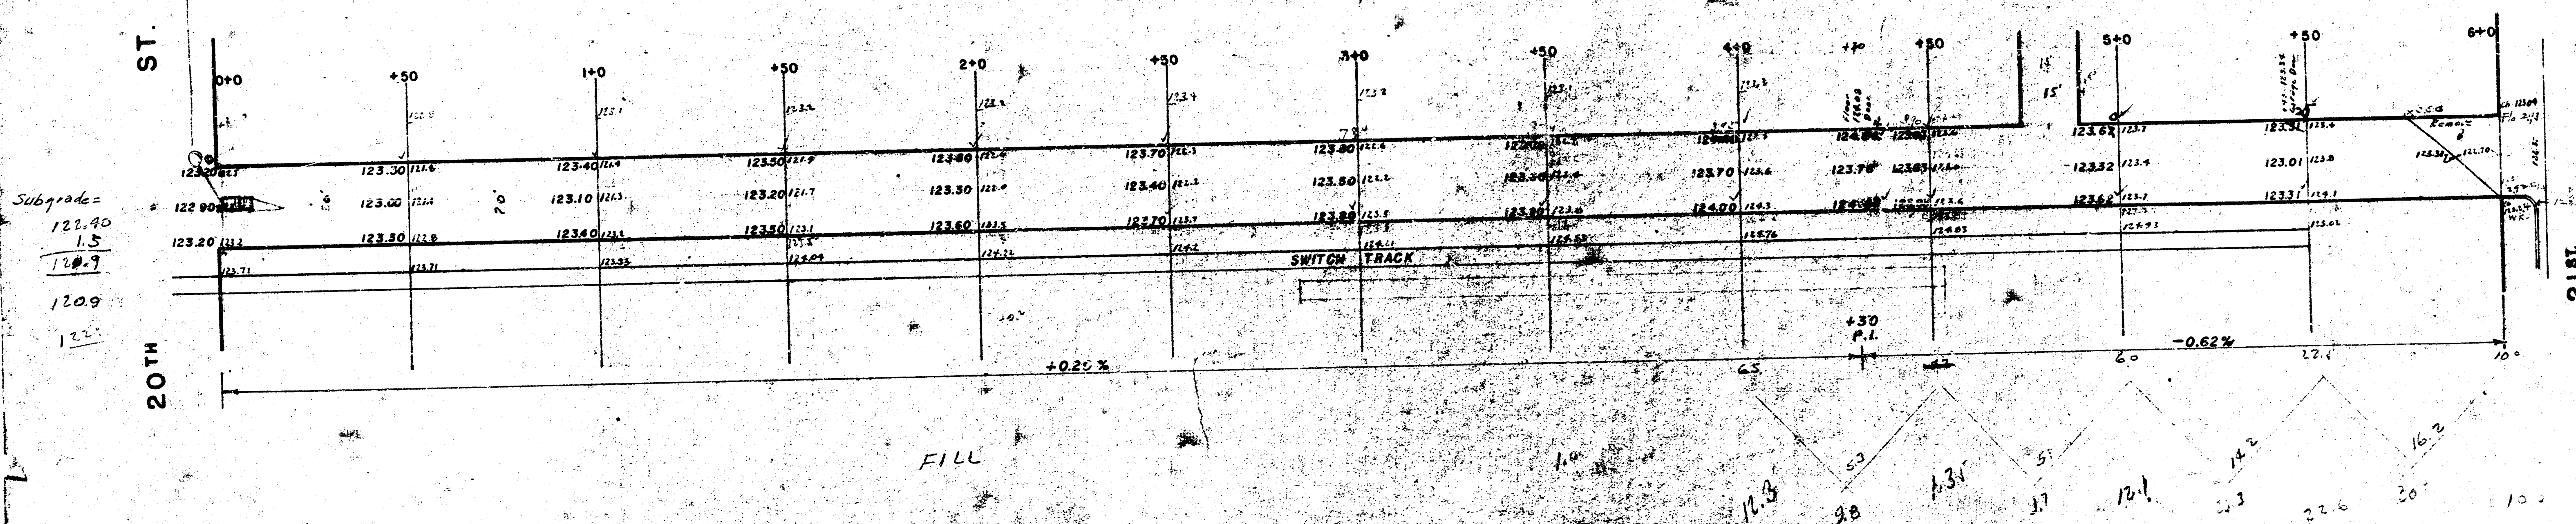

Subgrade =
122.90
1.5
120.9
1.2

Post - 122.97
122.97
122.97

