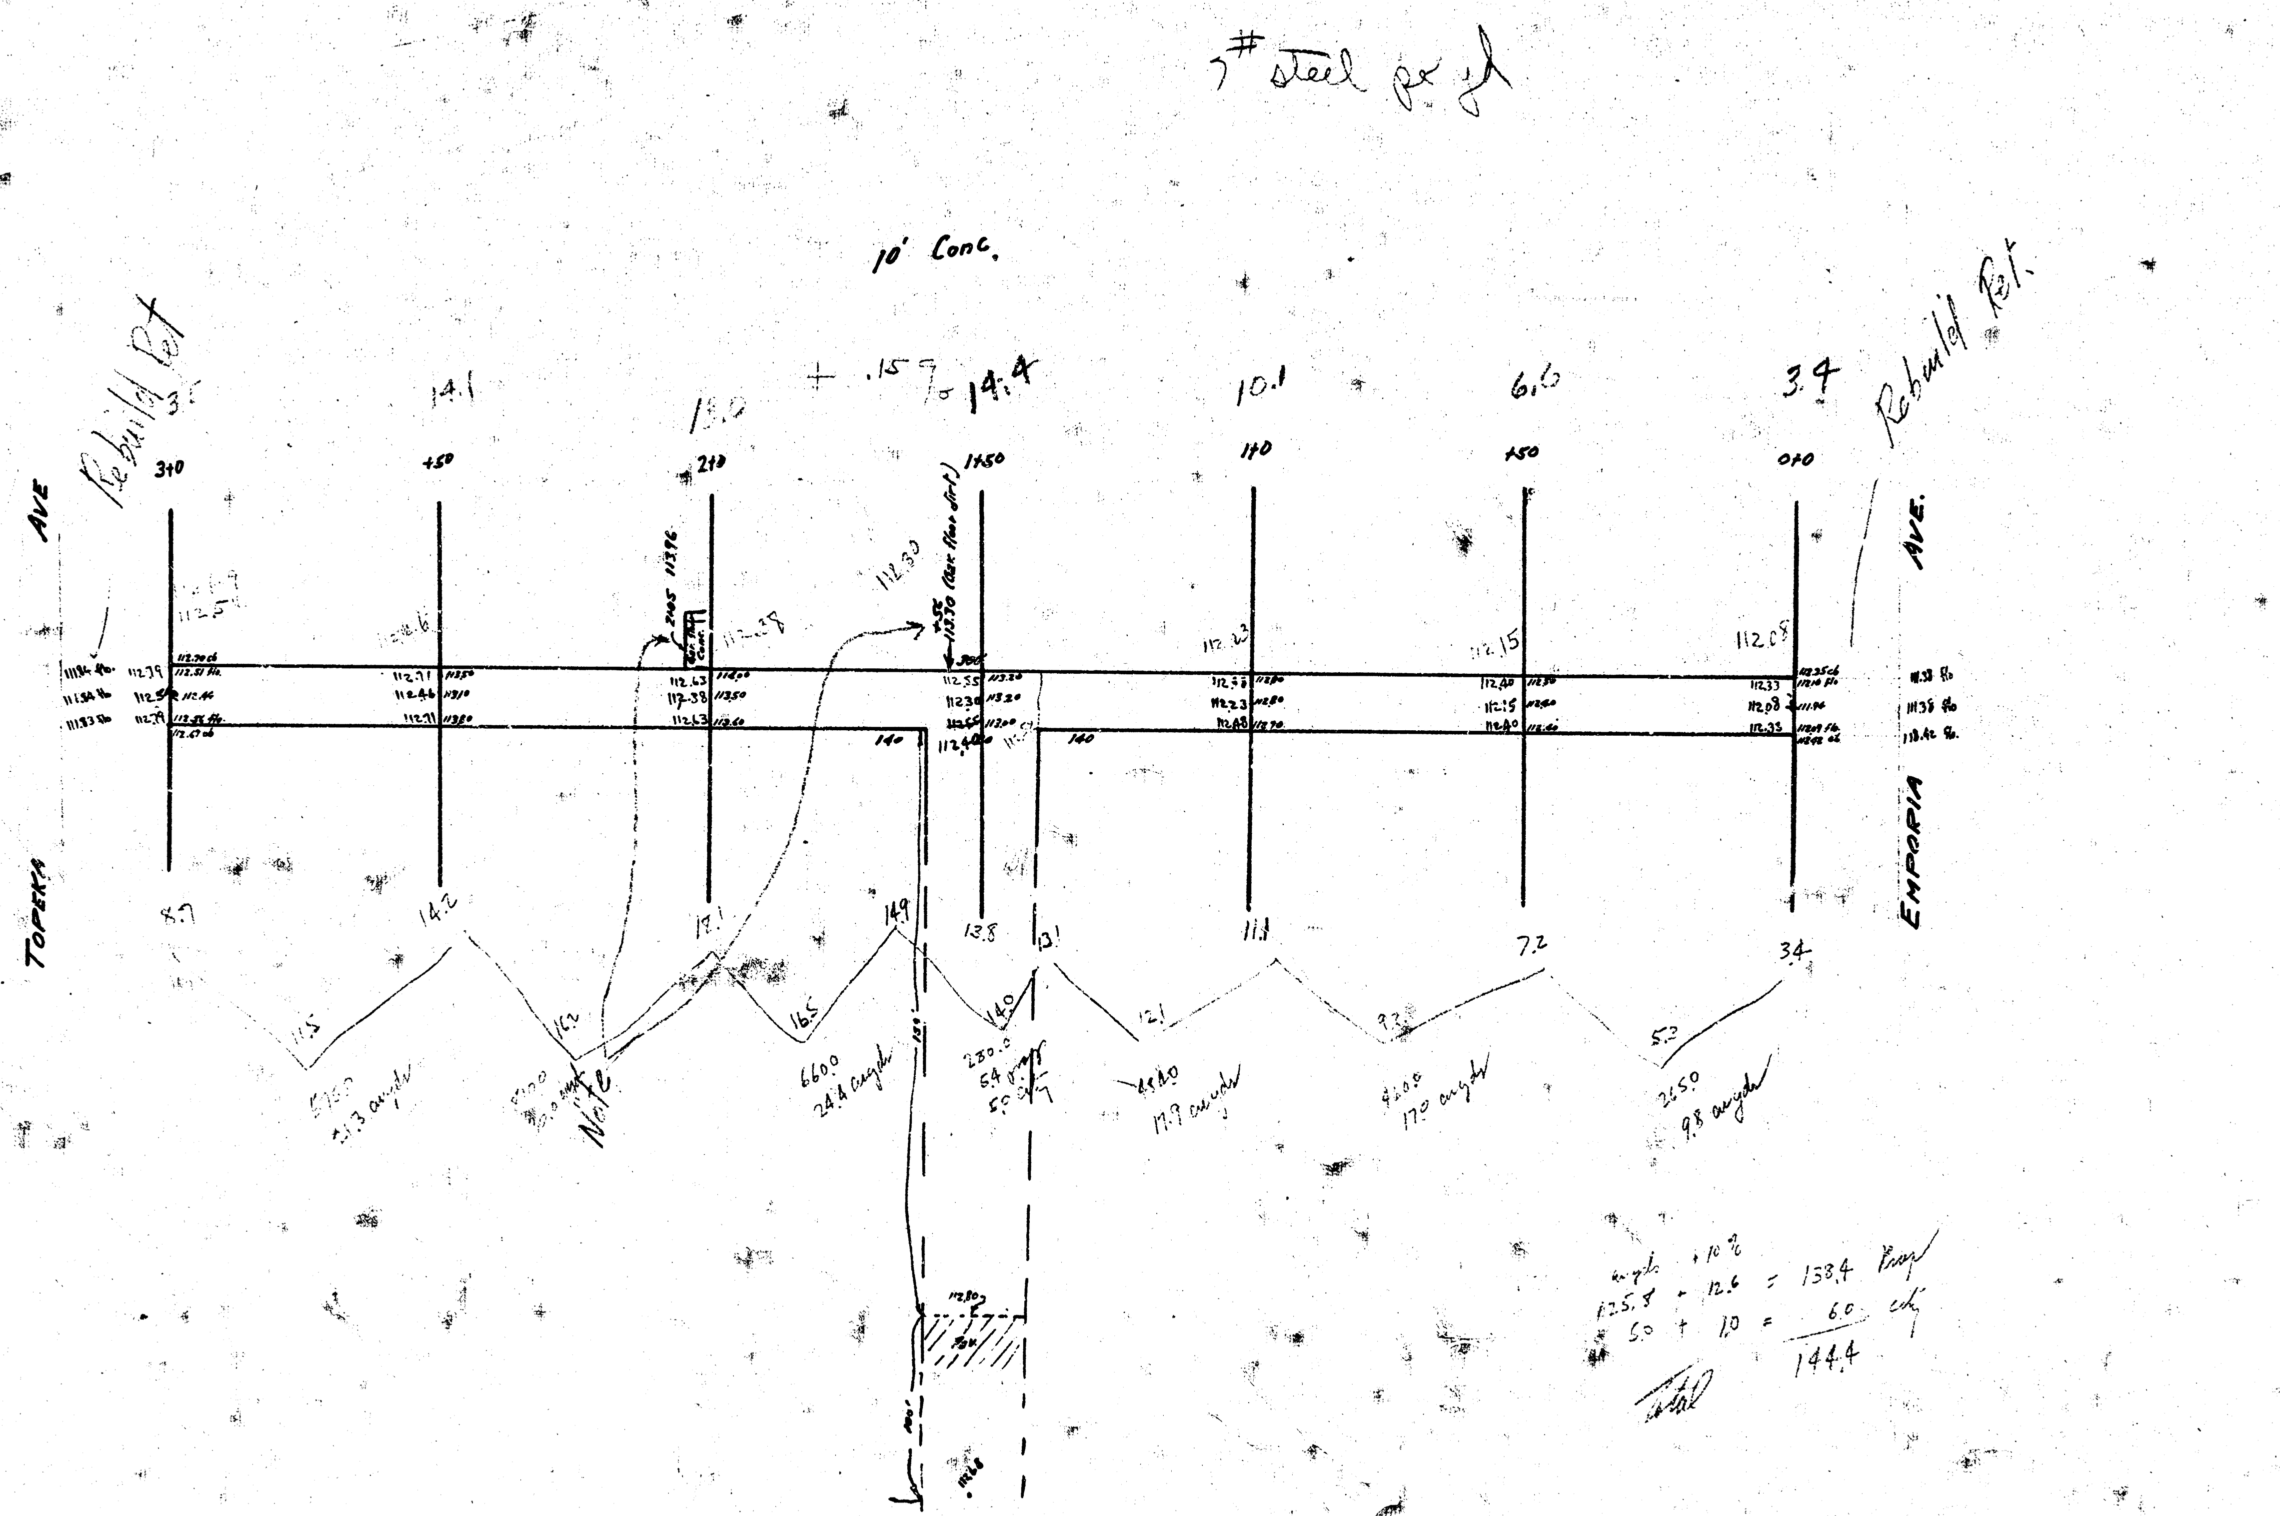B.M. Elev. 113.25 "8" bolt c wk E. SE. cor. Central & St. Francis
112.01 "X" on S. Lug Alley S. of Central E. of Emporia