


Book 53 Page 16

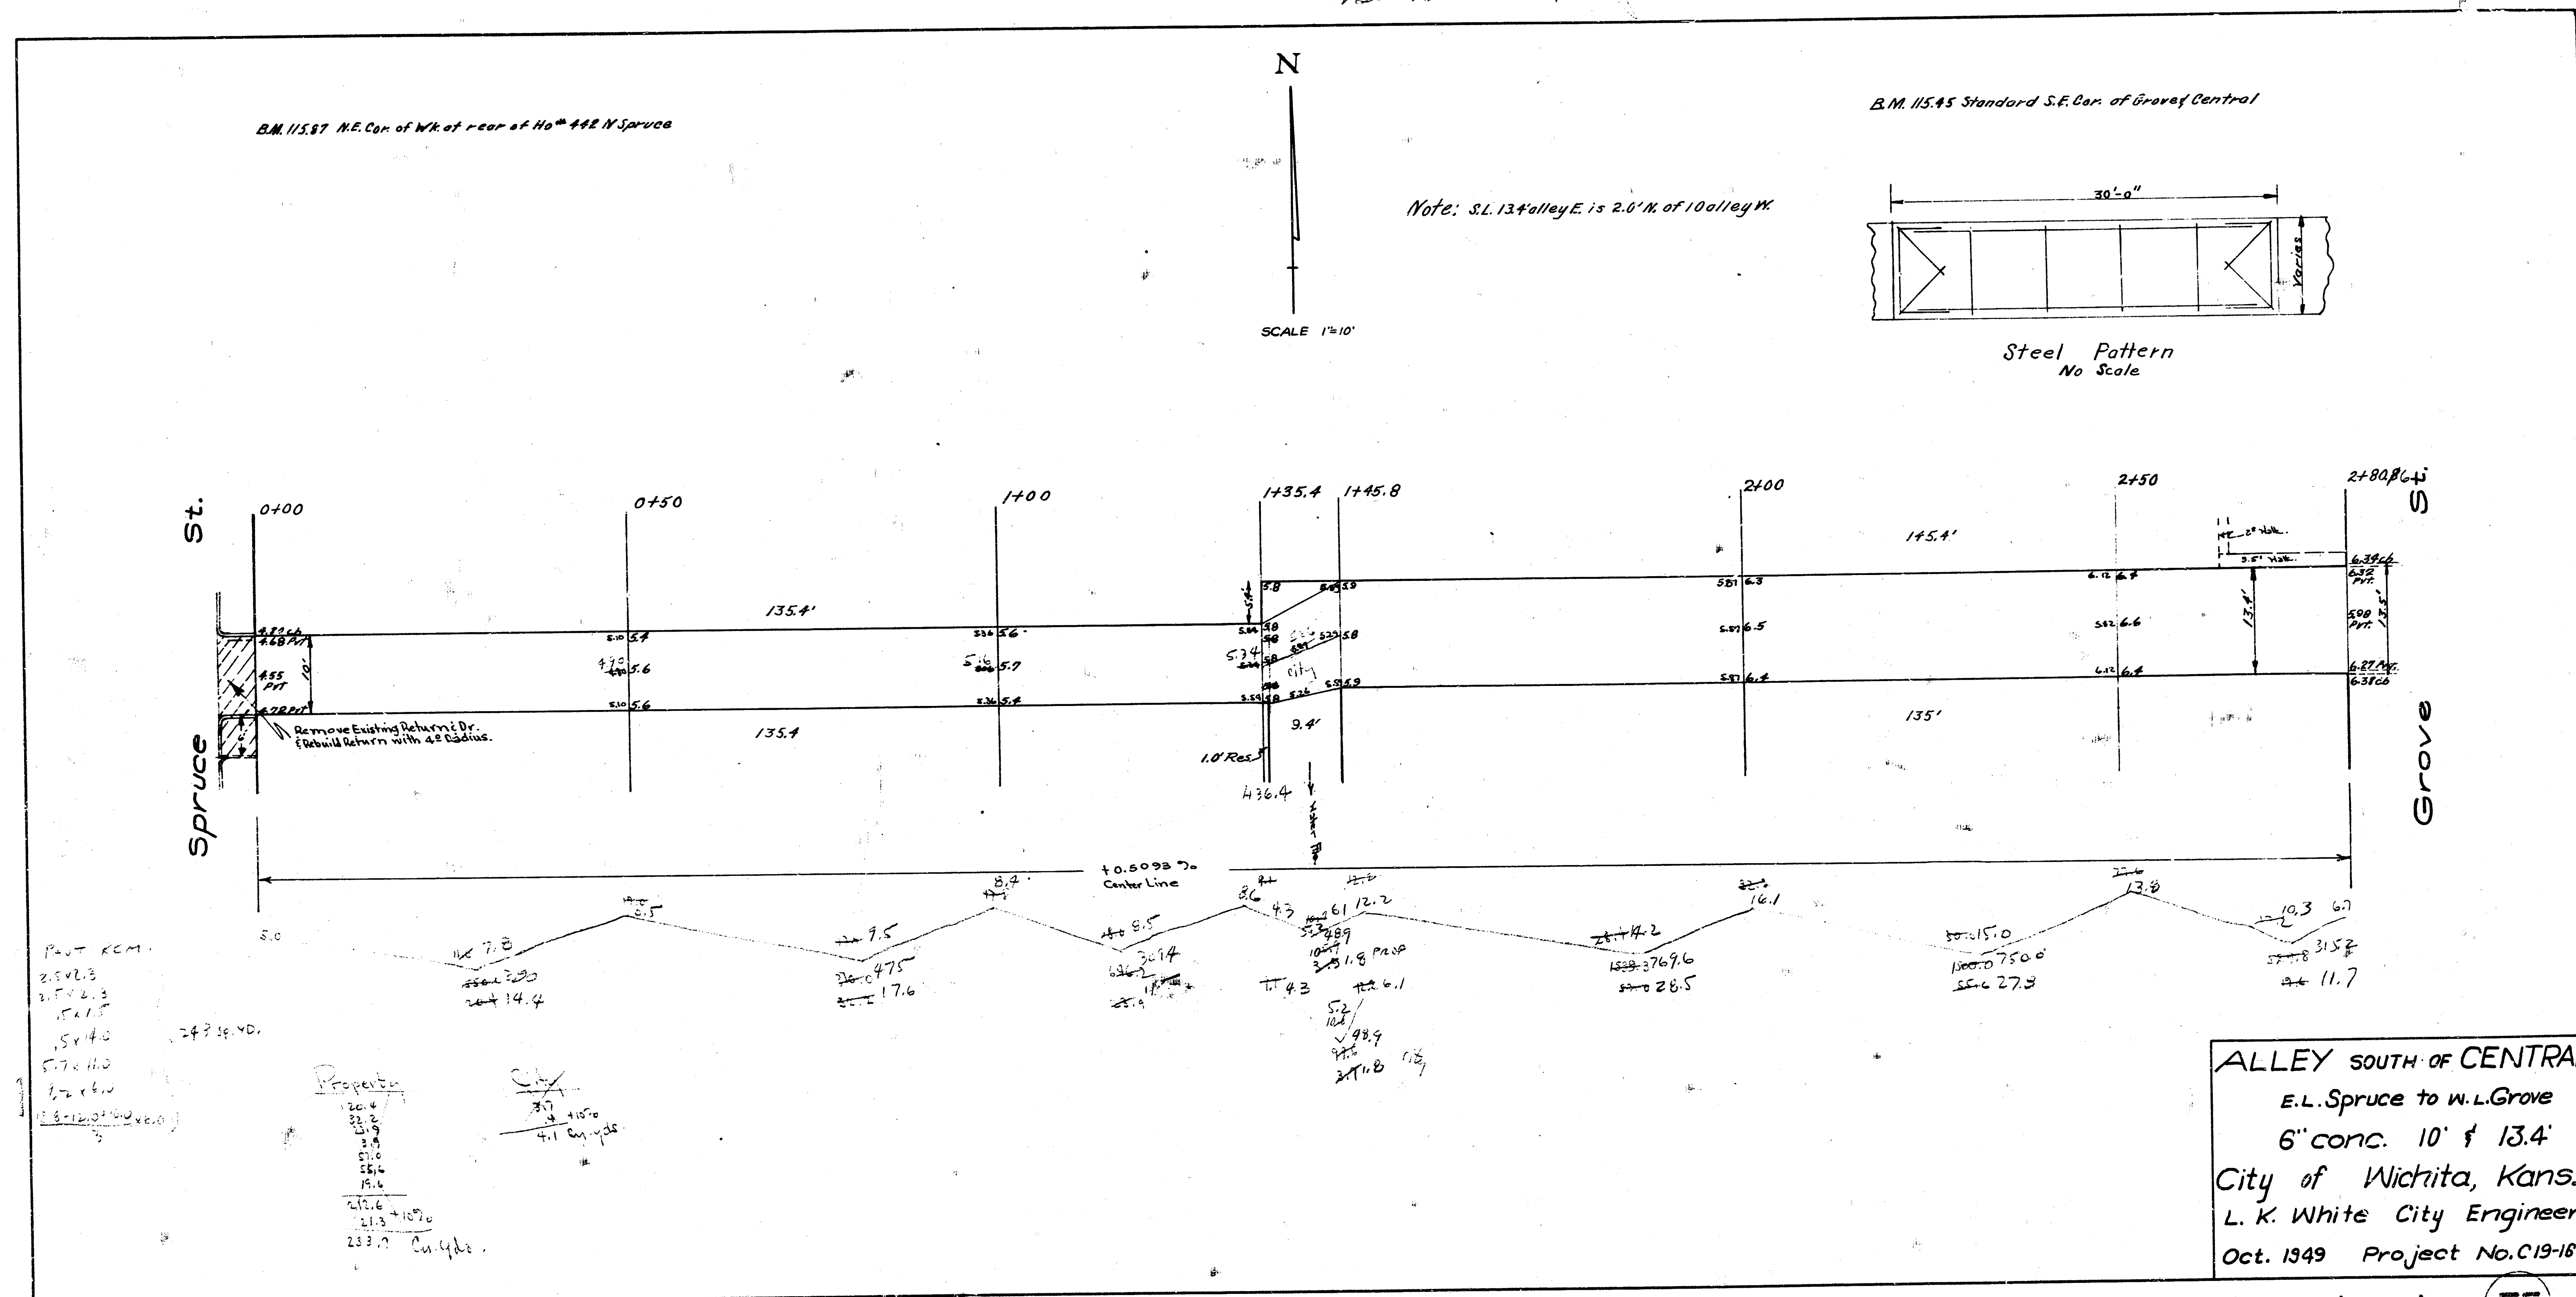

4 4 4 55