
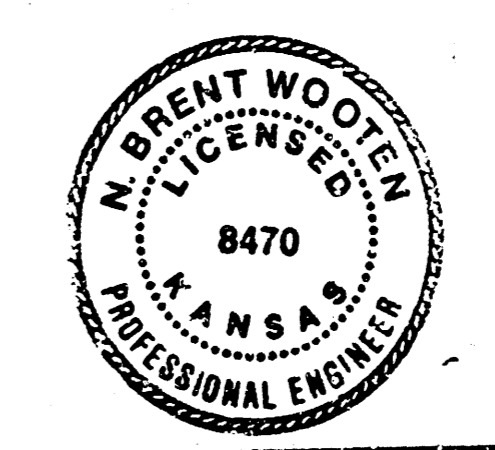


12-8-83
 APPROVED AS NOTED
 By CITY ENGINEER OF WICHITA
 Sanitary Sewers
 Storm Sewers
 Alley Pavement P.E.
 Driveway Approaches

Note:
 Construction of alley pavement shall include wire mesh reinforcing w. contraction joints every 20'. No subgrade treatment shall be required for the alley R/W. See detail sections.
 [] - indicates Removal

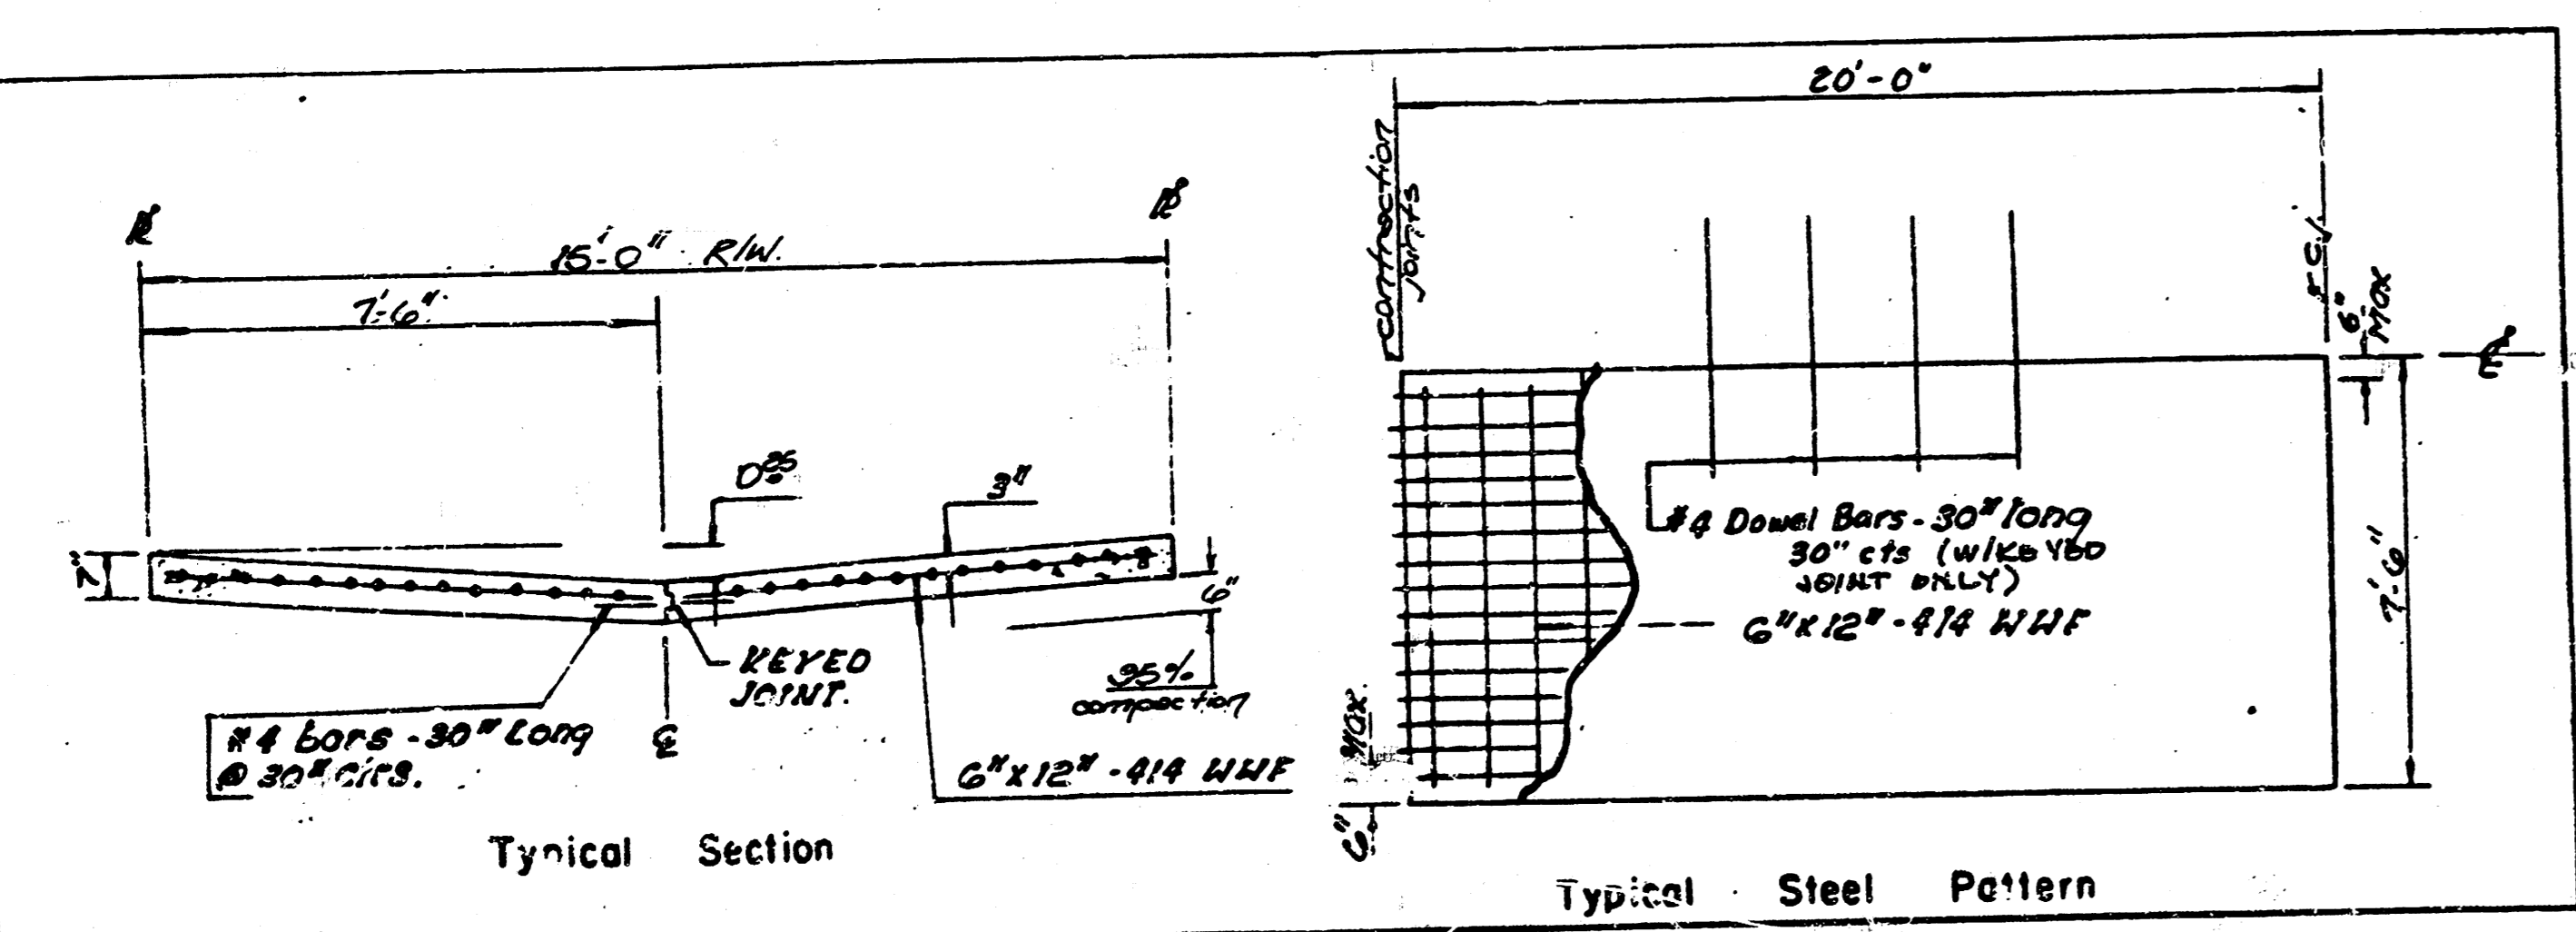

ALLEY PAVEMENT PROJECT FOR THE ALLEY
 NORTH OF 2ND STREET - 125' WEST OF W.L. SENECA
 TO W.L. SENECA
 CITY OF WICHITA, KANSAS.
 PROJ. NO. 472-76-245-80000-000-000-008

BAUGHMAN COMPANY, P.A.
 SURVEYING & ENGINEERING
 314/243-7271 • 330 LAURA • WICHITA, KANSAS 67211

FILMED FROM THE BEST
 AVAILABLE COPY.....